


RENOVATION PROJECT

FOR
SAINT EDMUND'S
EPISCOPAL CHURCH

EPISCOPAL CHURCH
11775 SAN GABRIEL BLVD., SAN MARINO, CA., 91108-8048

STAMPS

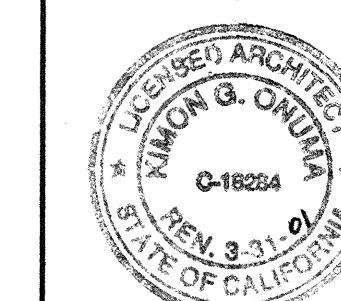

REVISIONS

DESCRIPTION	DATE	BY
PLAN CHECK 		

PROJECT NUMBER		
----------------	--	--

SCALE AS NOTED

PRINTED	11/16/0
---------	---------

TITLE	11/16/0
-------	---------


Journal of Management Education 30(6)

DEMO PLAN


SHEET

A-2

5 OF 44

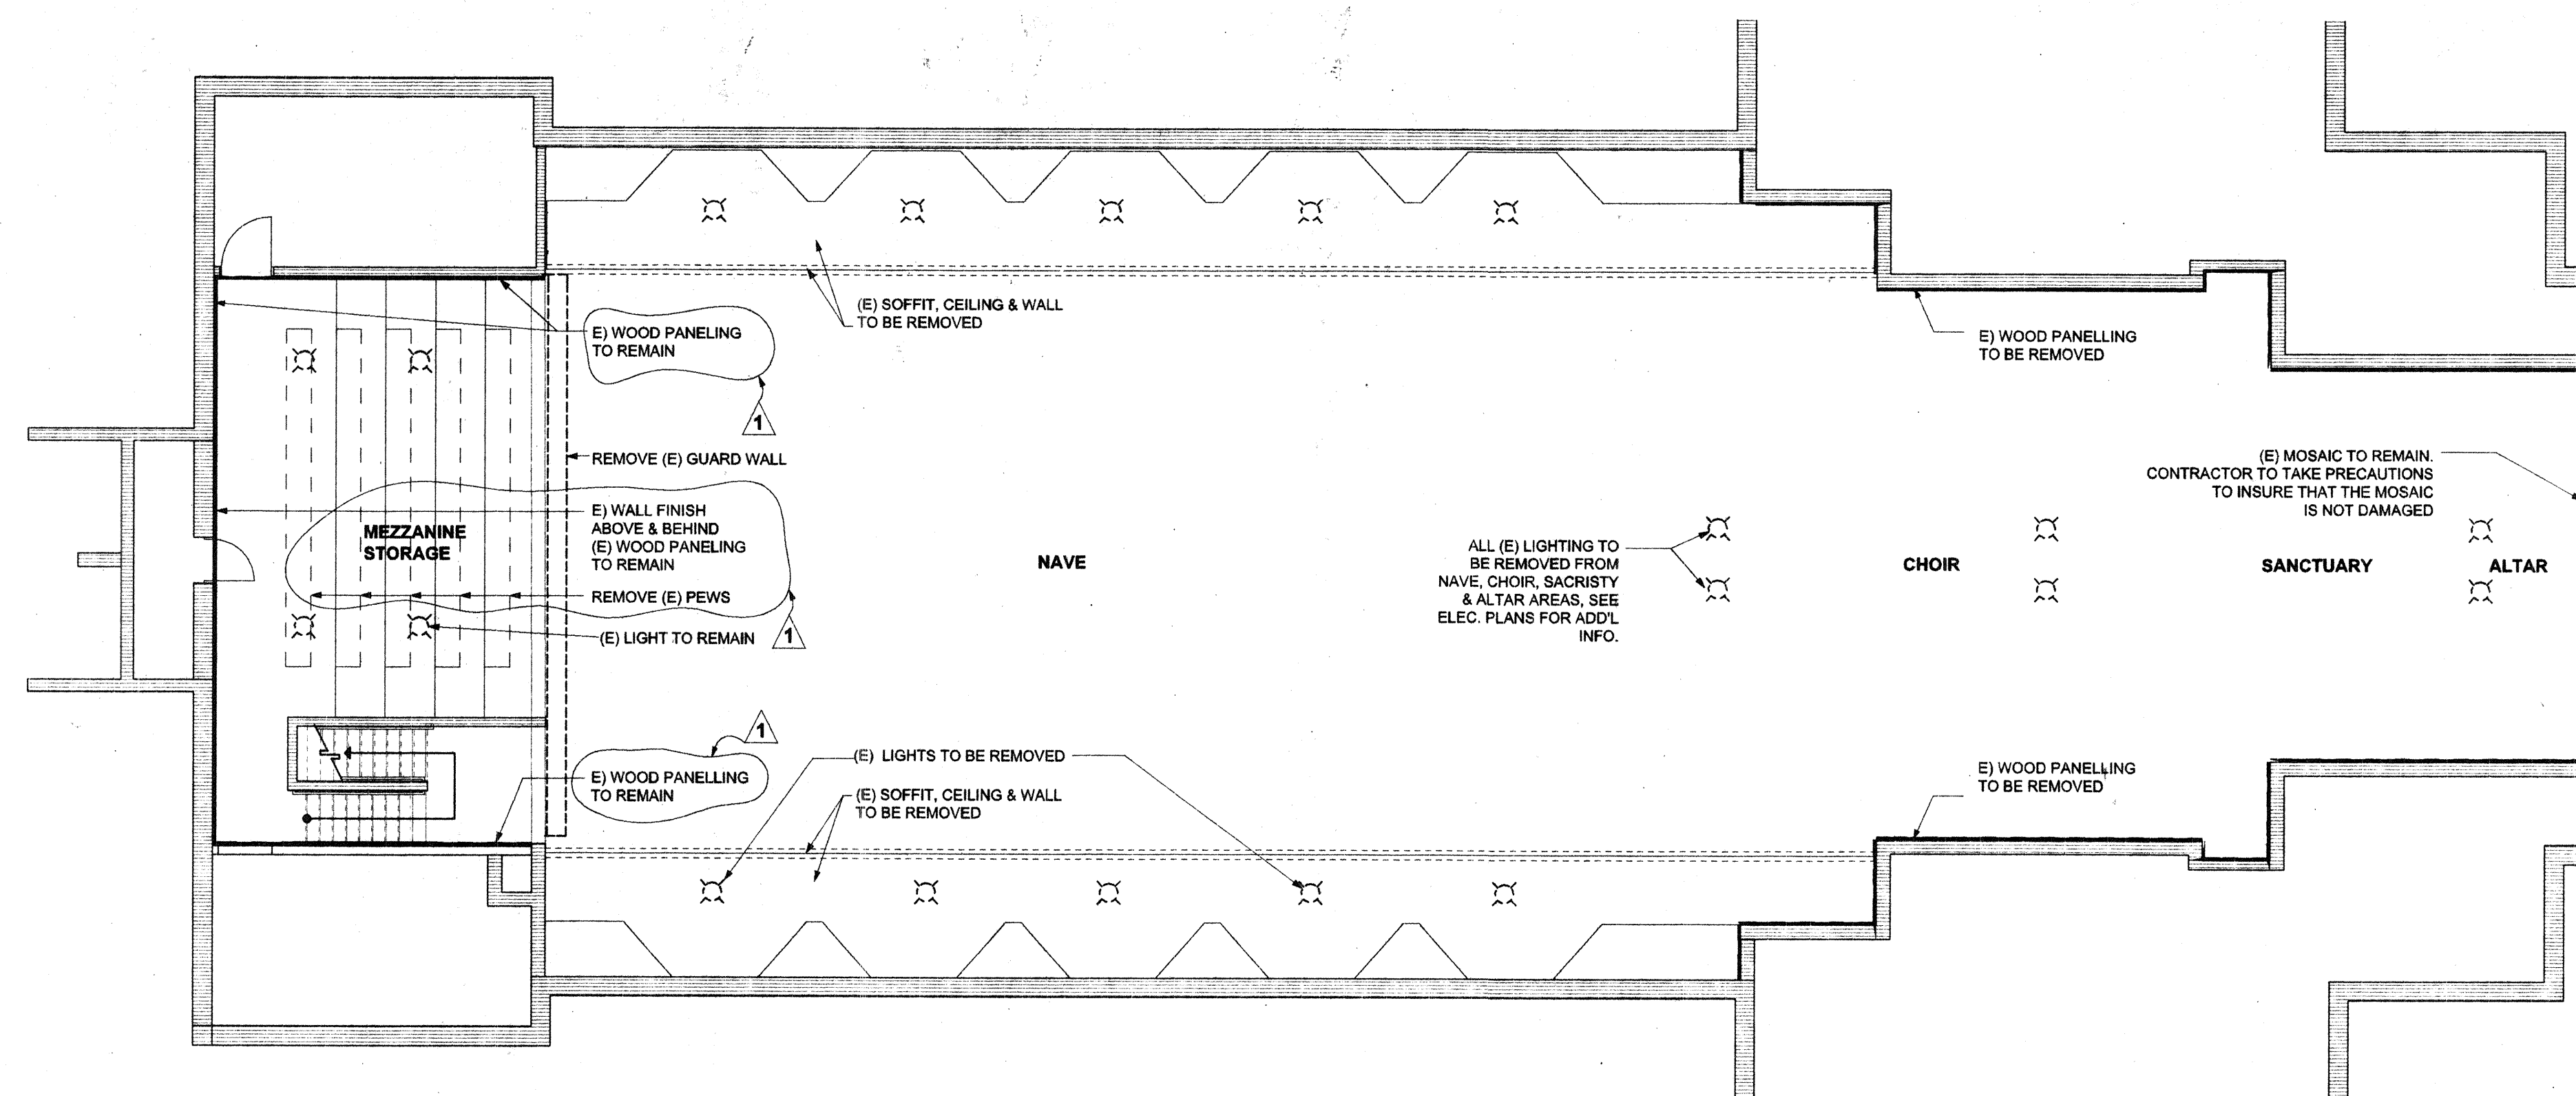

2 2nd FLOOR DEMOLITION PLAN

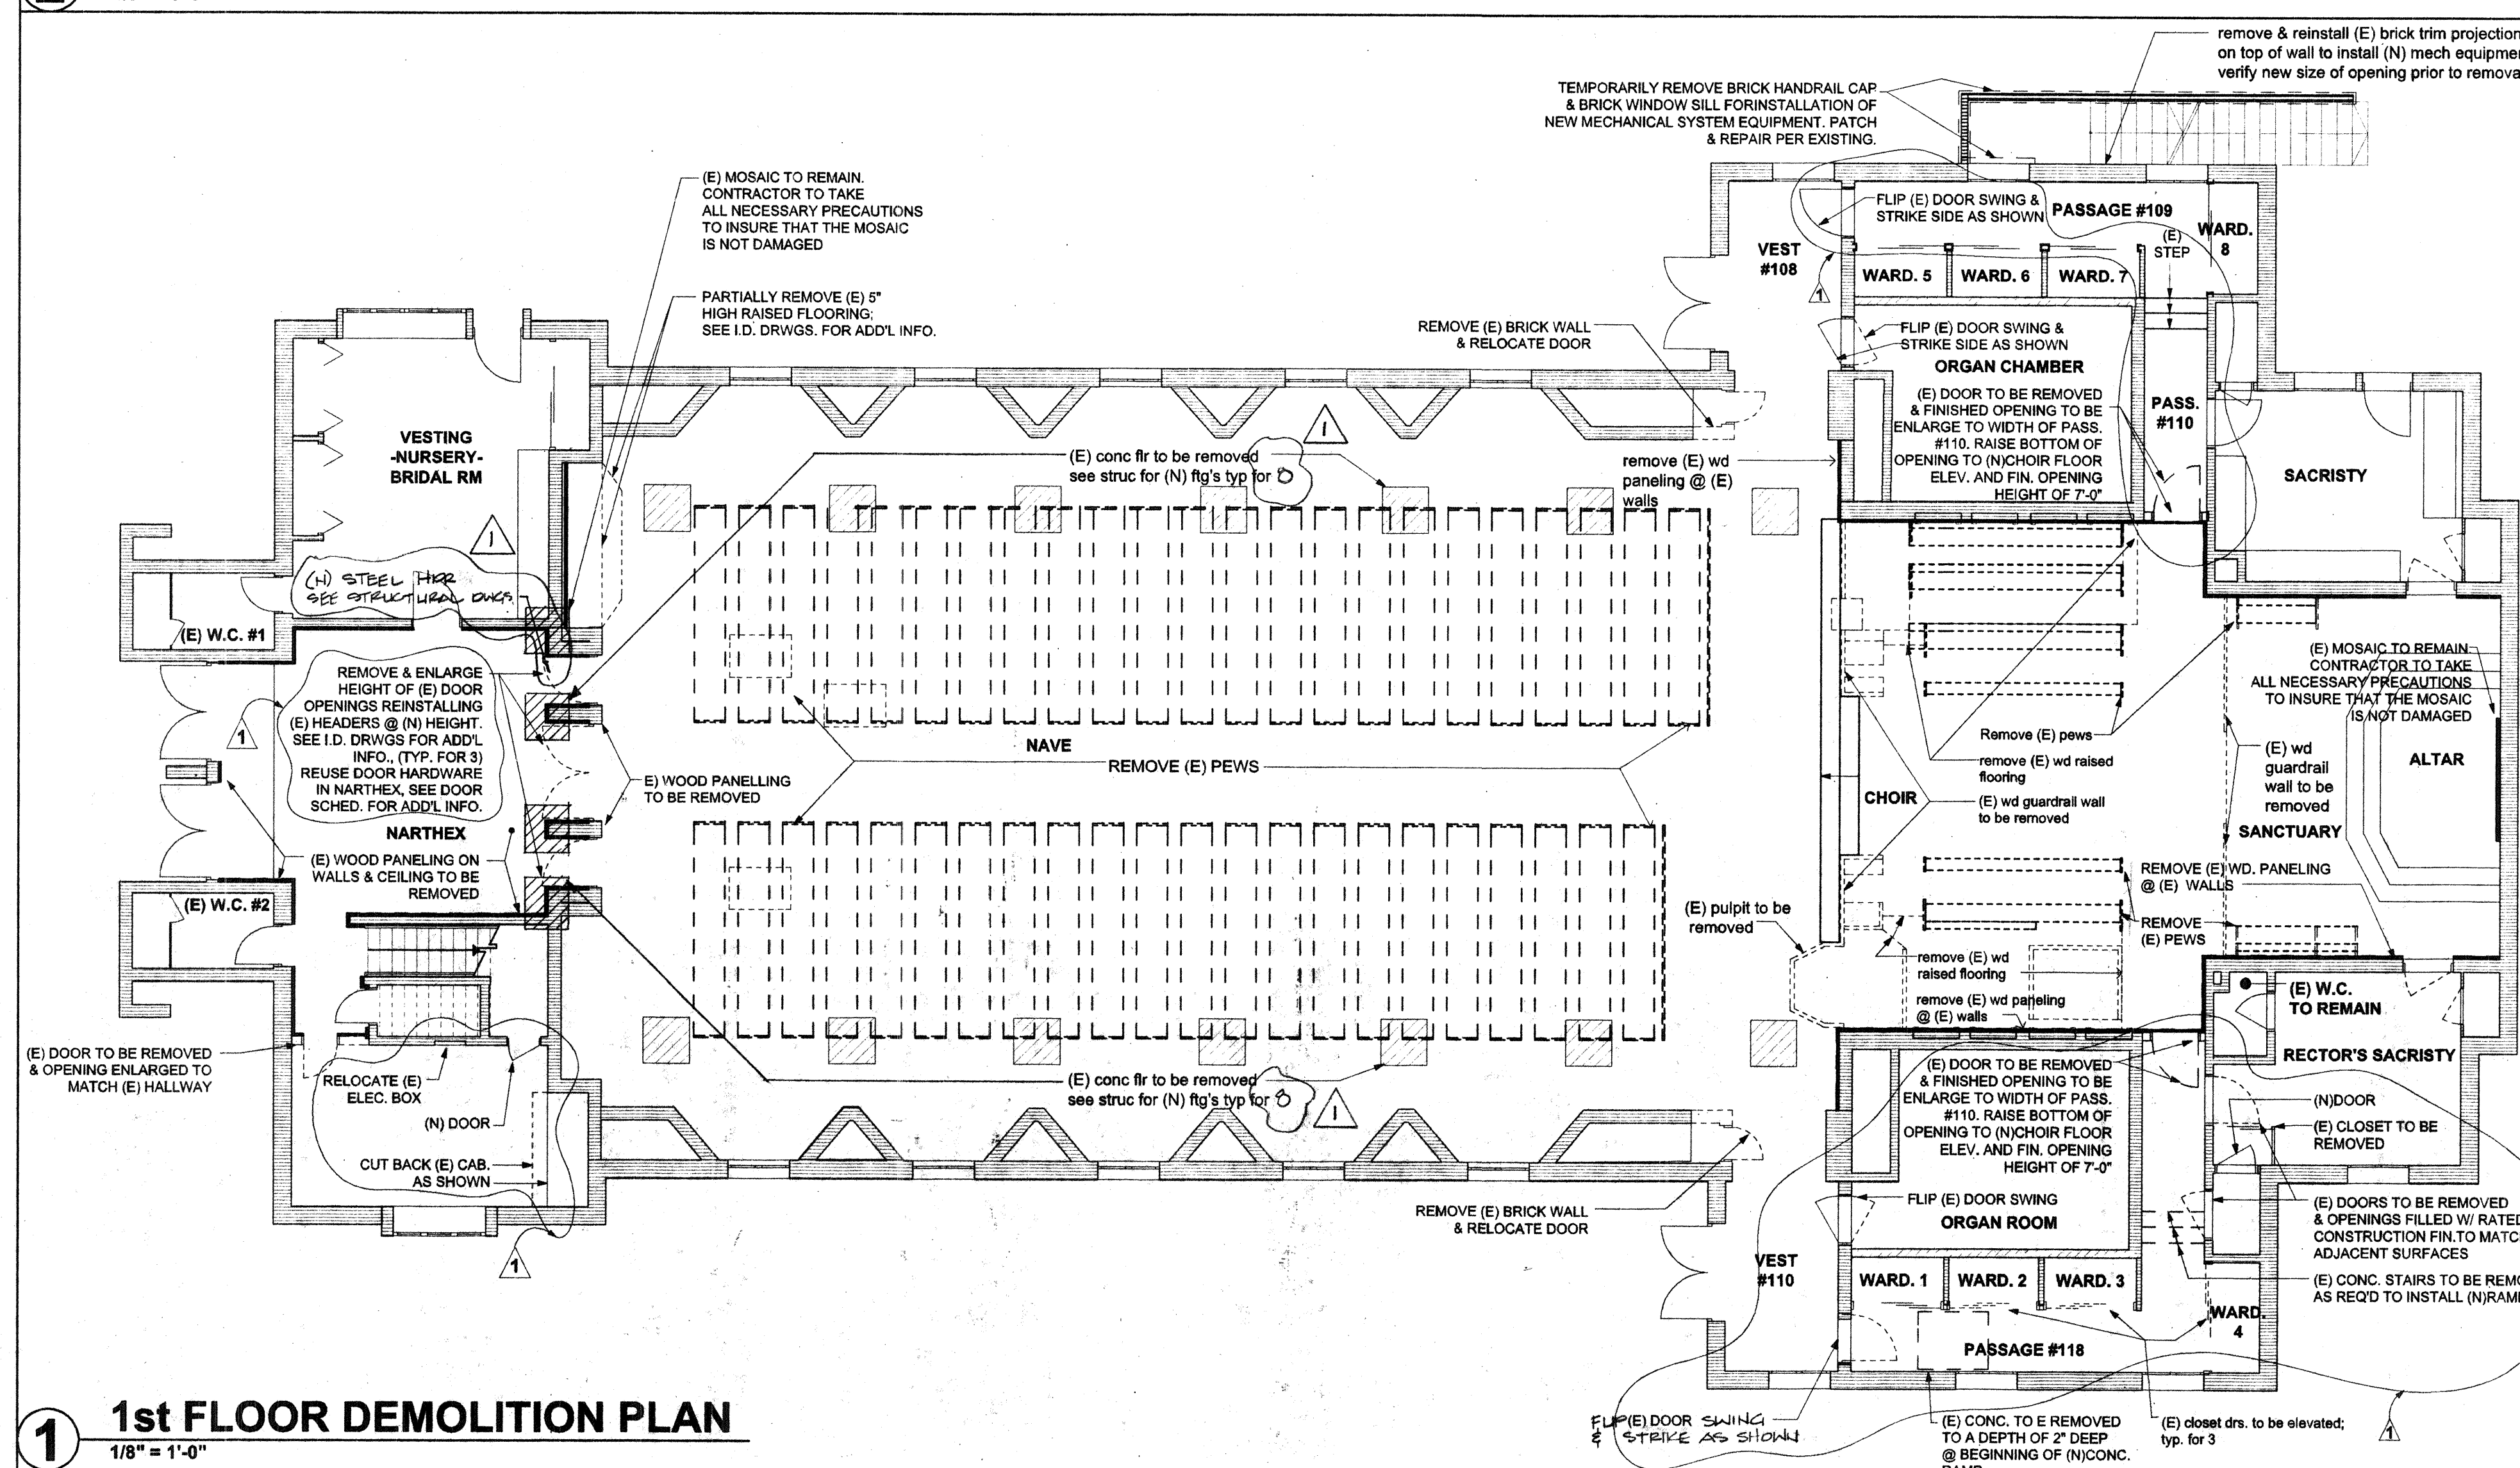

1 1st FLOOR DEMOLITION PLAN
1/8" = 1'-0"