

Onuma & Associates
 Architecture, Planning, Consulting
 511 Mission Street
 South Pasadena, CA 91030
 tel 626.799.9920
 fax 626.799.8260
 e-mail: info@onuma.com

Consultants

RENOVATION PROJECT
 FOR
SAINT EDMUND'S
EPISCOPAL CHURCH
 1175 SAN GABRIEL BLVD., SAN MARINO, CA., 91108-8048

STAMPS



REVISIONS

DESCRIPTION	DATE	BY
PLAN CHECK		

PROJECT NUMBER
2000

SCALE
AS NOTED


PRINTED
11/16/00

TITLE
BUILDING SECTIONS


SHEET

A-5

8 OF 44

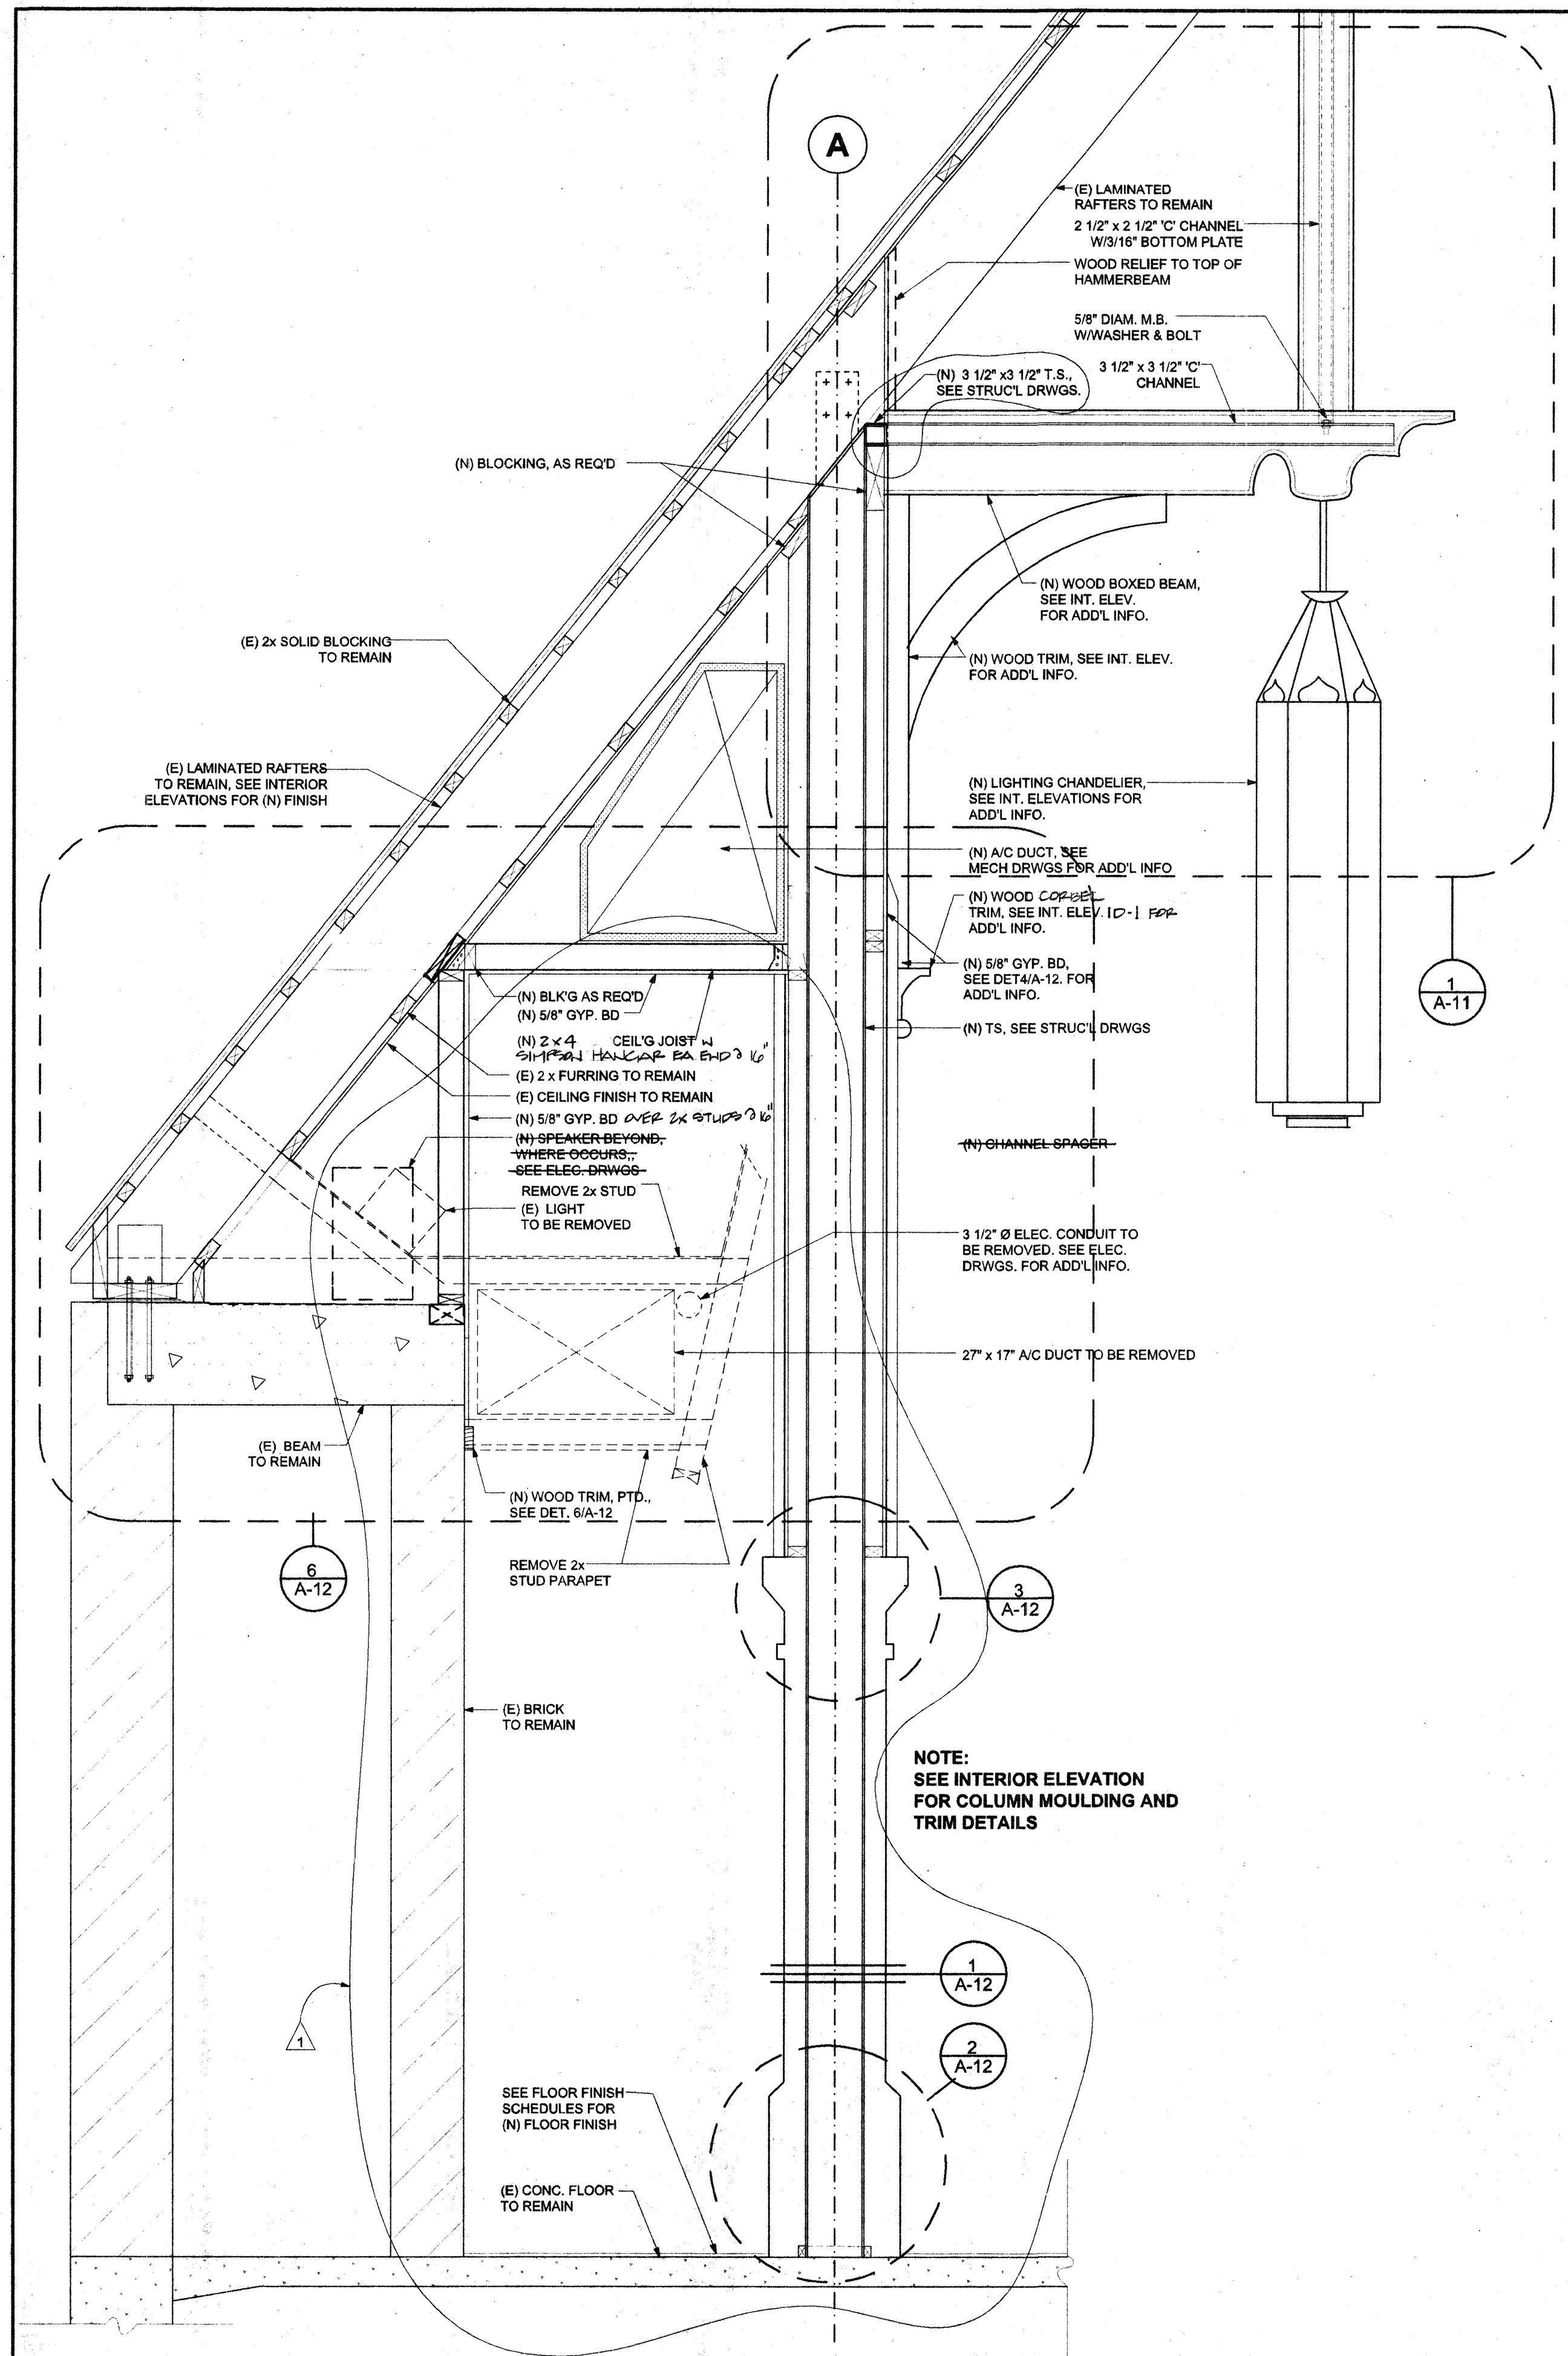

2 SECTION
 3/4" = 1'-0"

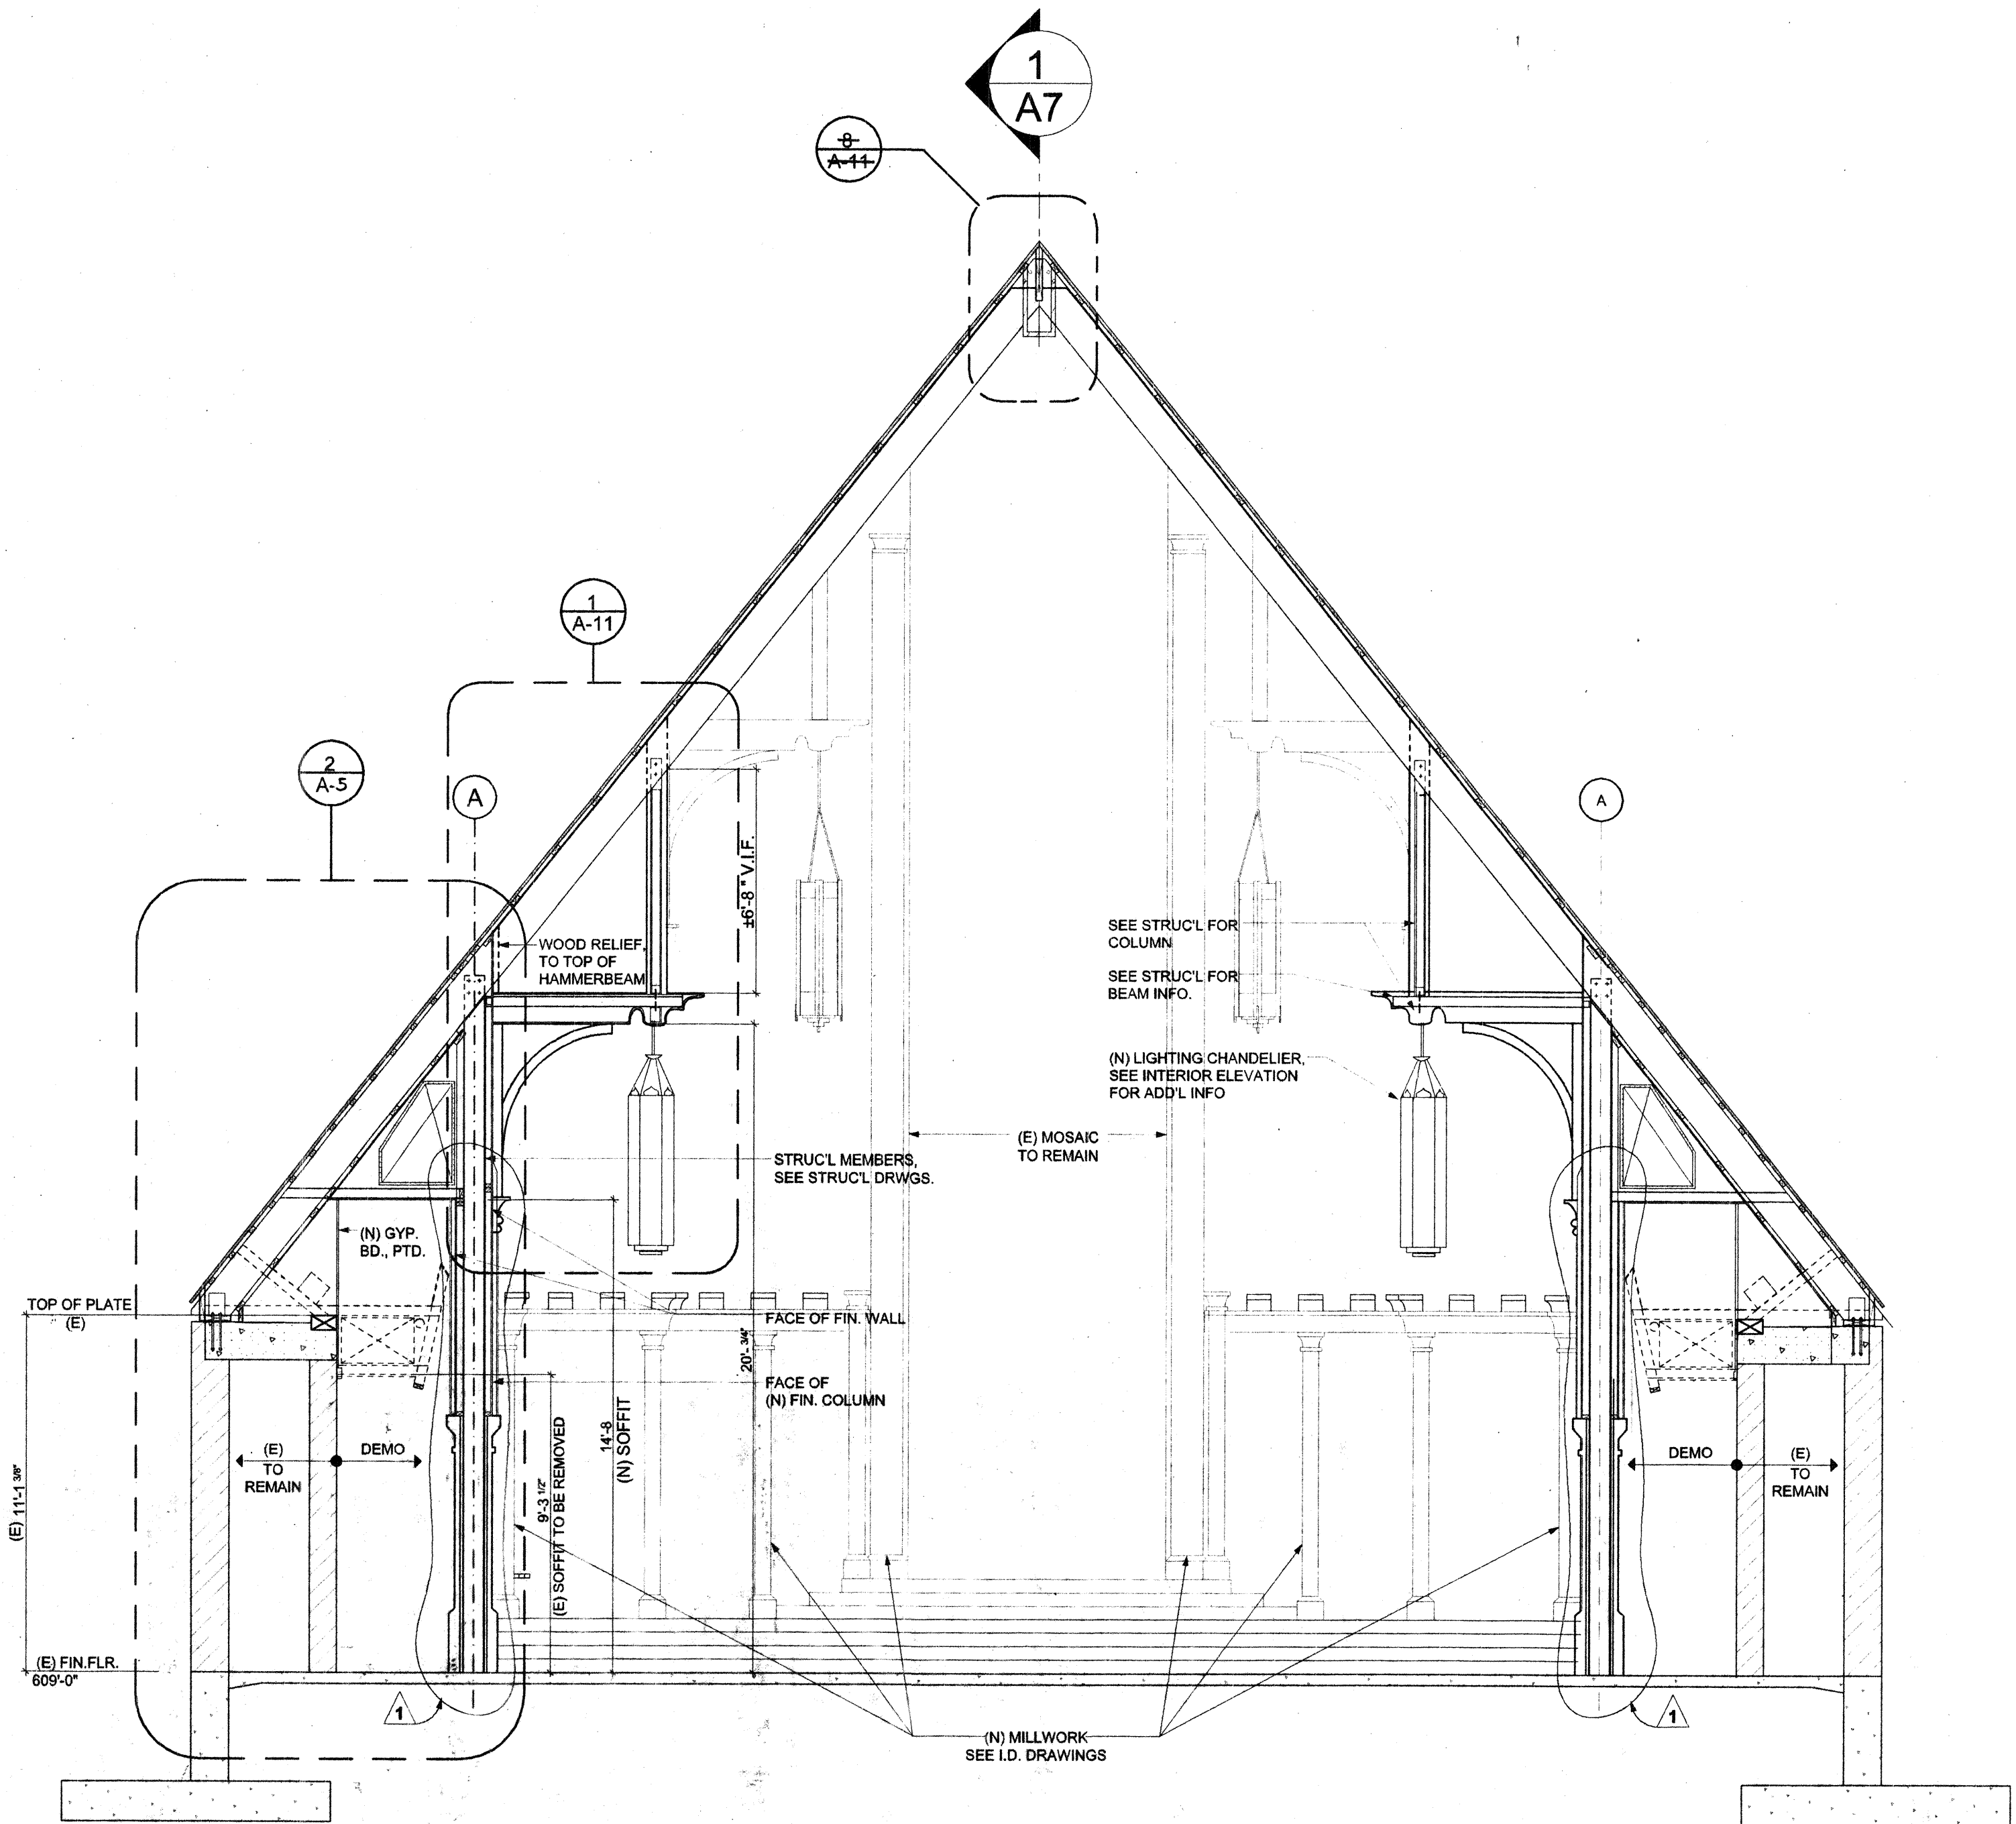

1 SECTION
 1/4" = 1'-0"