

Onuma & Associates


Architecture, Planning, Consulting
511 Mission Street
South Pasadena, CA 91030
tel 626. 799. 9920
fax 626. 799. 8260
e-mail: info@onuma.com

Consultants

**RENOVATION PROJECT
FOR
SAINT EDMUND'S
EPISCOPAL CHURCH**

1175 SAN GABRIEL BLVD., SAN MARINO, CA., 91108-8048

STAMPS

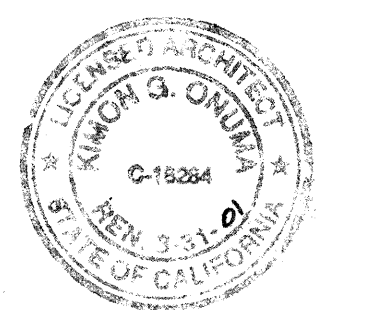

REVISIONS

DESCRIPTION	DATE	BY
PLAN CHECK		

PROJECT NUMBER
2000

SCALE
AS NOTED


PRINTED
11/16/00

TITLE
**BUILDING
SECTIONS**


SHEET

A-6

9 OF 44

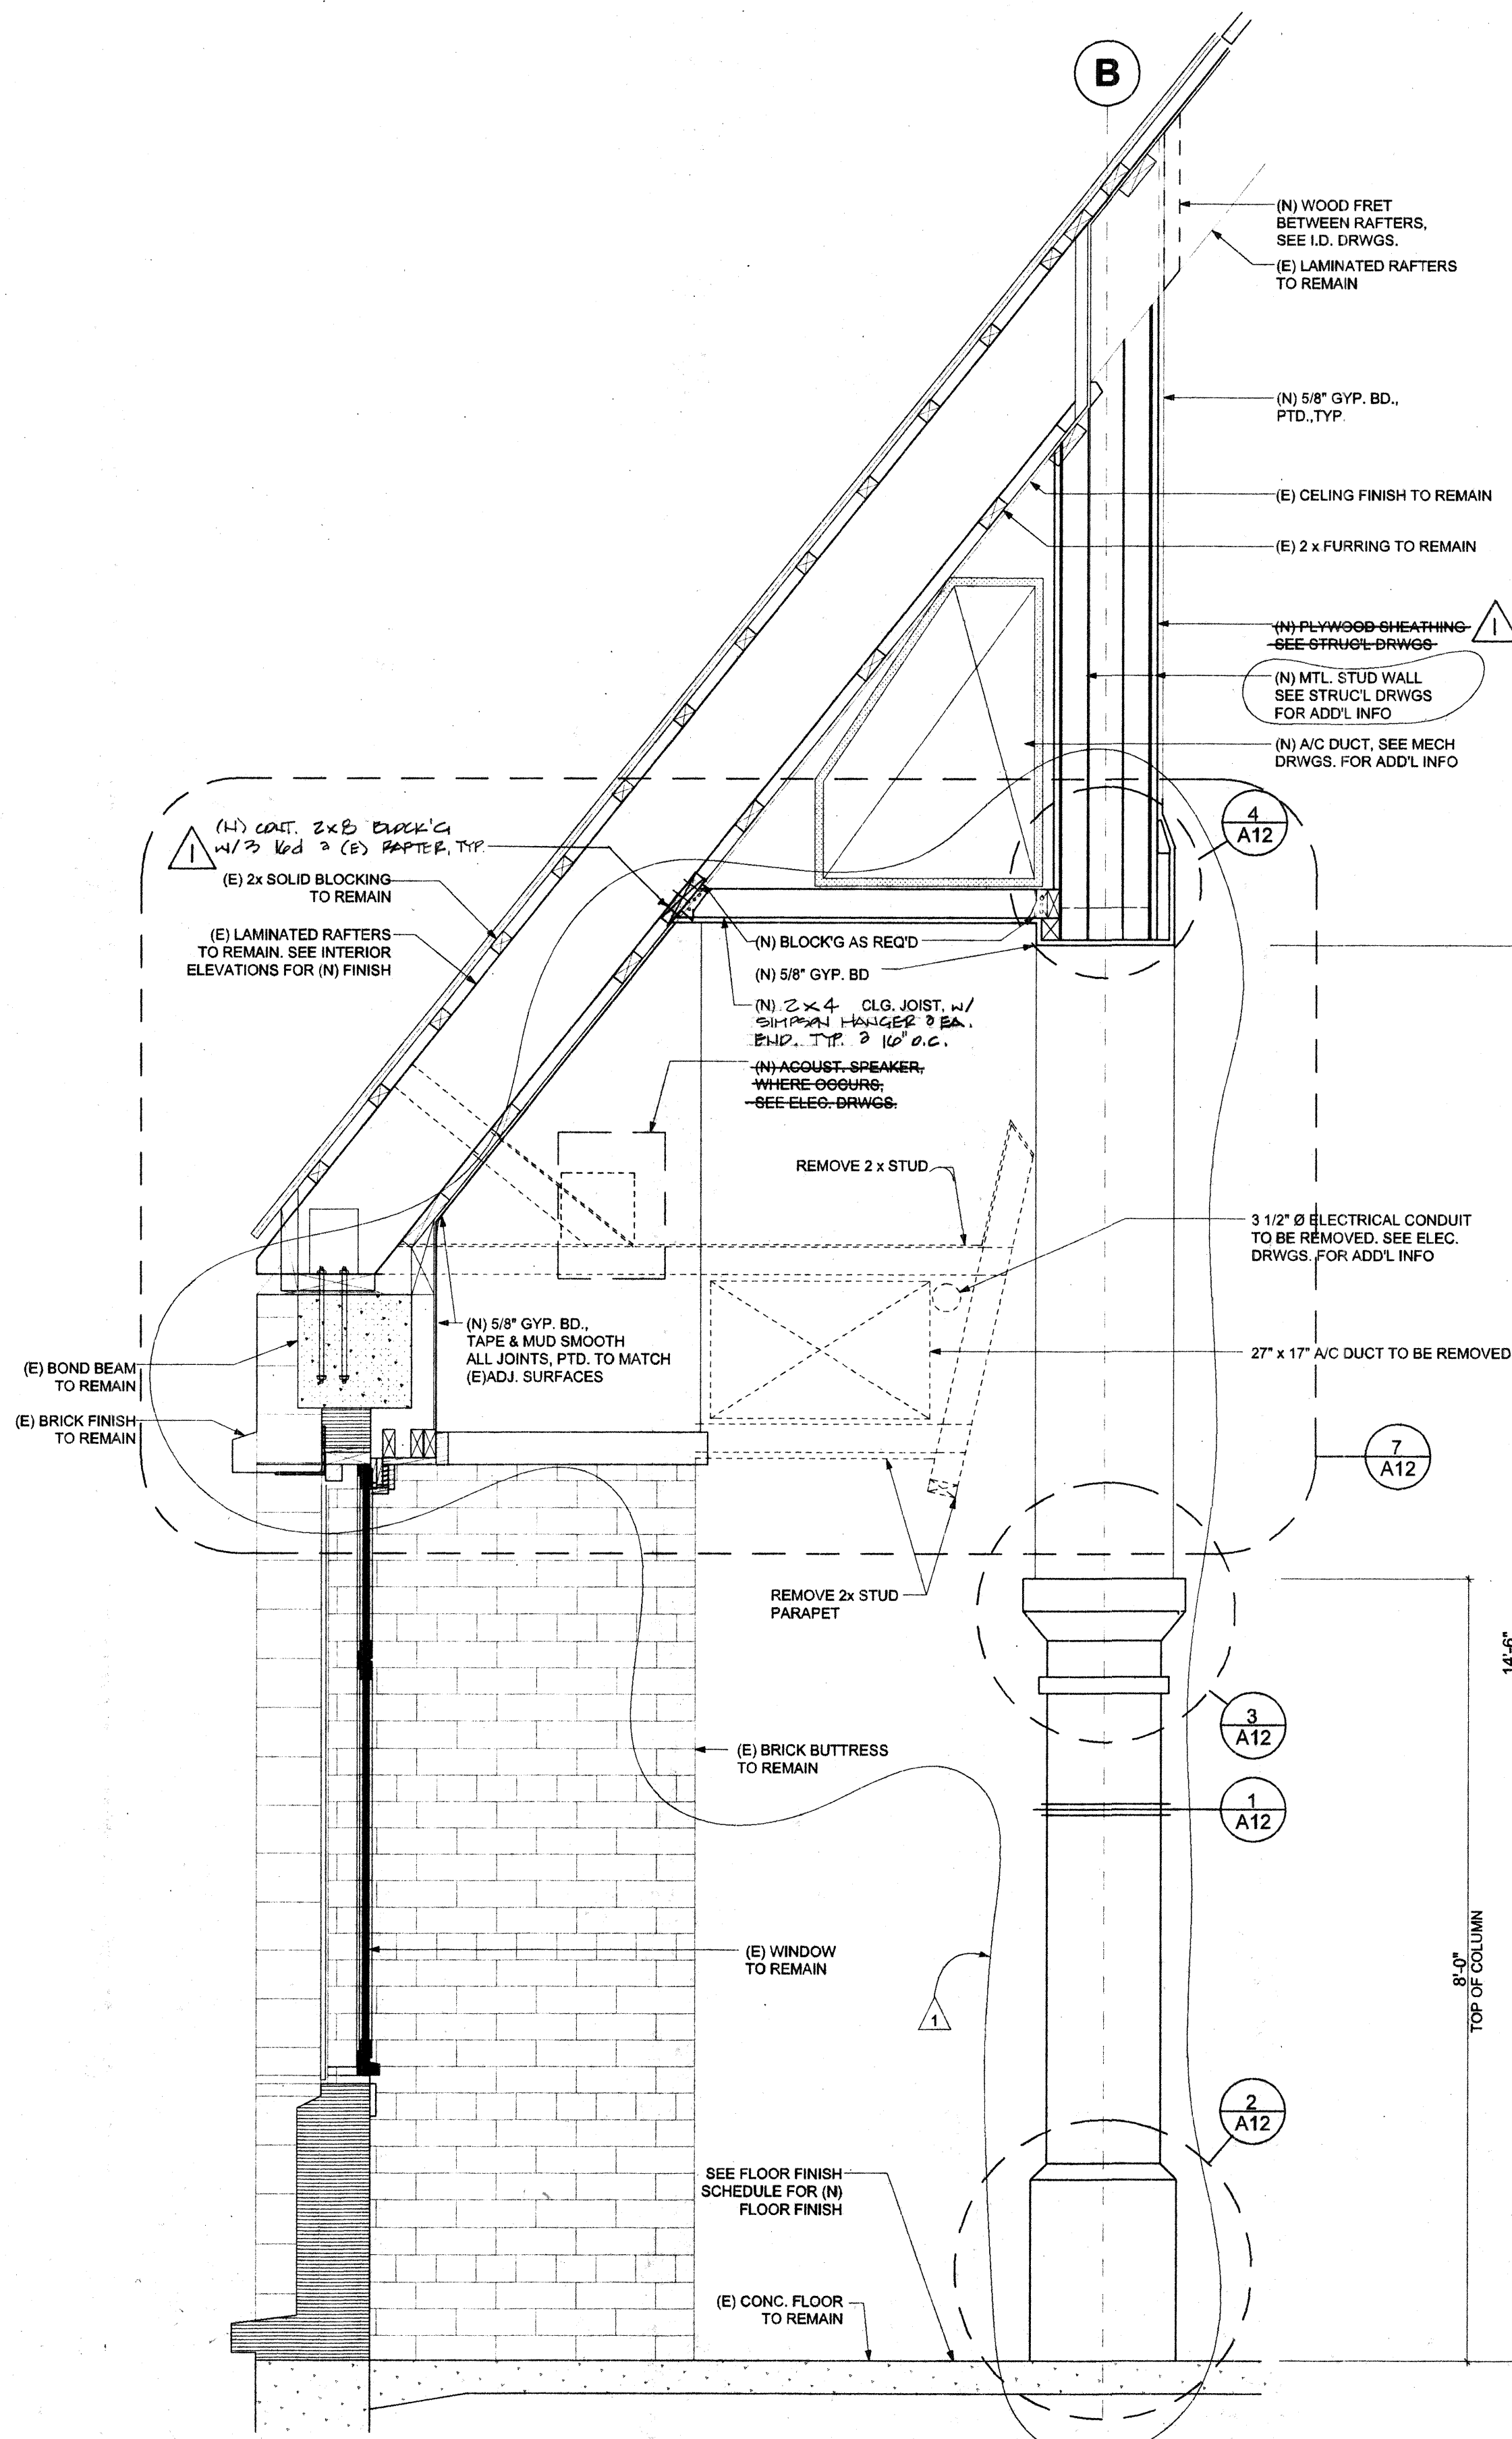

2 SECTION
3/4" = 1'-0"

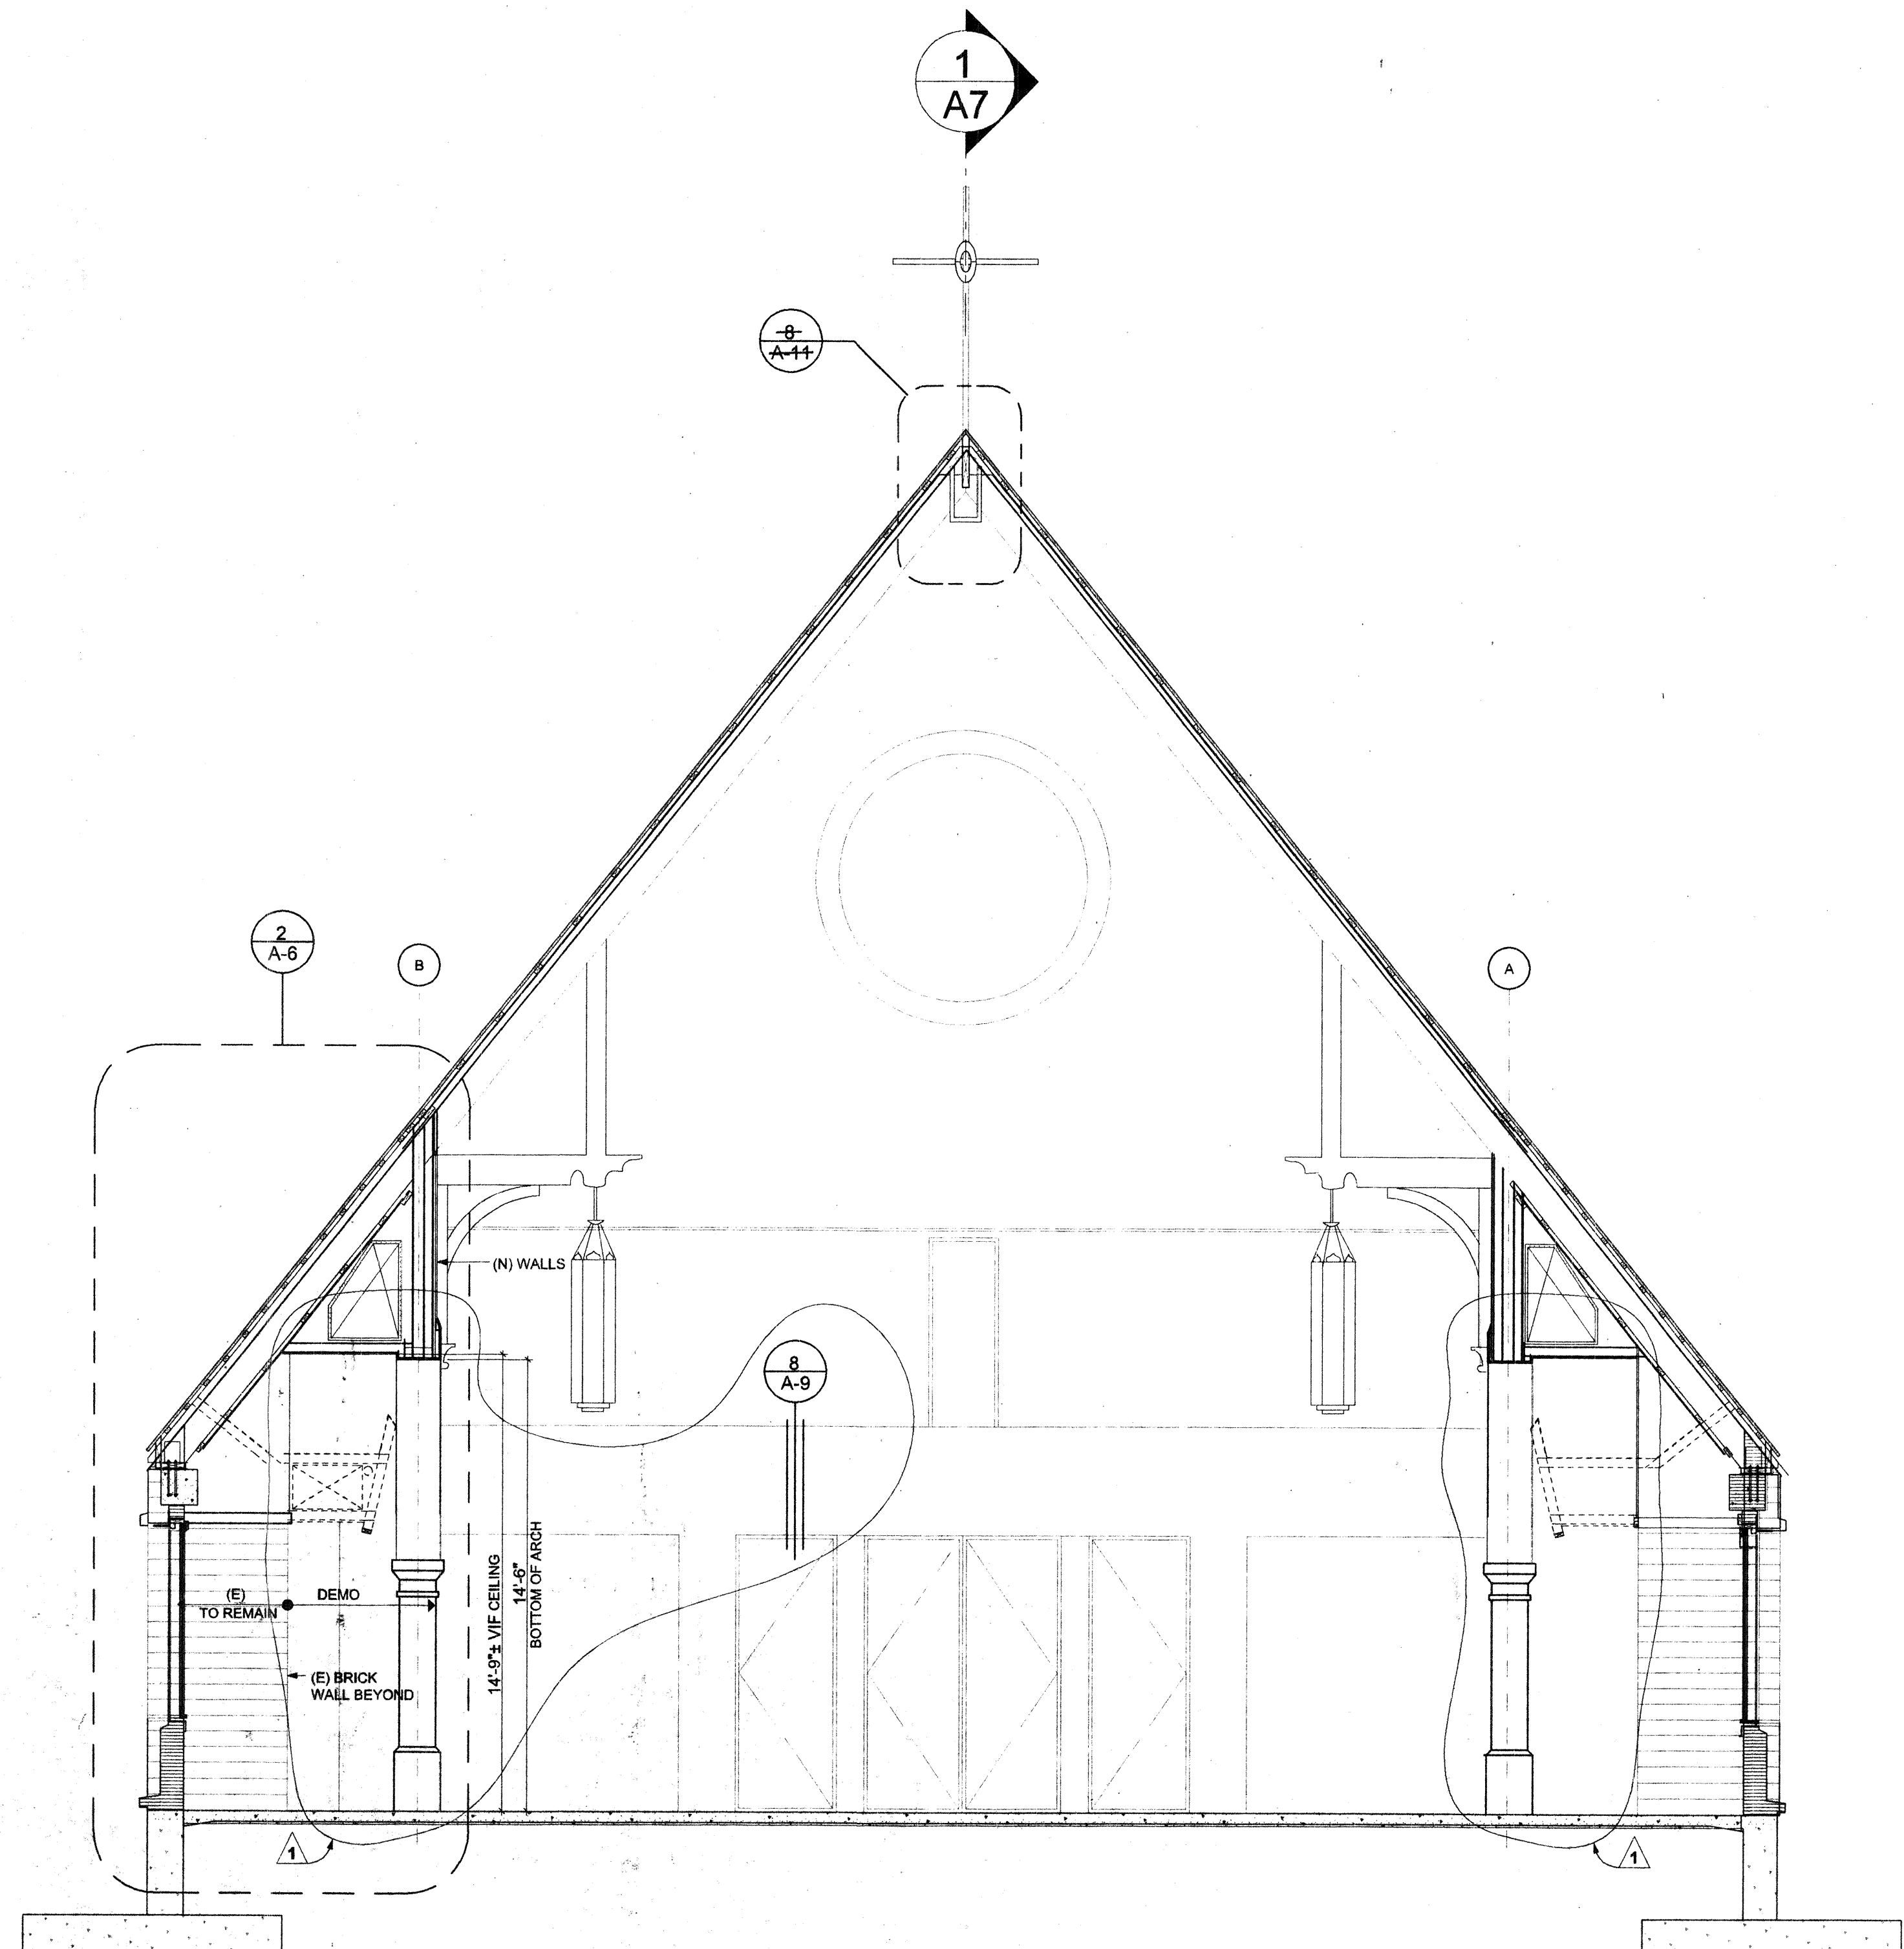

1 SECTION
1/4" = 1'-0"