

Onuma & Associates

Architecture, Planning, Consulting

511 Mission Street
South Pasadena, CA 91030
tel 626.799.9920
fax 626.799.8260
e-mail: info@onuma.com

Consultants

RENOVATION PROJECT

FOR

SAINT EDMUND'S

EPISCOPAL CHURCH

1175 SAN GABRIEL BLVD., SAN MARINO, CA. 91108-8048

STAMPS



REVISIONS

DESCRIPTION	DATE	BY
PLAN CHECK		

PROJECT NUMBER

2000

SCALE AS NOTED


PRINTED 11/16/00

TITLE
W.C. ENLARGED
PLANS, ELEVATIONS
& DETAILS

SHEET


A-8

11 OF 44

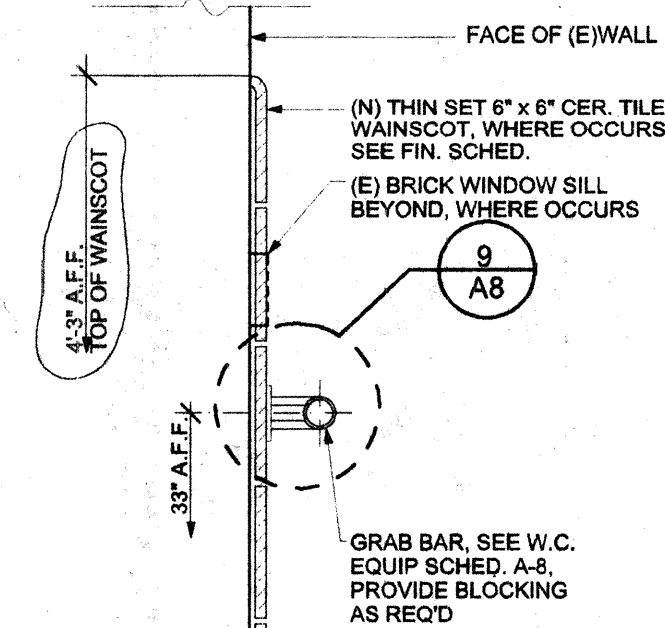


10 W.C. WAINSCOT

SCALE 1 1/2" = 1'-0"

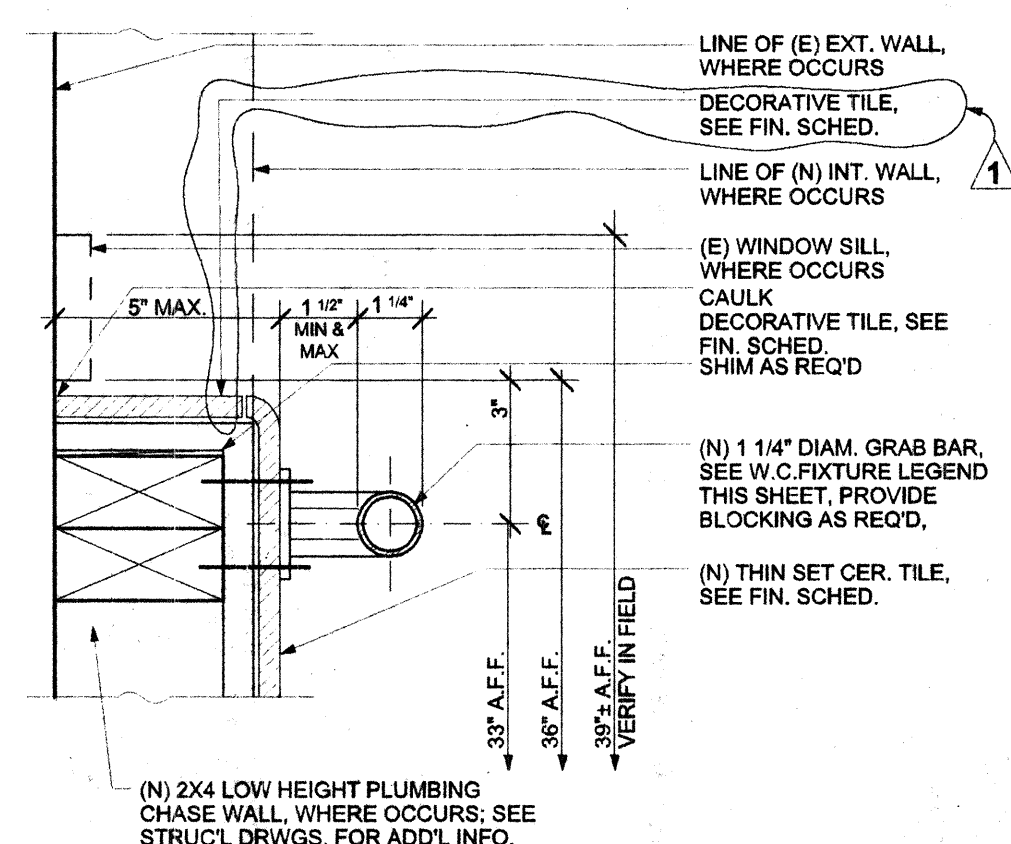

9 W.C. GRAB BAR DET.


SCALE 3" = 1'-0"

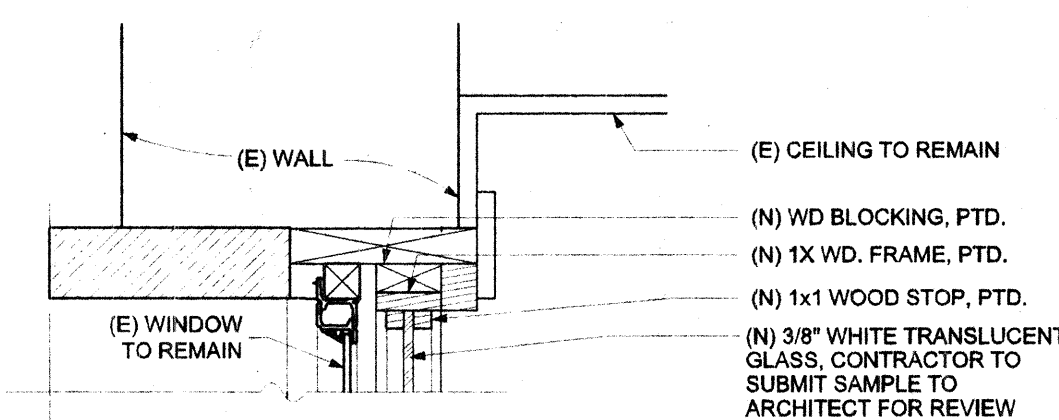

NOTE:
CONTRACTOR TO VERIFY ALL EXISTING
CONDITIONS AND SUBMIT SHOP
DRAWINGS OF (N) WINDOW TO
ARCHITECT FOR REVIEW.

8 W.C. WINDOW HEAD


SCALE 1 1/2" = 1'-0"

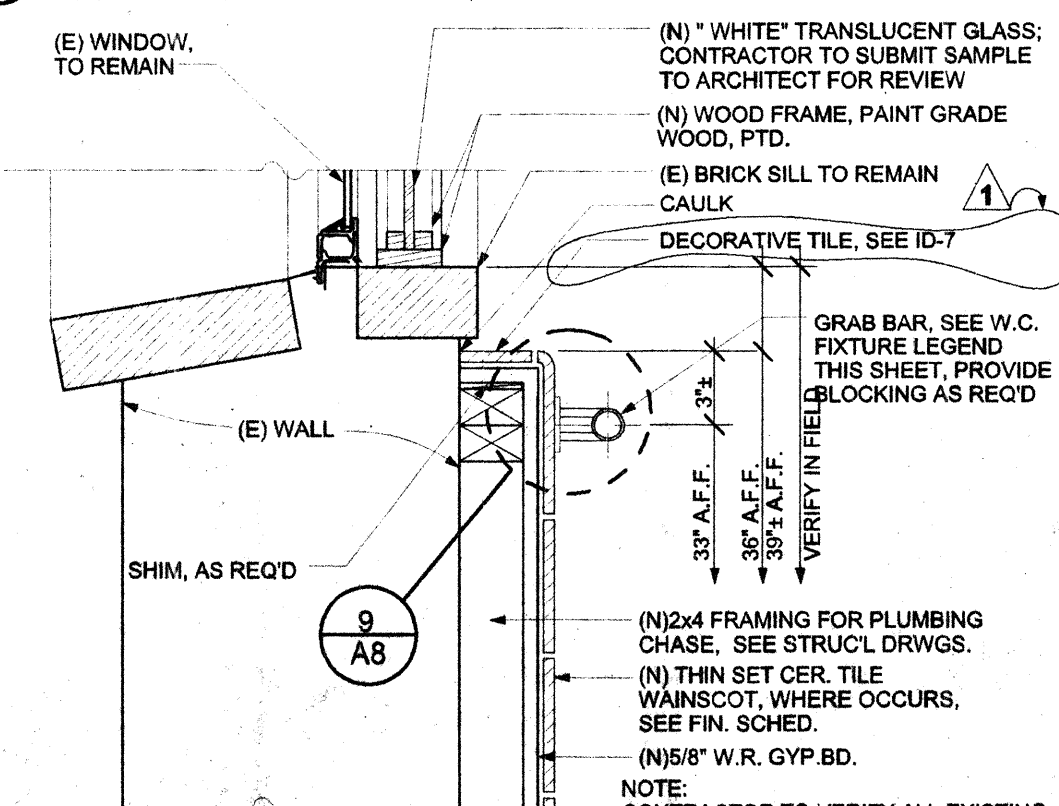

NOTE:
CONTRACTOR TO VERIFY ALL EXISTING
CONDITIONS AND SUBMIT SHOP
DRAWINGS OF (N) WINDOW TO
ARCHITECT FOR REVIEW.


7 W.C. WINDOW SILL

SCALE 1 1/2" = 1'-0"

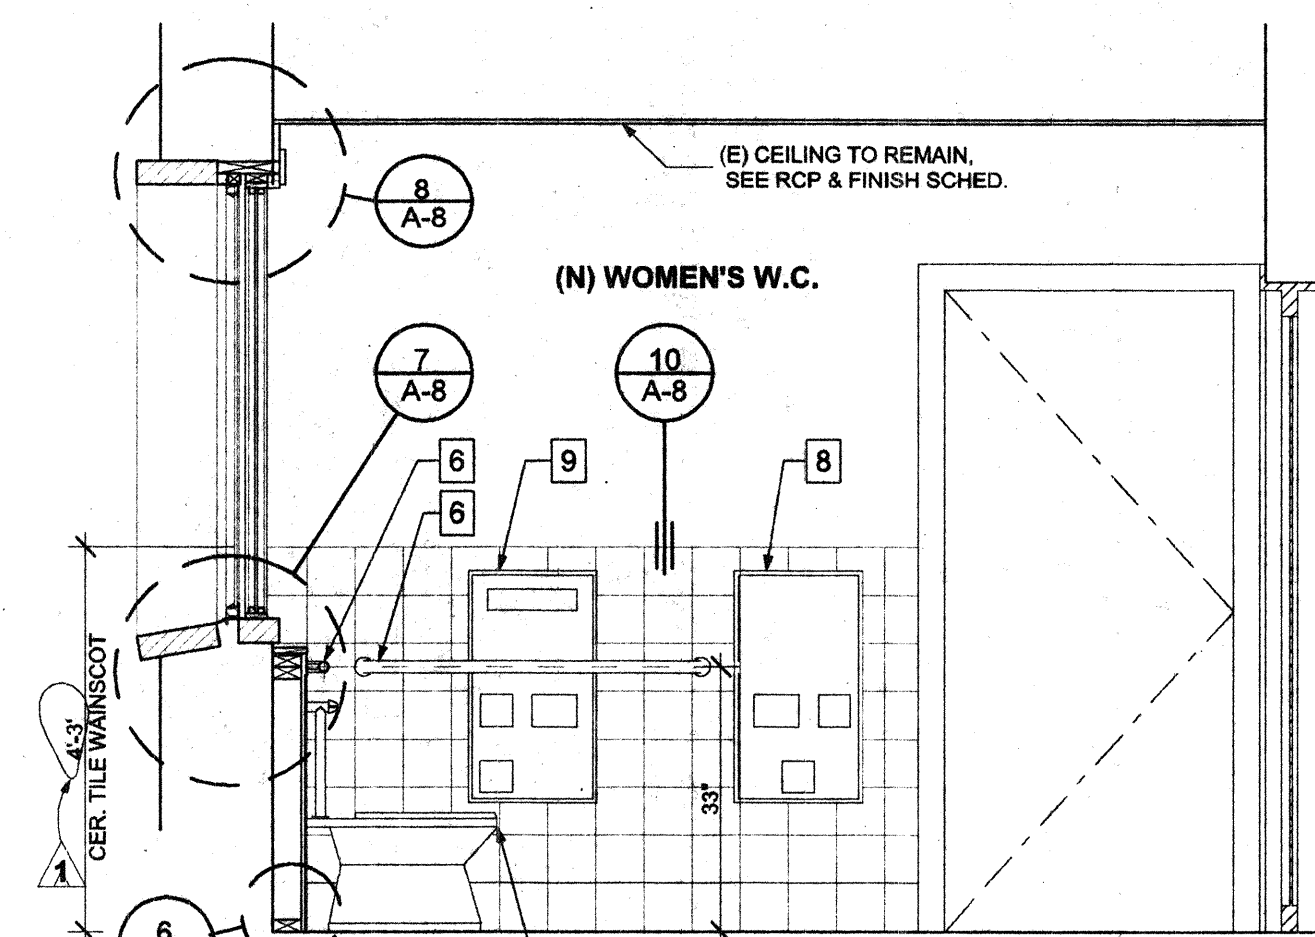

5 W.C. ELEVATION

SCALE 1/2" = 1'-0"

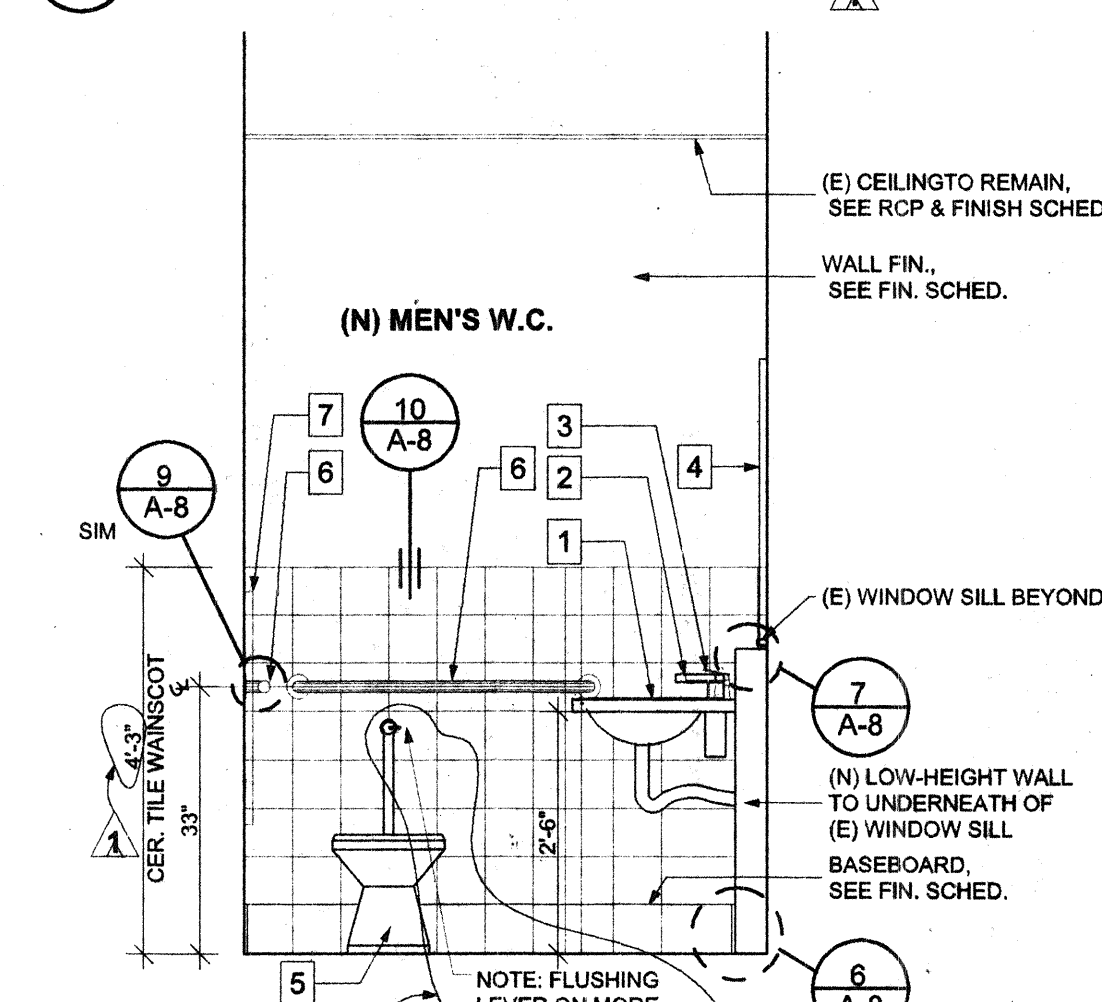


4 W.C. ELEVATION

SCALE 1/2" = 1'-0"

W.C. FIXTURE LEGEND


- 1 SINK: AMERICAN STANDARD "MURRO",
COLOR: "WHITE", OR APPROVED EQUAL
- 2 FAUCET: AMERICAN STANDARD "MONTERREY"
OR APPROVED EQUAL
- 3 SOAP DISPENSER: BOBRICK B-8221,
SINK MOUNTED, OR APPROVED EQUAL
- 4 MIRROR: BOBRICK B-289-1630,
MTD. MAX. 40" AFF., OR EQUAL
- 5 TOILET: AMERICAN STANDARD "MADERA"
COLOR: "WHITE", OR APPROVED EQUAL
- 6 GRAB BAR: BOBRICK B-8806,
SEE PLAN FOR LENGTH, PROVIDE
BACKING IN WALL PER ASTM
REQUIREMENTS, OR APPROVED EQUAL
- 7 RECESSED TOILET SEAT COVER
AND TOILET PAPER DISPENSER:
BOBRICK B-3474, OR APPROVED EQUAL
- 8 RECESSED SANITARY NAPKIN
DISPENSER: BOBRICK B-3500X2 25
OR APPROVED EQUAL
- 9 RECESSED TOILET SEAT COVER
AND TOILET PAPER DISPENSER:
WITH SANITARY NAPKIN DISPOSAL:
BOBRICK B-3579, OR APPROVED EQUAL
- 10 WALL MOUNTED PAPER TOWEL
DISPENSER: BOBRICK B-262,
OR APPROVED EQUAL

NOTE:
ALL FIXTURES TO BE MOUNTED IN
ACCORDANCE PER APPLICABLE
ADA CODES AND SPECIFICATIONS.
CONTRACTOR TO PROVIDE BLOCKING
IN WALLS AS REQ'D.

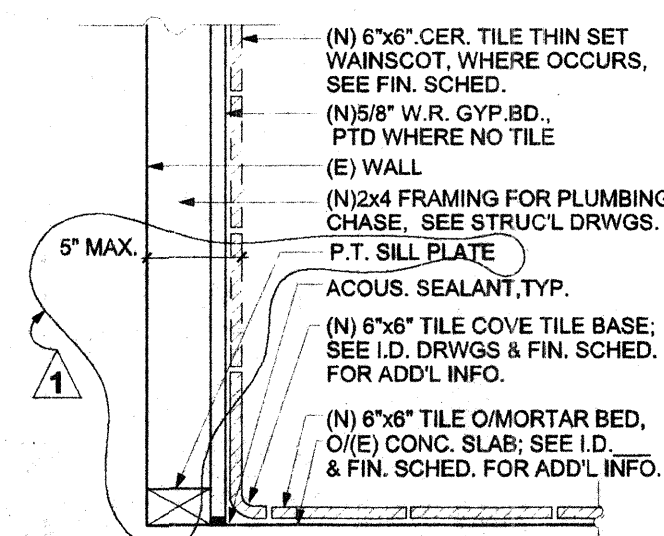


6 W.C. COVE TILE BASEBD. DET.

SCALE 1 1/2" = 1'-0"

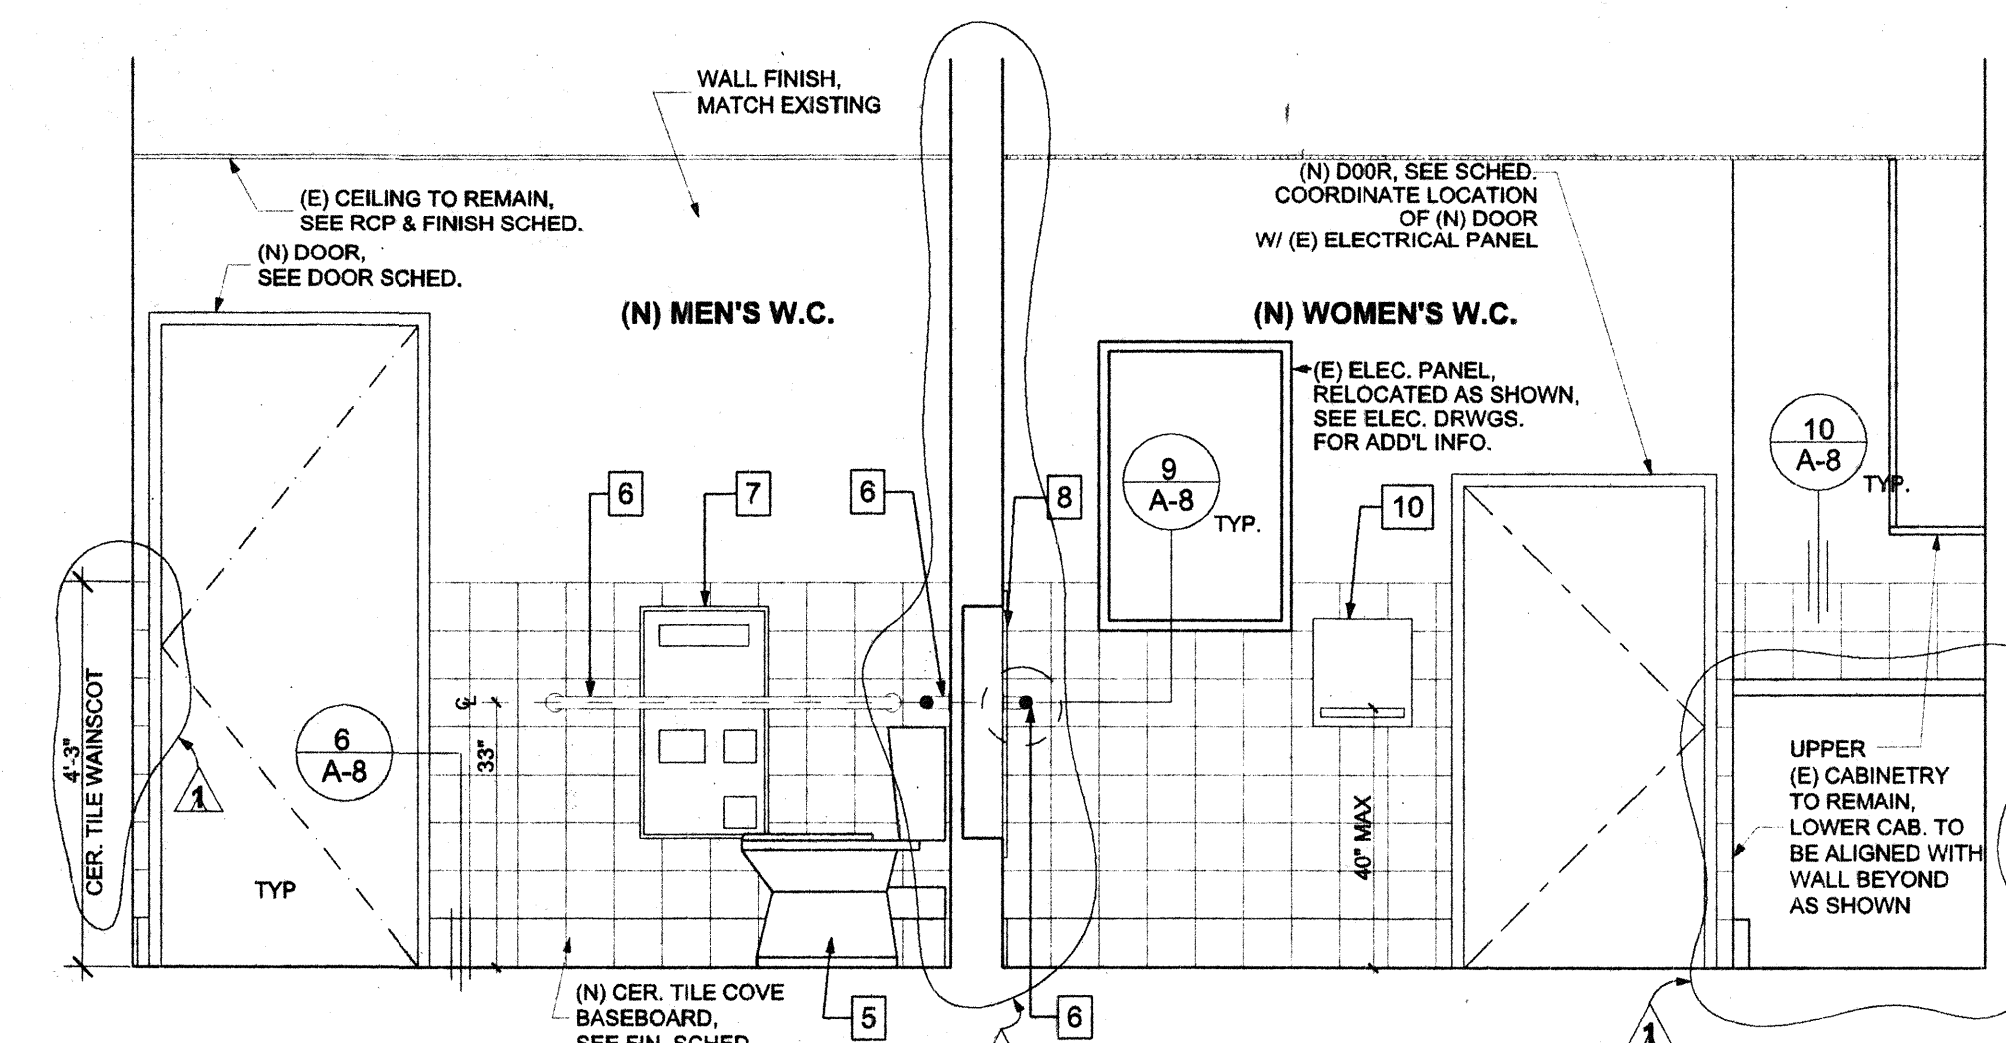


3 W.C. ELEVATION

SCALE 1/2" = 1'-0"

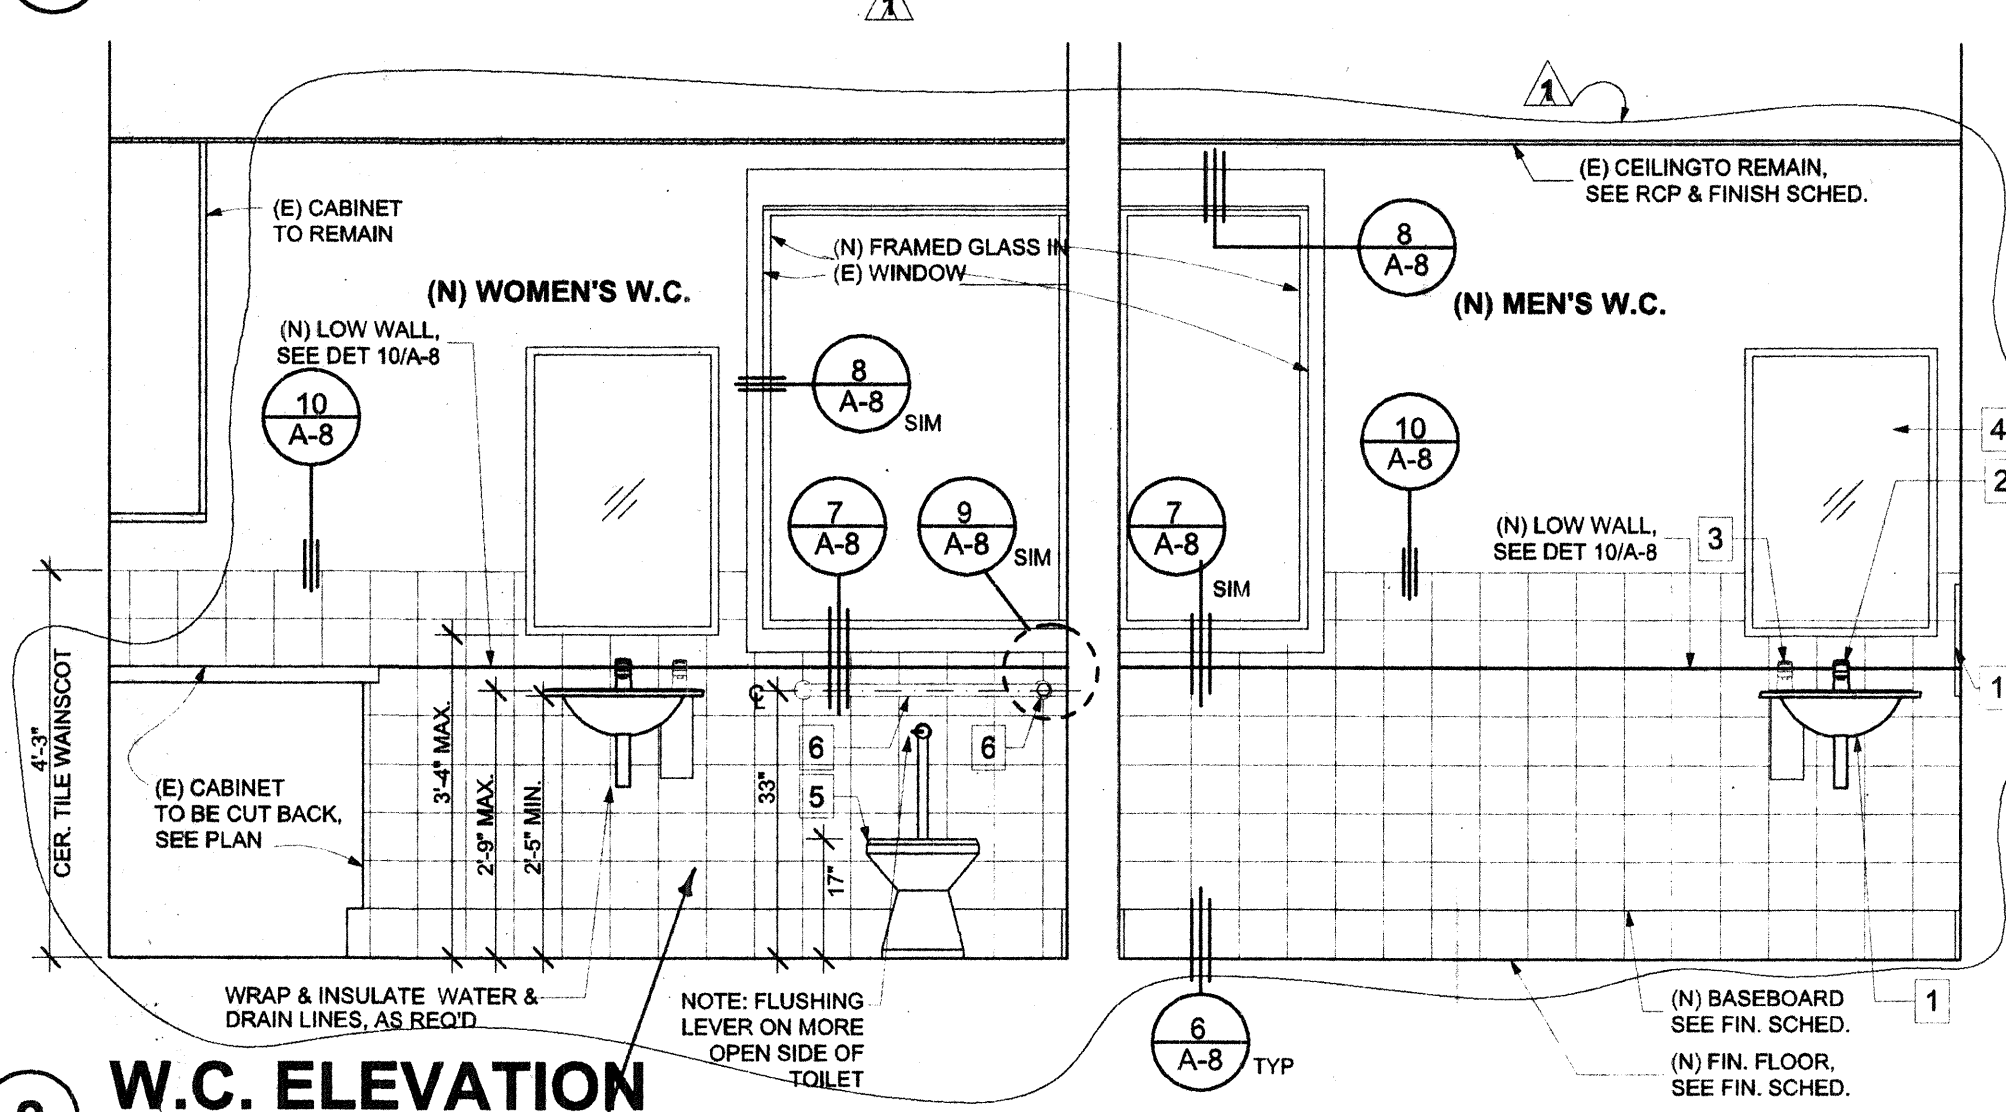

2 W.C. ELEVATION

SCALE 1/2" = 1'-0"

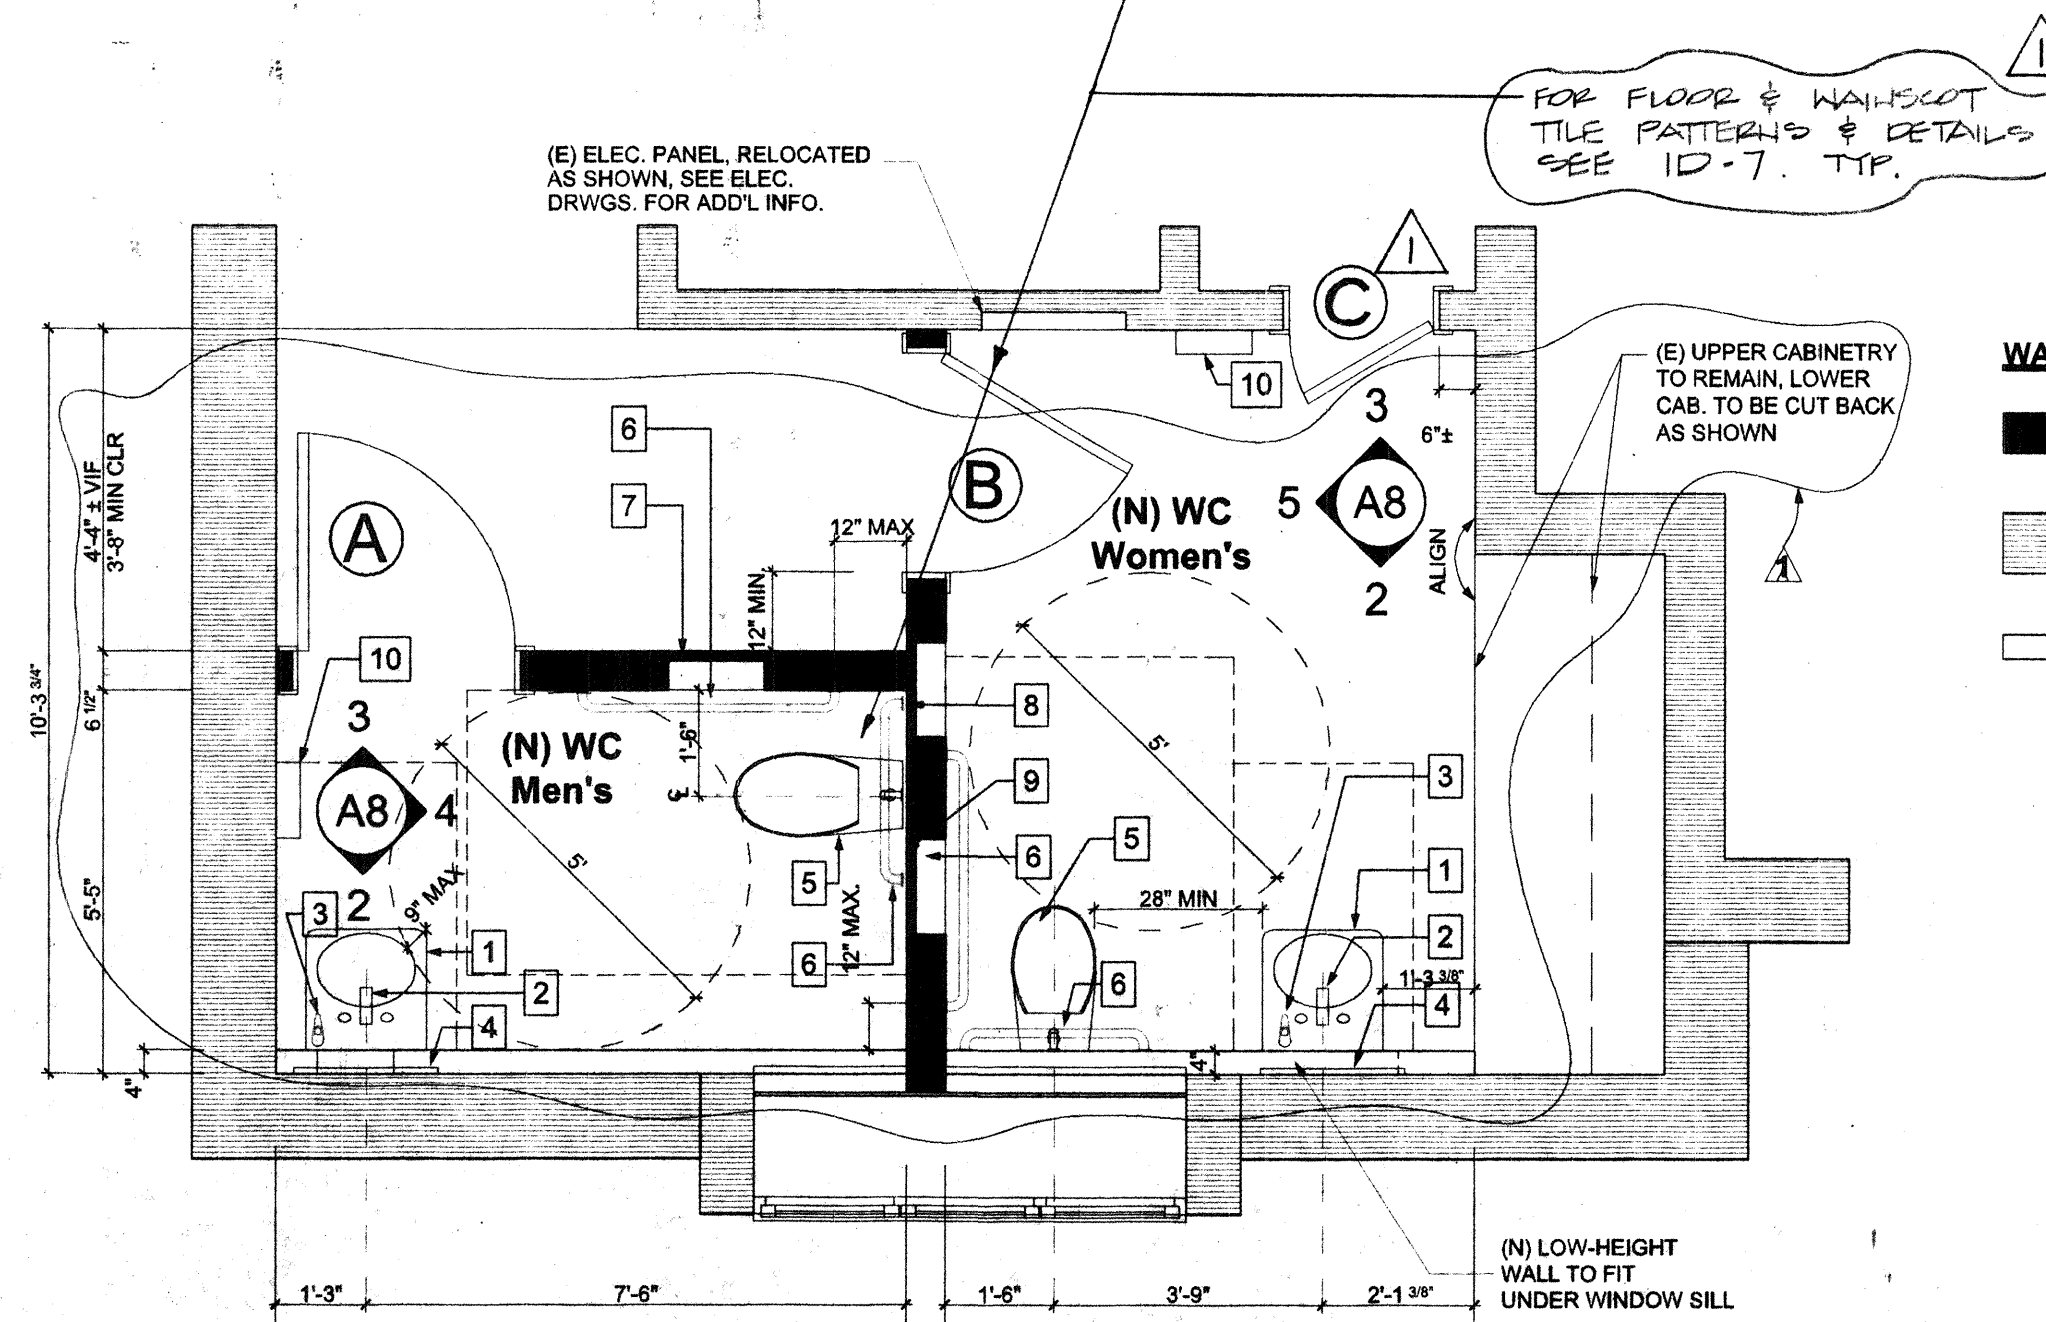

1 W.C. ENLARGED PLANS

SCALE 1/4" = 1'-0"