

Onuma & Associates

Architecture, Planning, Consulting
511 Mission Street
South Pasadena, CA 91030
tel 626. 799. 9920
fax 626. 799. 8260
e-mail: info@onuma.com

Consultants


RENOVATION PROJECT
FOR
SAINT EDMUND'S
EPISCOPAL CHURCH
1175 SAN GABRIEL BLVD., SAN MARINO, CA. 91108-9048

STAMPS




REVISIONS


DESCRIPTION	DATE	BY
PLAN CHECK		
PROJECT NUMBER	2000	
SCALE	AS NOTED	
PRINTED	11/16/00	
TITLE	RAMPS & STAIRS ENLARGED PLANS, ELEVATIONS & DETAILS	
SHEET	A-10	

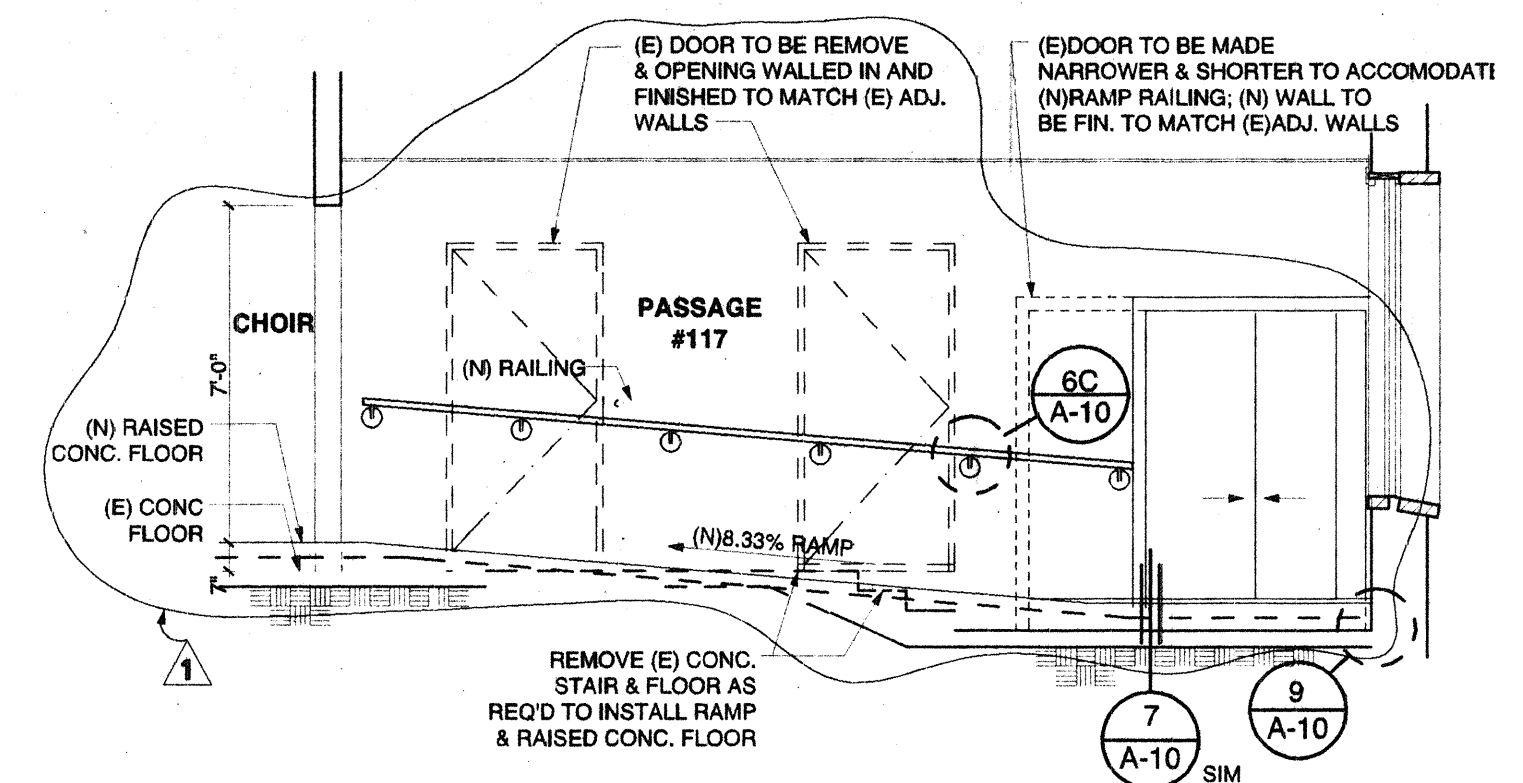


3 RAMP ELEVATION
SCALE 1/4" = 1'-0"

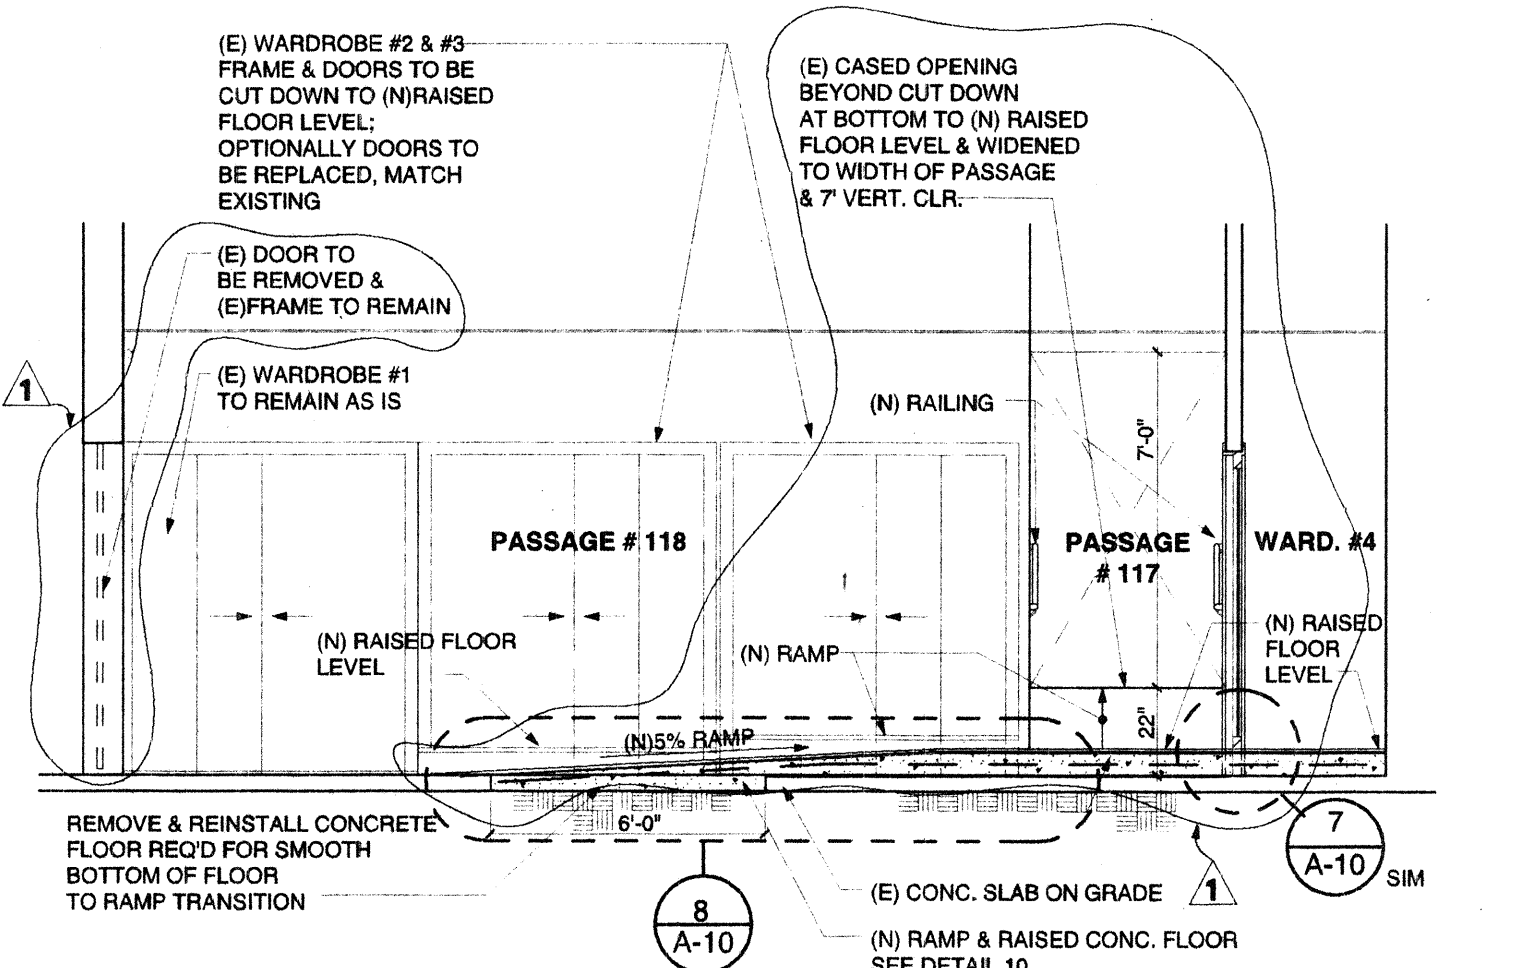


2 RAMP ELEVATION
SCALE 1/4" = 1'-0"

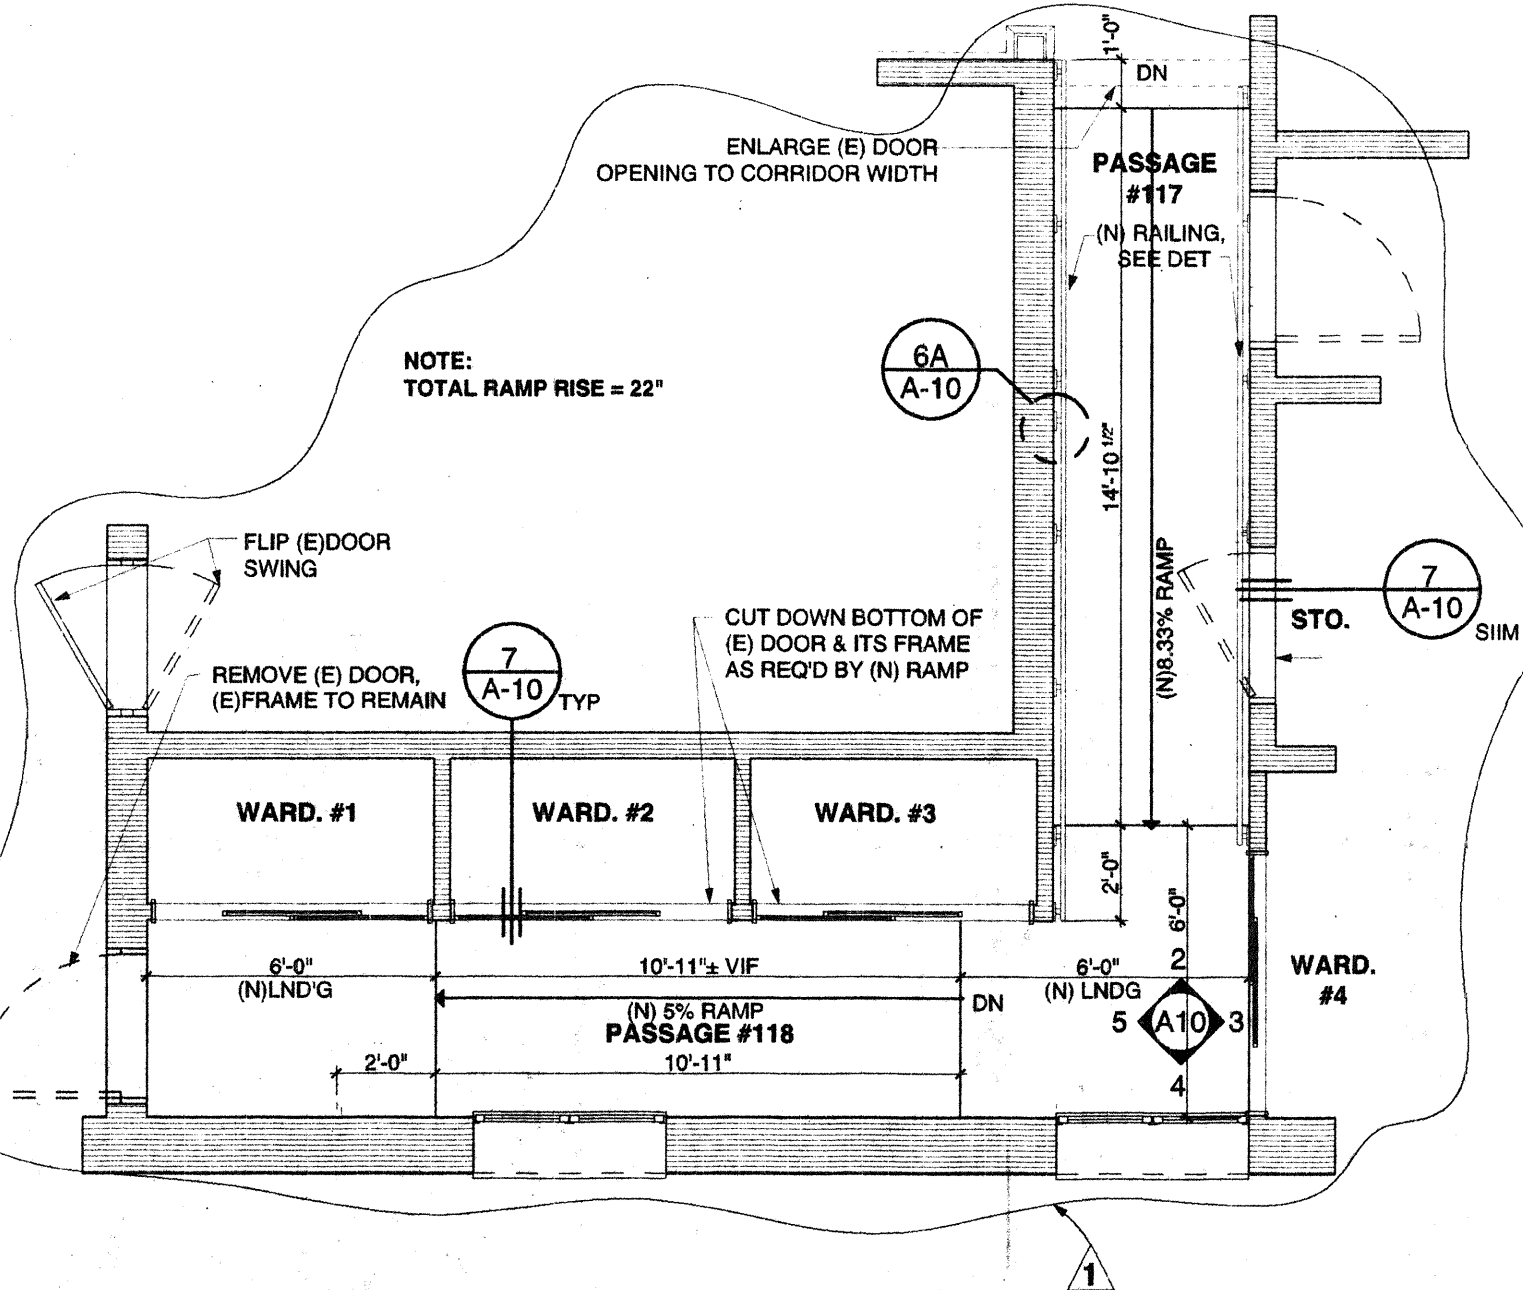


1 RAMP: ENLARGED PLAN
SCALE 1/4" = 1'-0"

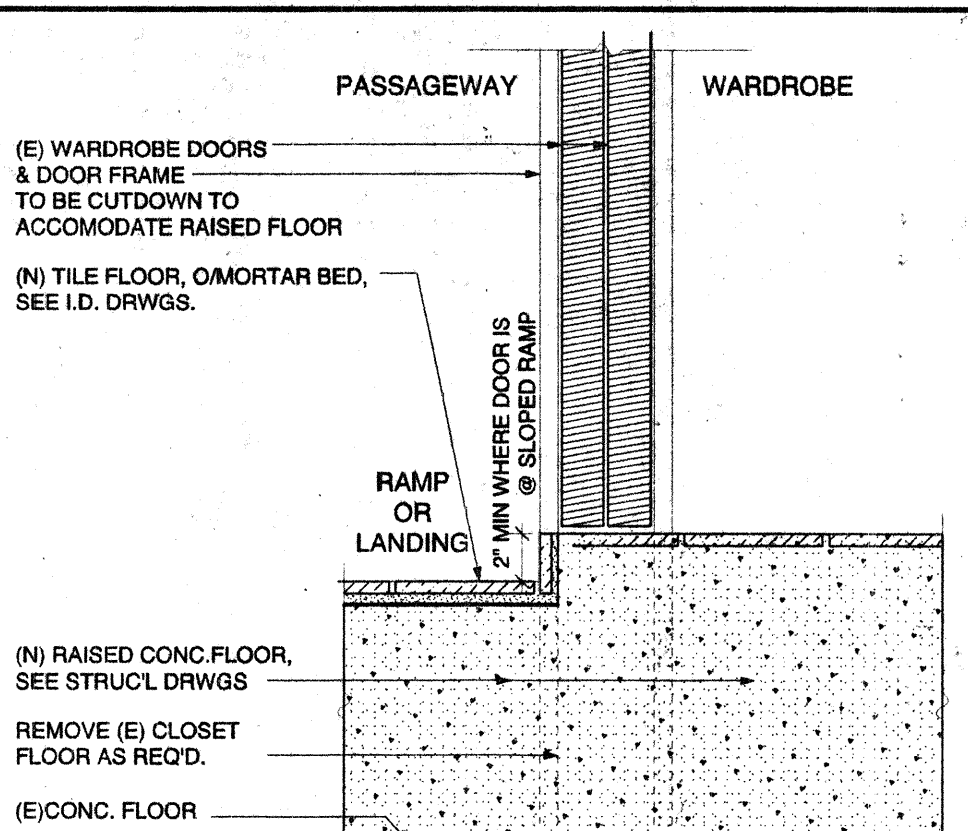


7 RAISED CLOSET FLOOR DET.
SCALE 1 1/2" = 1'-0"

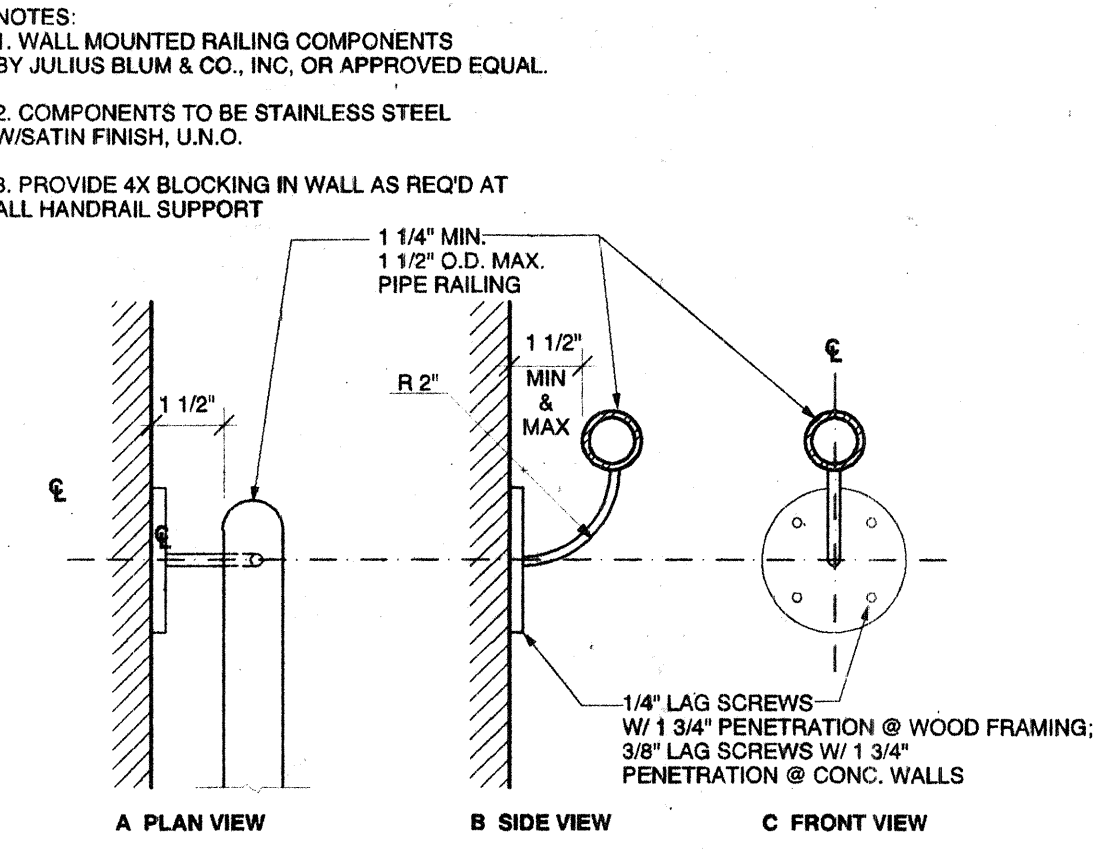


6 HAND RAIL DETAILS
SCALE 3" = 1'-0"

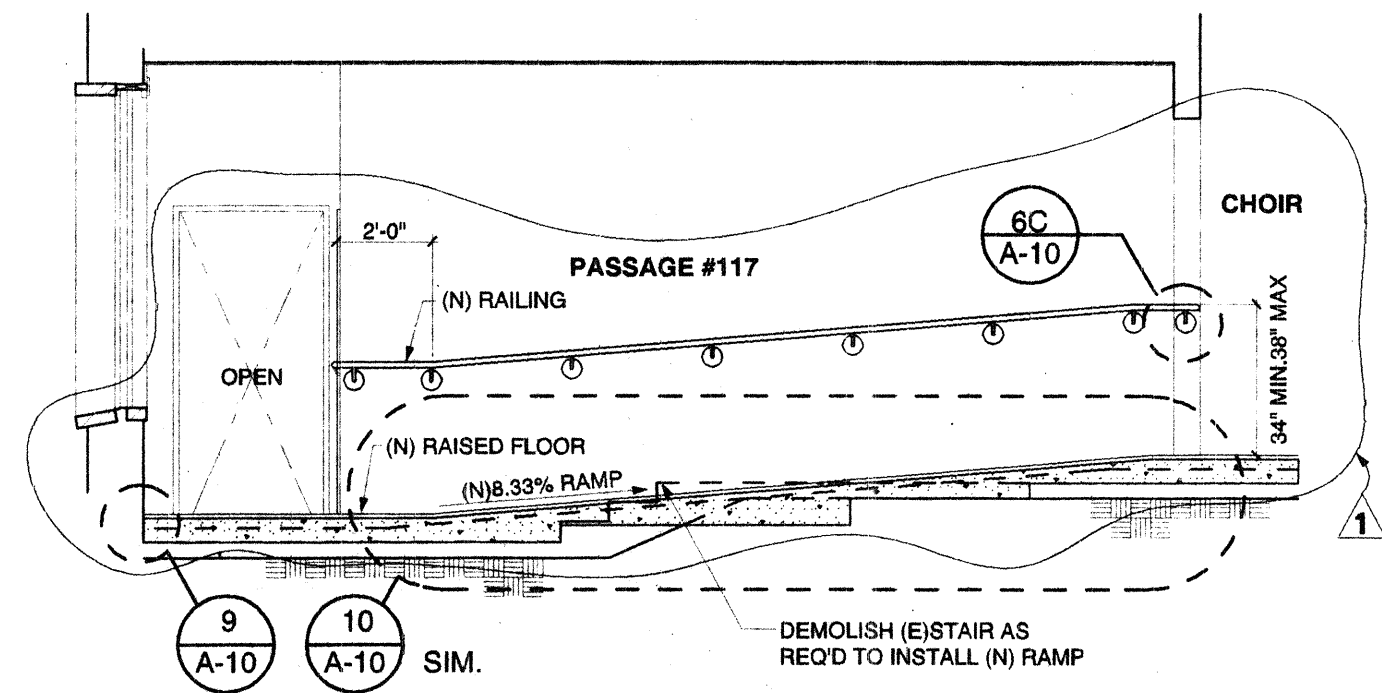


5 RAMP ELEVATION
SCALE 1/4" = 1'-0"

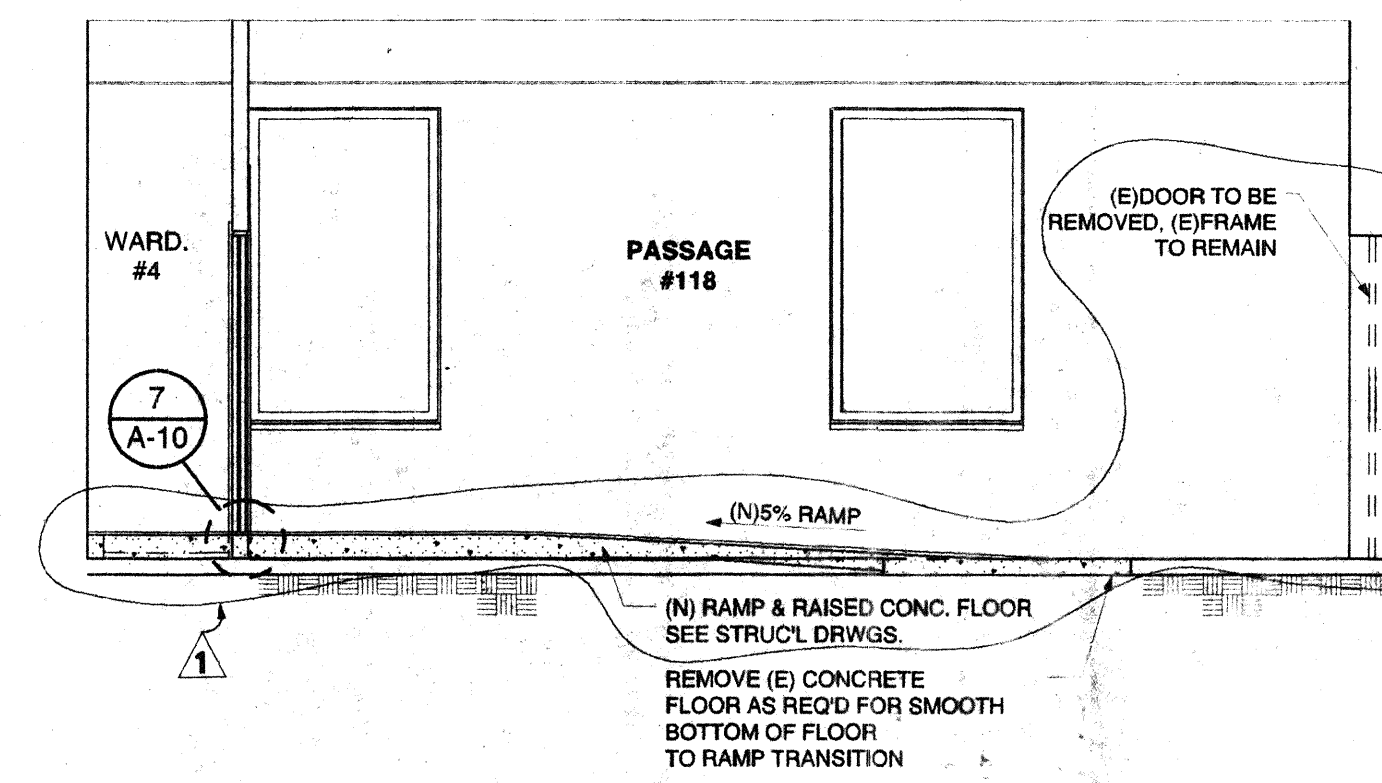


4 RAMP ELEVATION
SCALE 1/4" = 1'-0"

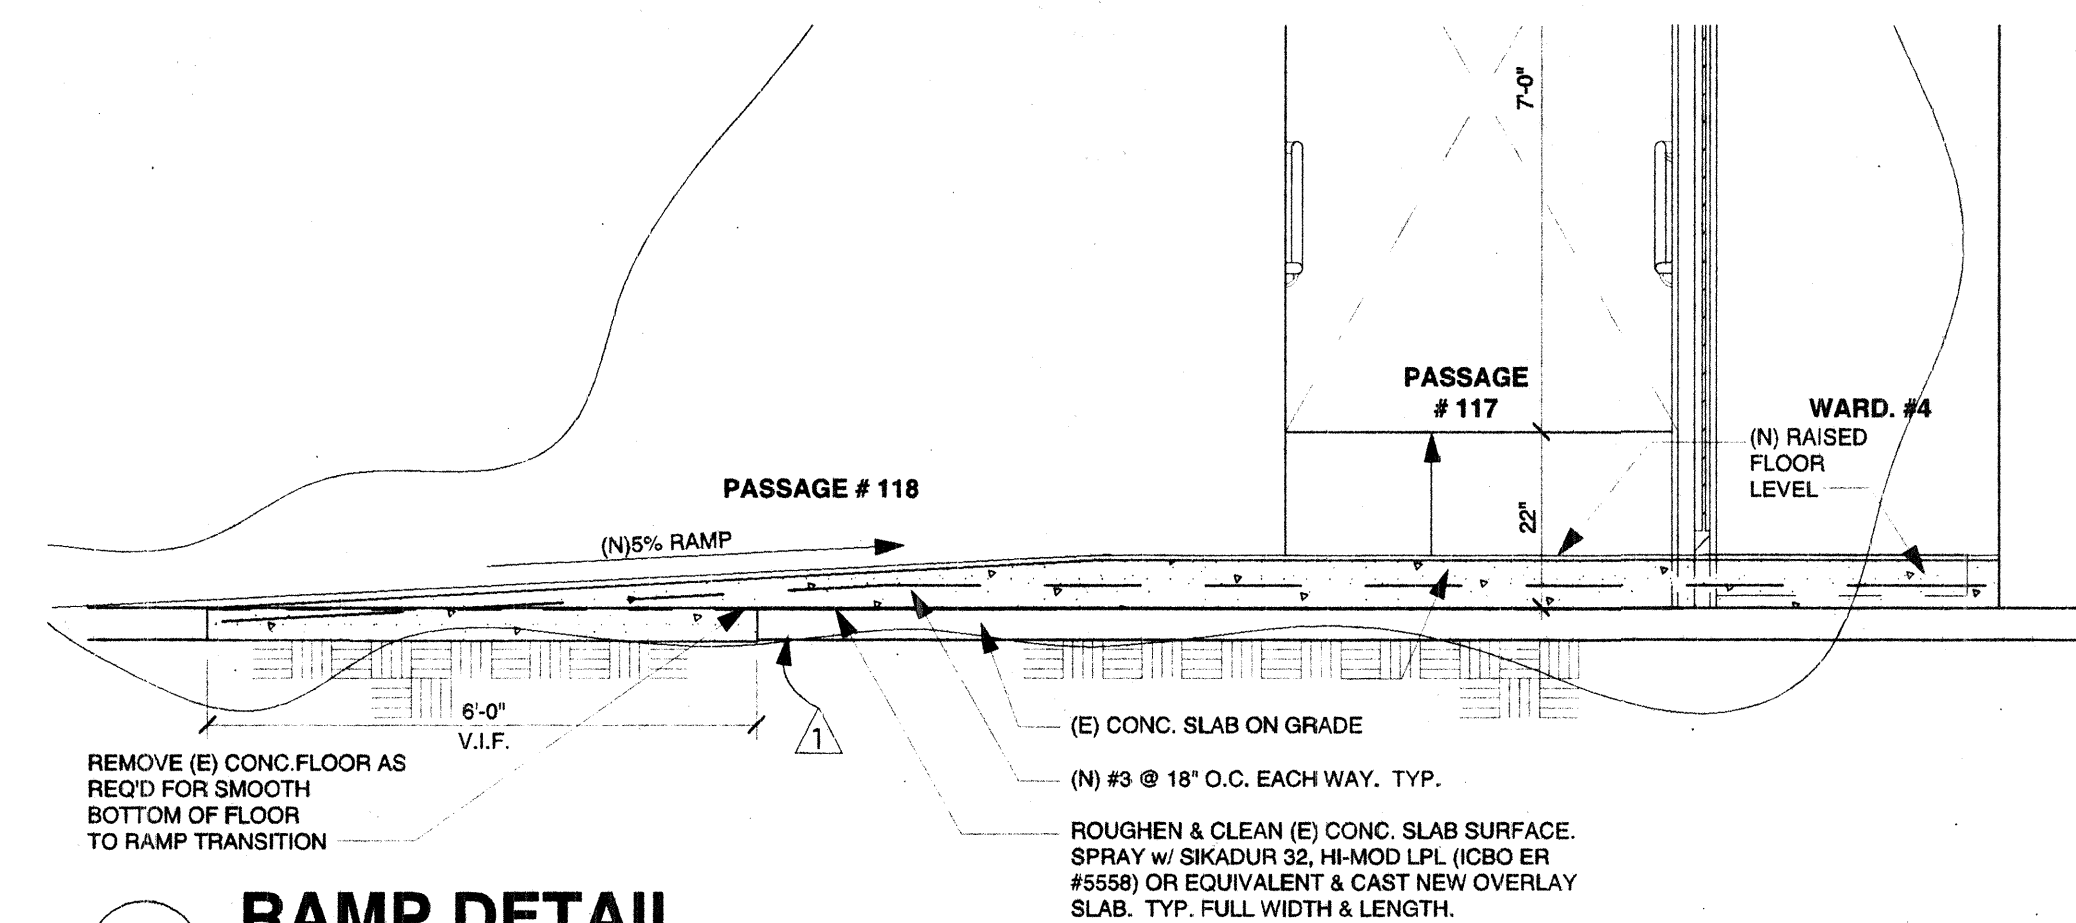

10 RAMP DETAIL
SCALE 1/2" = 1'-0"

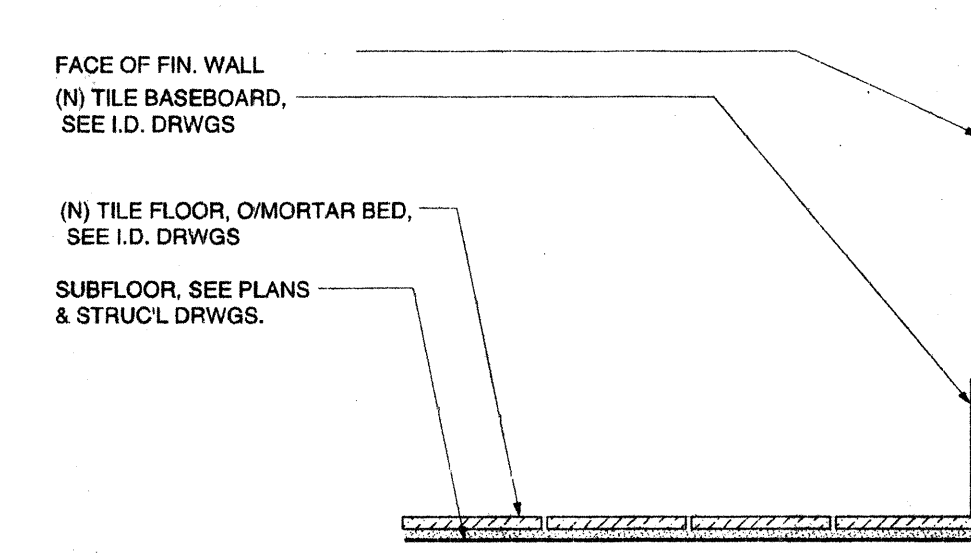

9 (N) TILE BASEBOARD DET.
SCALE 1 1/2" = 1'-0"

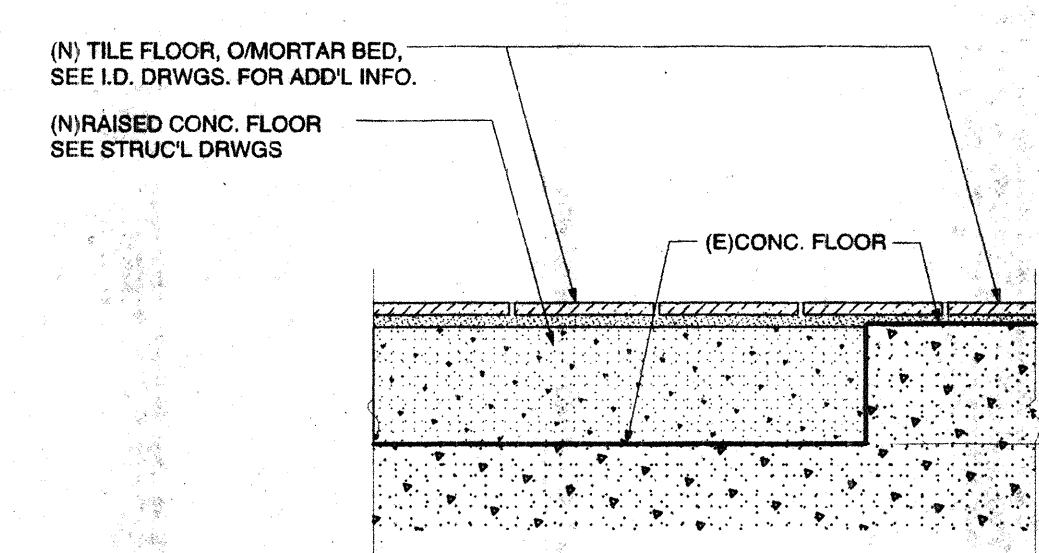

8 (N) RAISED FLOOR @ EXIST.
SCALE 1 1/2" = 1'-0"