

AIR HANDLER SCHEDULE																	
SYMBOL	MANUFACTURER	MODEL NO.	ELECTRICAL				RPM	CFM	S.P Inch	COOLING COIL				2" THRU AWAY FILTER P.D	WEIGHT	REMARK	
			VOLT	CYCLE	PHASE	HP				MBH	DT	ROWS	PD				
AH-1	TRANE	CLCHDS 14A	208	60	3	10	970	8000	2.75	240	20	4	0.95	0.15	1250	1.UNIT TO BE ORDERED TO THE SITE AS A FAN & COIL SEC.-SEPARATED	2.W/ ECONOMIZER CYCLE
AH-2	TRANE	CLCHDS 14A	208	60	3	10	970	8000	2.75	240	20	4	0.95	0.15	1250		

CONDENSING UNIT SCHEDULE										
SYMBOL	MANUFACTURER	MODEL NO.	ELECTRICAL				NOMINAL TON	TOTAL COOLING LODE	SEER	REMARK
			VOLT	CYCLE	PHASE	F.L.A				
CU-1	TRANE	TTA 240B	208	60	3	83.8	20	240000	10.5	
CU-2	TRANE	TTA 240B	208	60	3	83.8	20	240000	10.4	

DUCK FURNACE										
SYMBOL	MANUFACTURER	MODEL NO.	INPUT	OUTPUT	TEMP RANG	WEIGHT	CFM	FLUE SIZE	EER	REMARK
DF-1	REZNOR	HEEDU 250	250000	200000	50-90	300	8000	5"	80%	HIGH EFFICIENCY WITH FORCE DRAFT FLUE EXHAUST
DF-2	REZNOR	HEEDU 250	250000	200000	50-90	300	8000	5"	80%	

AIR BALANCE				
SYMBOL	CFM SUPPLY	MIN. OUTDOOR AIR	MIN. RETURN	REMARK
AH-1	8000	1000	7000	W/ ECONOMIZER CYCLE
AH-2	8000	1000	7000	

SYMBOLS AND ABBREVIATIONS	
	LINED DUCT NET OPENING SIZES GIVEN
	SHEET METAL DUCT, EXISTING
	FLEXIBLE DUCT
	SUPPLY DUCT IN SECTION
	RETURN DUCT IN SECTION
	EXHAUST DUCT IN SECTION
	CU, DUAL CONDENSING UNIT - SPLIT SYSTEM
	SUPPLY DIFFUSER, WITH OPPOSED BLADE DAMPER
	CEILING RETURN REGISTER (CRR) , WITH DAMPER
	MOTORIZED DAMPER
	POINT OF CONNECTION
	WSR, WALL SUPPLY REGISTER
	WRR, WALL RETURN REGISTER
	GAS
	CONDENSATE DRAIN
	REFRIGERANT SUCTION
	REFRIGERANT LIQUID
	TO BE REMOVED
	WALL GRILL
	SECTION A ON SHEET M-2
	DETAIL 1 ON SHEET M-2
AH	AIR HANDLER
AC	AIR CONDITIONING
CFM	CUBIC FEET PER MINUTE
CLG.	CEILING
DB.	DRY BULB
DET.	DETAIL
ELEC.	ELECTRICAL
MECH.	MECHANICAL
F.	FAHRENHEIT
RM.	ROOM
SHT.	SHEET
SM.	SHEET METAL
WB.	WET BULB
(T)	ROOM THERMOSTAT
(BT)	BYPASS TIMER
ARCH.	ARCHITECTURAL
BDD	BACK DRAFT DAMPER
BLDG.	BUILDING
CONT.	CONTINUE
DN.	DOWN
EF.	EXHAUST FAN
EA.	EXHAUST AIR
EX.	EXISTING
N.I.C.	NOT IN CONTRACT
N.T.S	NOT TO SACLE
EF.	EXHAUST FAN
OA.	OUTDOOR AIR
C.D.	CONDENSATE DRAIN
FD	FIRE DAMPER
N.O.	NORMALLY OPEN
N.C.	NORMALLY CLOSE
BTUH	BRITISH TERMAL UNIT PER HOUR
RPM	REVELATION PER HOUR
PD	PRESSURE DROP
SP	STATIC PRESSURE
DT	TEMPERATURE DISTANCE
SFD	SMOKE FIRE DAMPER
M.V.D	MANUAL VOLUME DAMPER
T.G	TRANSFER GRILLE

**Wittler
Young /co.
Inc.**

AS BUILT
DATE: 04/15/2001

**Onuma &
Associates**

Architecture, Planning, Consult.
511 Mission Street
South Pasadena, CA 9103
tel 626. 799. 9920
fax 626. 799. 8260
e-mail: info@onuma.co


Consultants

DEBIBI & ROSHANIAN INC.
MECHANICAL & ELECTRICAL ENGINEERS
1175 SAN GABRIEL BLVD. Suite 202
North Hollywood, CA 91607
TEL (818) 960-0837
FAX (818) 960-1729

AS BUILT

REMODEL
FOR
SAINT EDMUND'S
EPISCOPAL CHURCH
1175 SAN GABRIEL BLVD SAN MARINO CA 91108-R04R

STAMPS

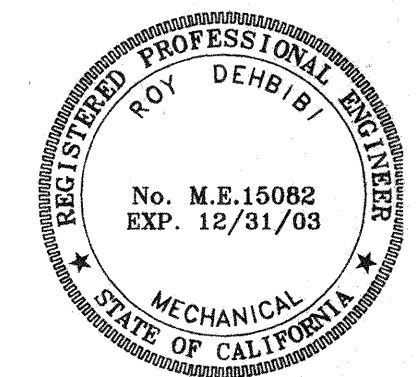

REVISIONS

DESCRIPTION	DATE

PROJECT NUMBER 2001

SCALE AS NOTE

PRINTED 01/18/01

TITLE
**EQUIPMENT
SCHEDULE
SYMB. & ABB.**

SHEET

M-1

OF