


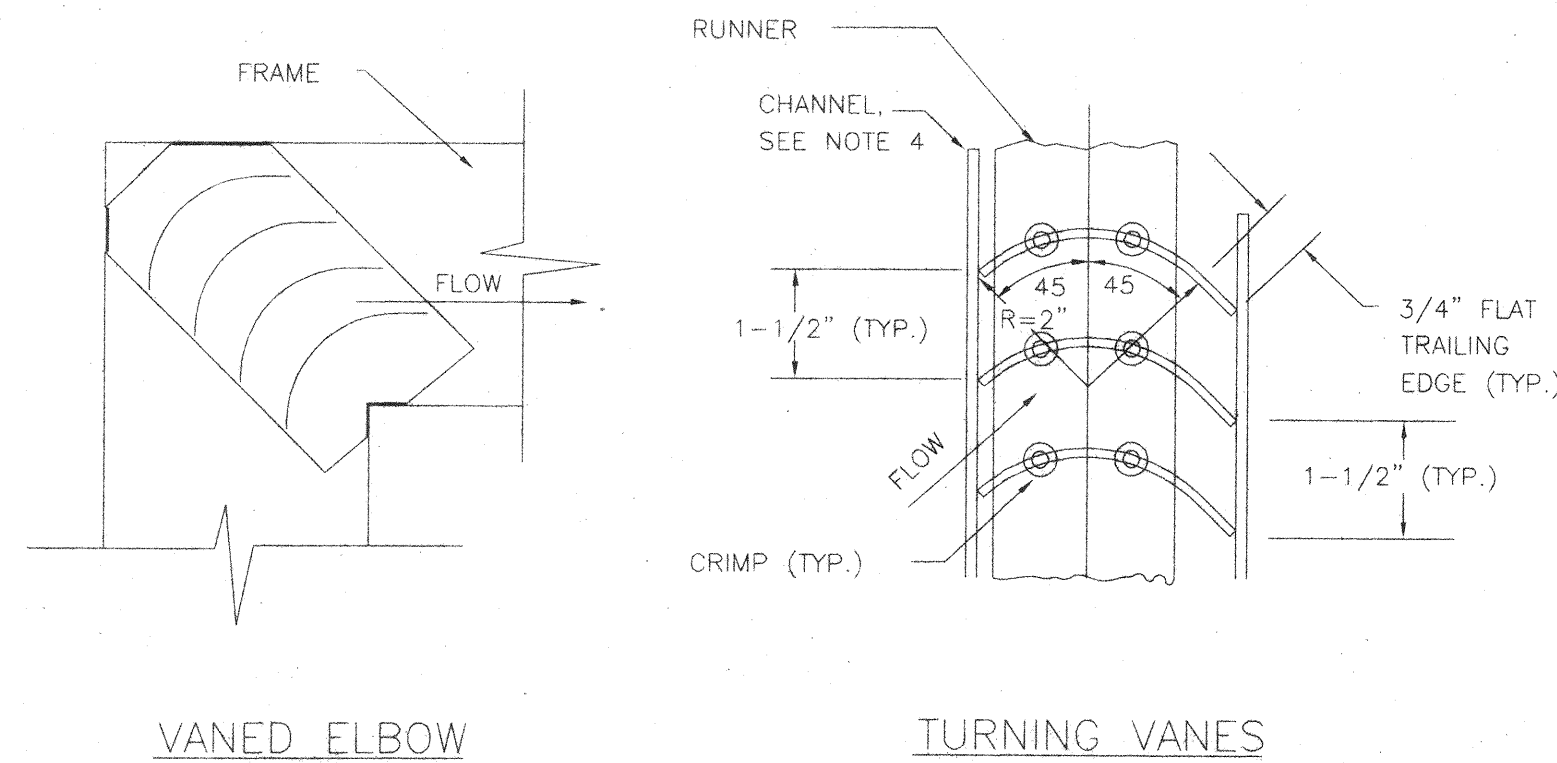


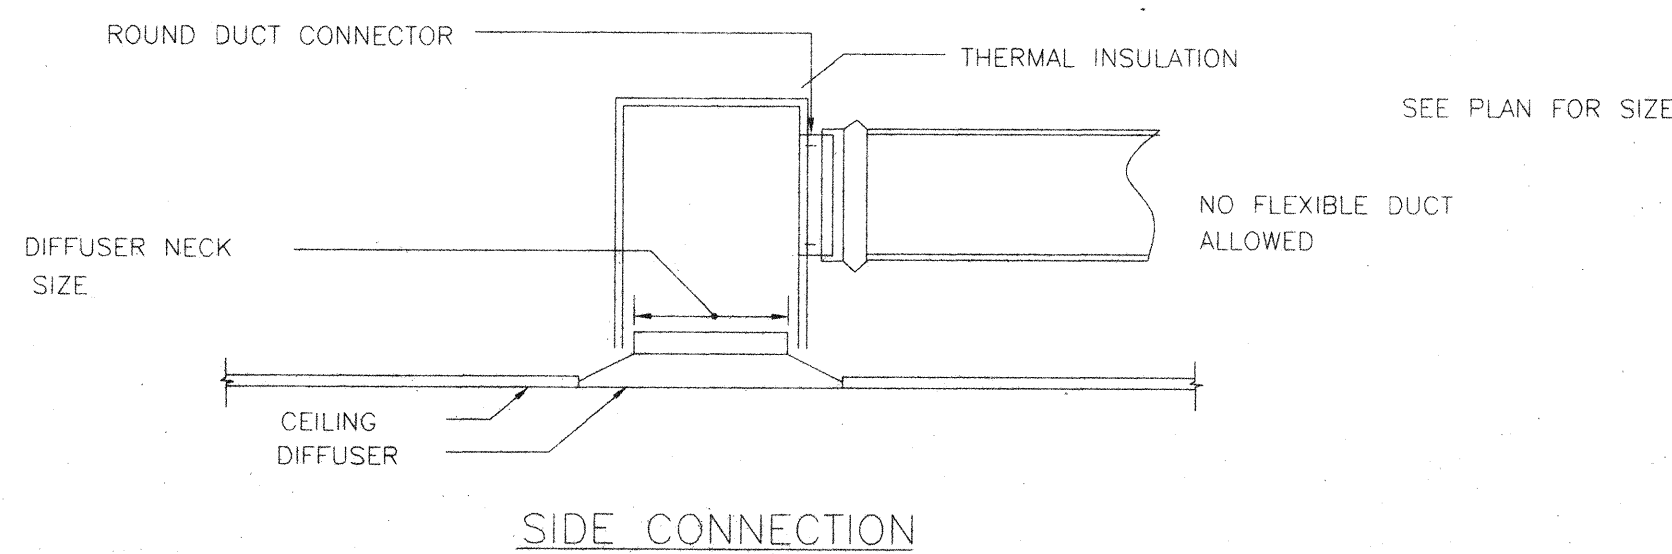

- NOTES:
1. MAXIMUM UNSUPPORTED VANE LENGTH 36"
 2. VANES AND FRAMES - 24 GAUGE
 3. DUCT INLET AND OUTLET DIMENSIONS TO BE EQUAL
 4. FOR HIGH VELOCITY (1500 FPM AND ABOVE) APPLICATIONS PROVIDE 18 GAUGE CHANNEL AND TACK WELD VANE EDGES TO CHANNEL, TYPICAL BOTH ENDS
 5. FRAMES AND CHANNELS - BOLTED OR TACK WELDED TO ELBOW

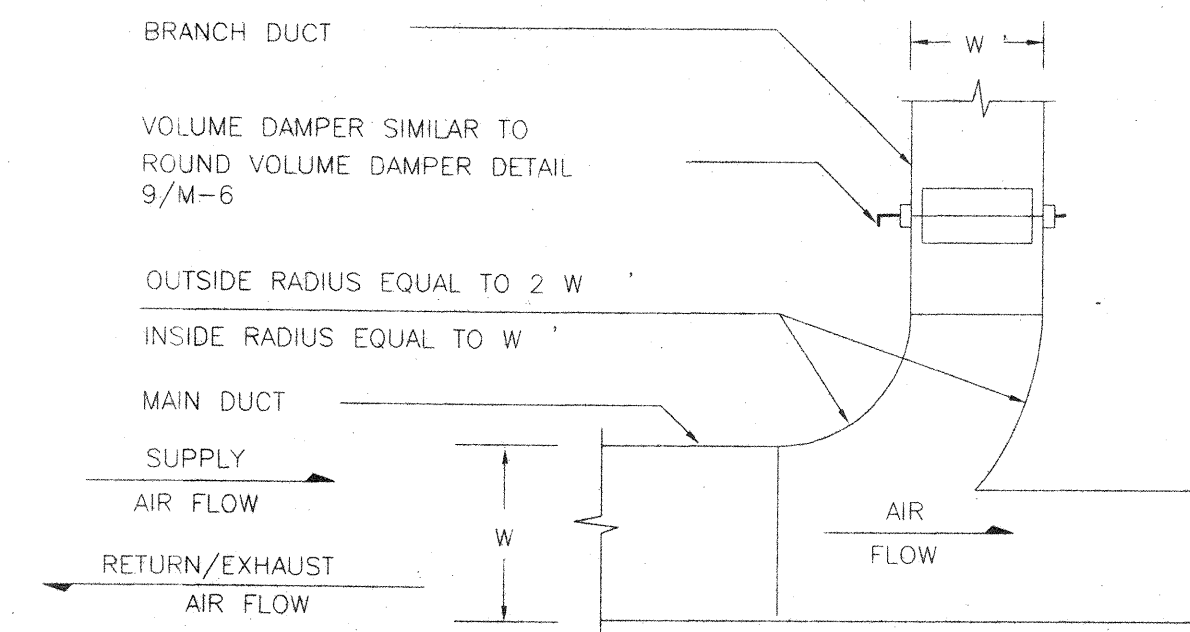


- NOTES
1. USE FOR SYMBOL $\perp$ WHERE BRANCH DUCT AIR QUANTITY IS MORE THAN 25% AND LESS THAN 50% OF THE TOTAL AIR FLOW.
 2. DEPTH OF DUCT FOR W AND W/2 SHOULD BE EQUAL.

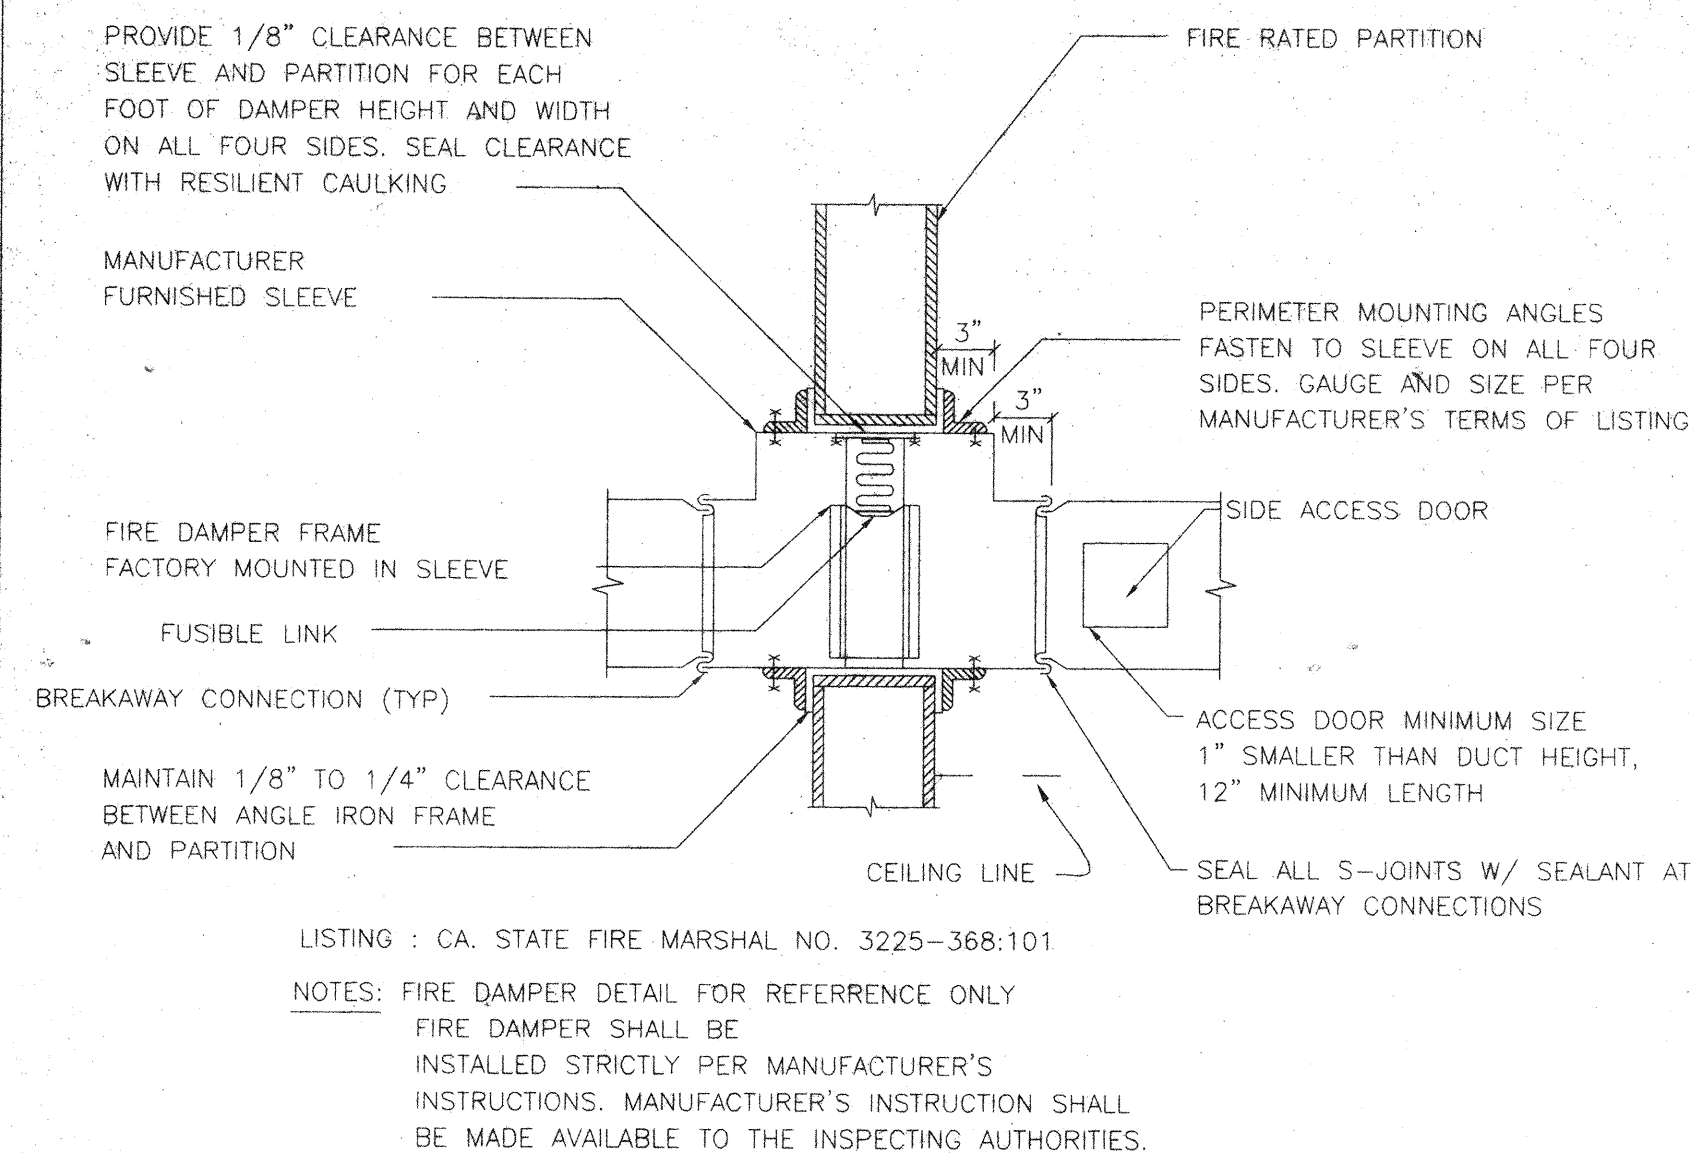


- LISTING : CA. STATE FIRE MARSHAL NO. 3225-368-101
- NOTES: FIRE DAMPER DETAIL FOR REFERENCE ONLY
FIRE DAMPER SHALL BE
INSTALLED STRICTLY PER MANUFACTURER'S
INSTRUCTIONS. MANUFACTURER'S INSTRUCTION SHALL
BE MADE AVAILABLE TO THE INSPECTING AUTHORITIES.

FOR MECH. ROOM WEST CAMPUS, BUILDING 'N'

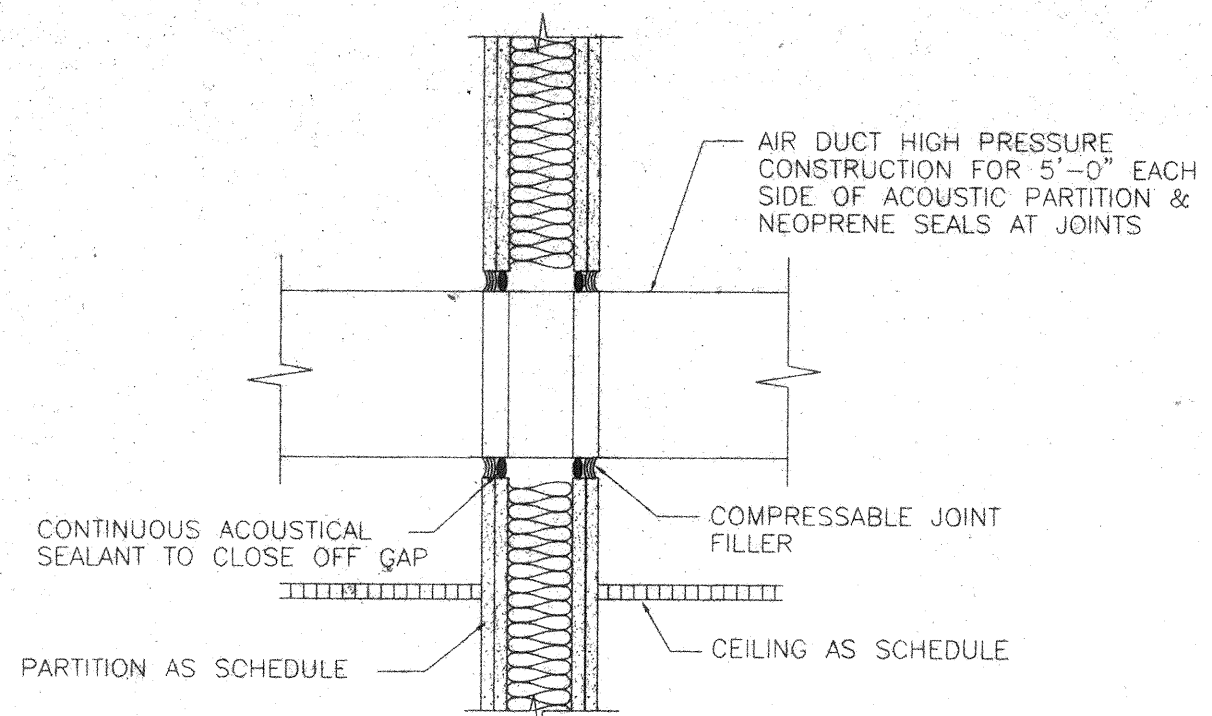

PENETRATION OF ACOUSTICAL PARTITIONS BY DUCTWORK SHALL BE ACOUSTICALLY SEALED AS SHOWN. ANY GAP LARGER THAN 1/2" SHALL BE COVERED WITH GYPSUM BOARD, LAPPED A MINIMUM OF 2" AND SCREWED BEFORE USING ACOUSTICAL SEALANT.

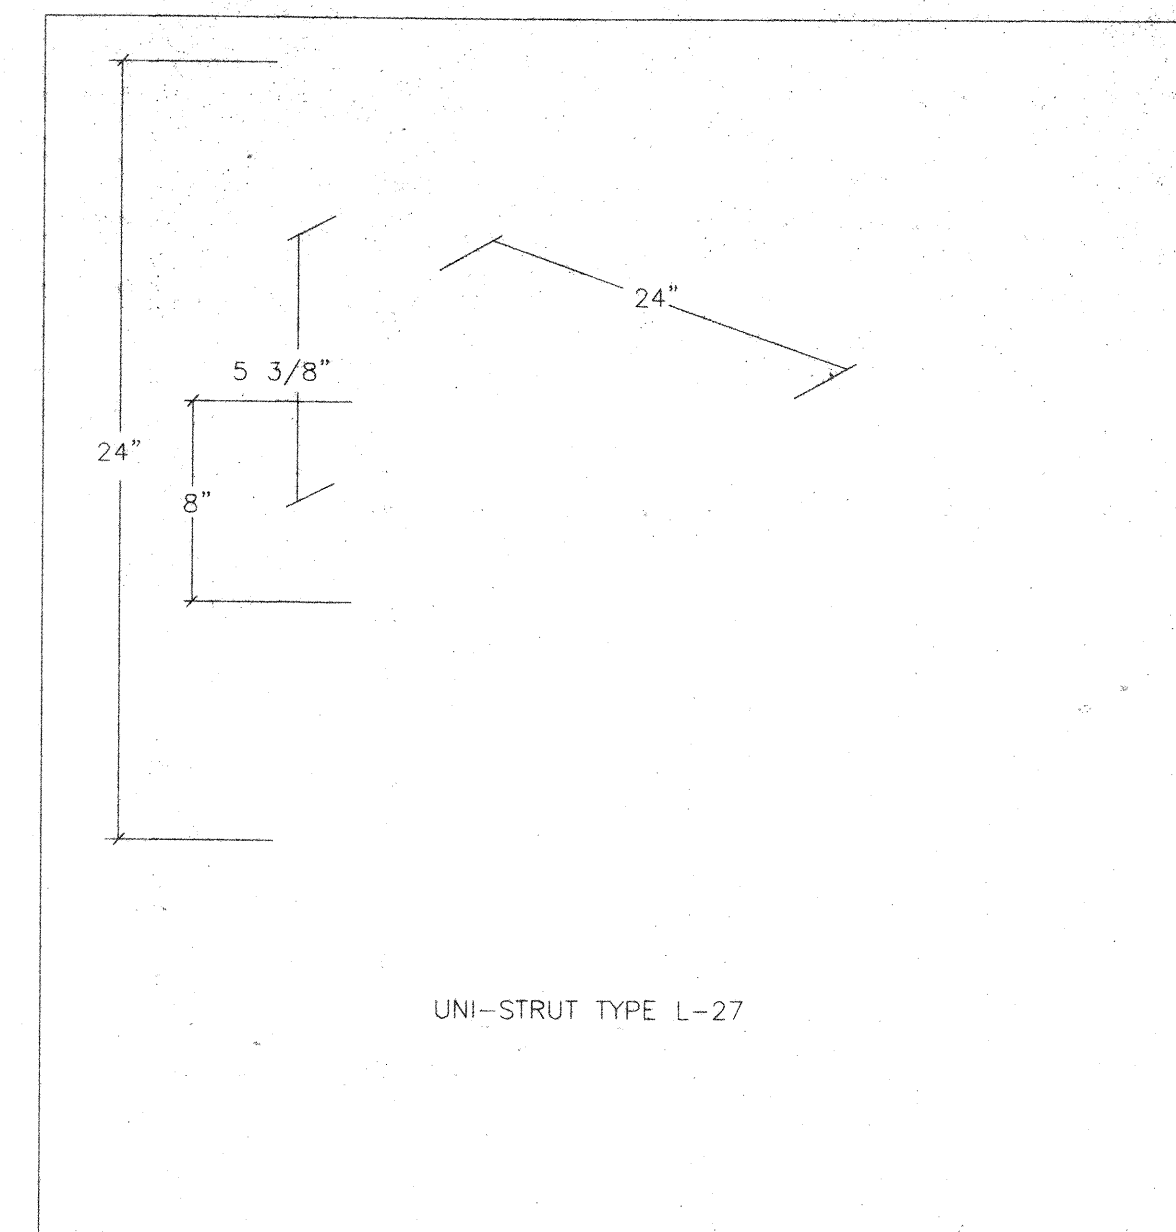

Architecture, Planning, Consult
511 Mission Street
South Pasadena, CA 9103
tel 626.799.9920
fax 626.799.8260
e-mail: info@onuma.co


Consultants

DEBIBI & ROSHANIAN INC.
MECHANICAL & ELECTRICAL ENGINEERS
10000 Wilshire Blvd., Suite 202
North Hollywood, CA 91607
TEL: (818) 990-0837
FAX: (818) 508-1251

AS BUILT

REMODEL
FOR
SAINT EDMUND'S
EPISCOPAL CHURCH
1175 SAN CARLOS BLVD. SAN MARINO, CA 91108-R04R

STAMPS

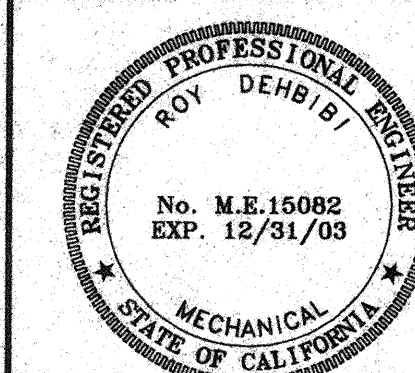

REVISIONS

DESCRIPTION	DATE

PROJECT NUMBER 200

SCALE AS NOTE

PRINTED 01/18/01

TITLE

SHEET

**Wittler
Young /co.
inc.**
AS BUILT
DATE: 04/15/2001

M-3
OF