


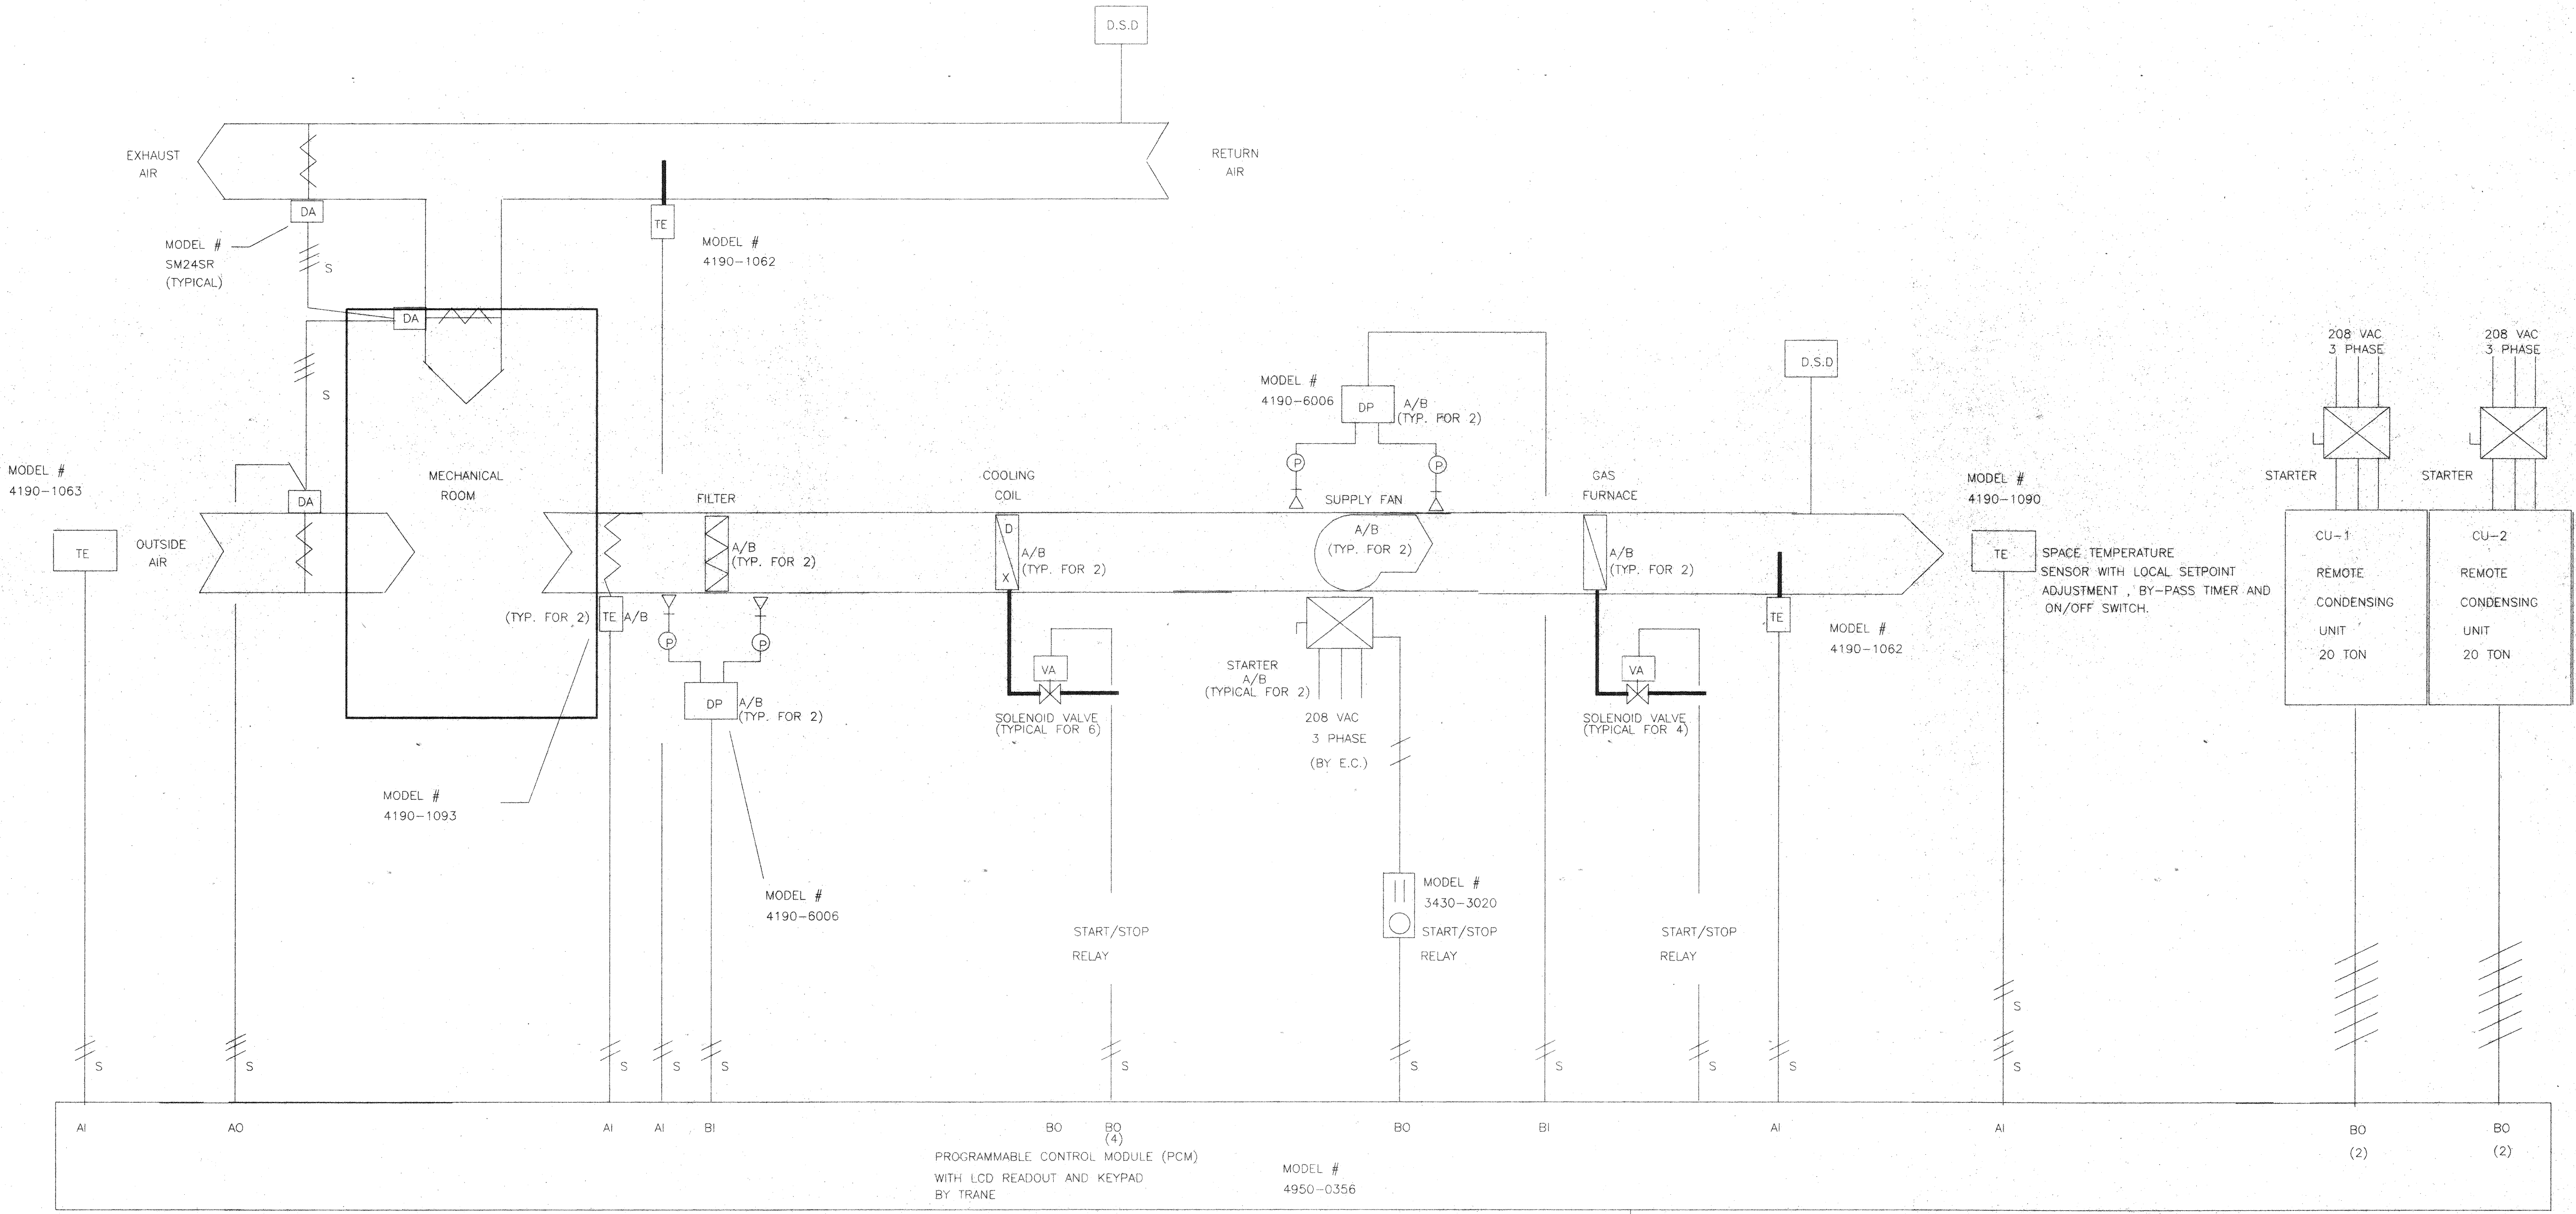

NOTES:

1. ALL WIRING TO CONFORM TO NEC CODES.
2. S - DENOTES SHIELDED CABLE.
3. CONTROL PANEL BY TRANE.
4. ALL CONTROLS BY MECH CONTRACTOR INCLUDING SHIELDED CABLES. ELECTRICAL CONNECTION BY ELEC. CONTRACTOR.
5. SMOKE DETECTOR WIRING TO CENTRAL FIRE ALARM SYSTEM BY SAFETY & CONTRACTOR WIRING TO T-STAT WIRE INTRUPTION BY M.C.
6. THE PANEL AND SENSORS, WIRING ALL BY MECHANICAL CONTRACTOR STARTERS AND HIGH VOLTAGE WIRING BY ELECTRICAL CONTRACTOR.

LEGEND:

- BCU = BUILDING CONTROL UNIT
PCM = PROGRAMMABLE CONTROL MODULE
UCM = UNIT CONTROL MODULE
UPCM = UNIVERSAL PROGRAMMABLE CONTROL MODULE
TE = TEMPERATURE SENSING ELEMENT
TCM = THERMOSTAT CONTROL MODULE
SPT = STATIC PRESSURE TIP
HE = HUMIDITY SENSOR
CO2 = CARBON DIOXIDE SENSOR
DA = DAMPER ACTUATOR
VA = VALVE
DP = DIFFERENTIAL PRESSURE SWITCH
S/S = START/STOP
FT = AIRFLOW TRANSDUCER (CFM)
RTAA = AIR COOLED HELICAL ROTARY CHILLER
CSS = CURRENT SENSING SWITCH
CSS/R = COMBINATION CURRENT SENSING SWITCH AND RELAY
IGV = INLET GUIDE VANE
PET = PRESSURE TO ELECTRIC TRANSDUCER
D.S.D. = DUCT SMOKE DETECTOR
- BI = BINARY INPUT
BO = BINARY OUTPUT
AI = ANALOG INPUT
AO = ANALOG OUTPUT

- #18 TWISTED SHIELDED 2-CONDUCTOR CABLE
S PNEUMATIC TUBING
E ELECTRICAL CONTRACTOR

120 VAC (BY E.C.)

MECHANICAL ROOM PANEL CONTROL DIAGRAM

Wittler Young Inc.
AS BUILT
DATE: 04/15/2001