


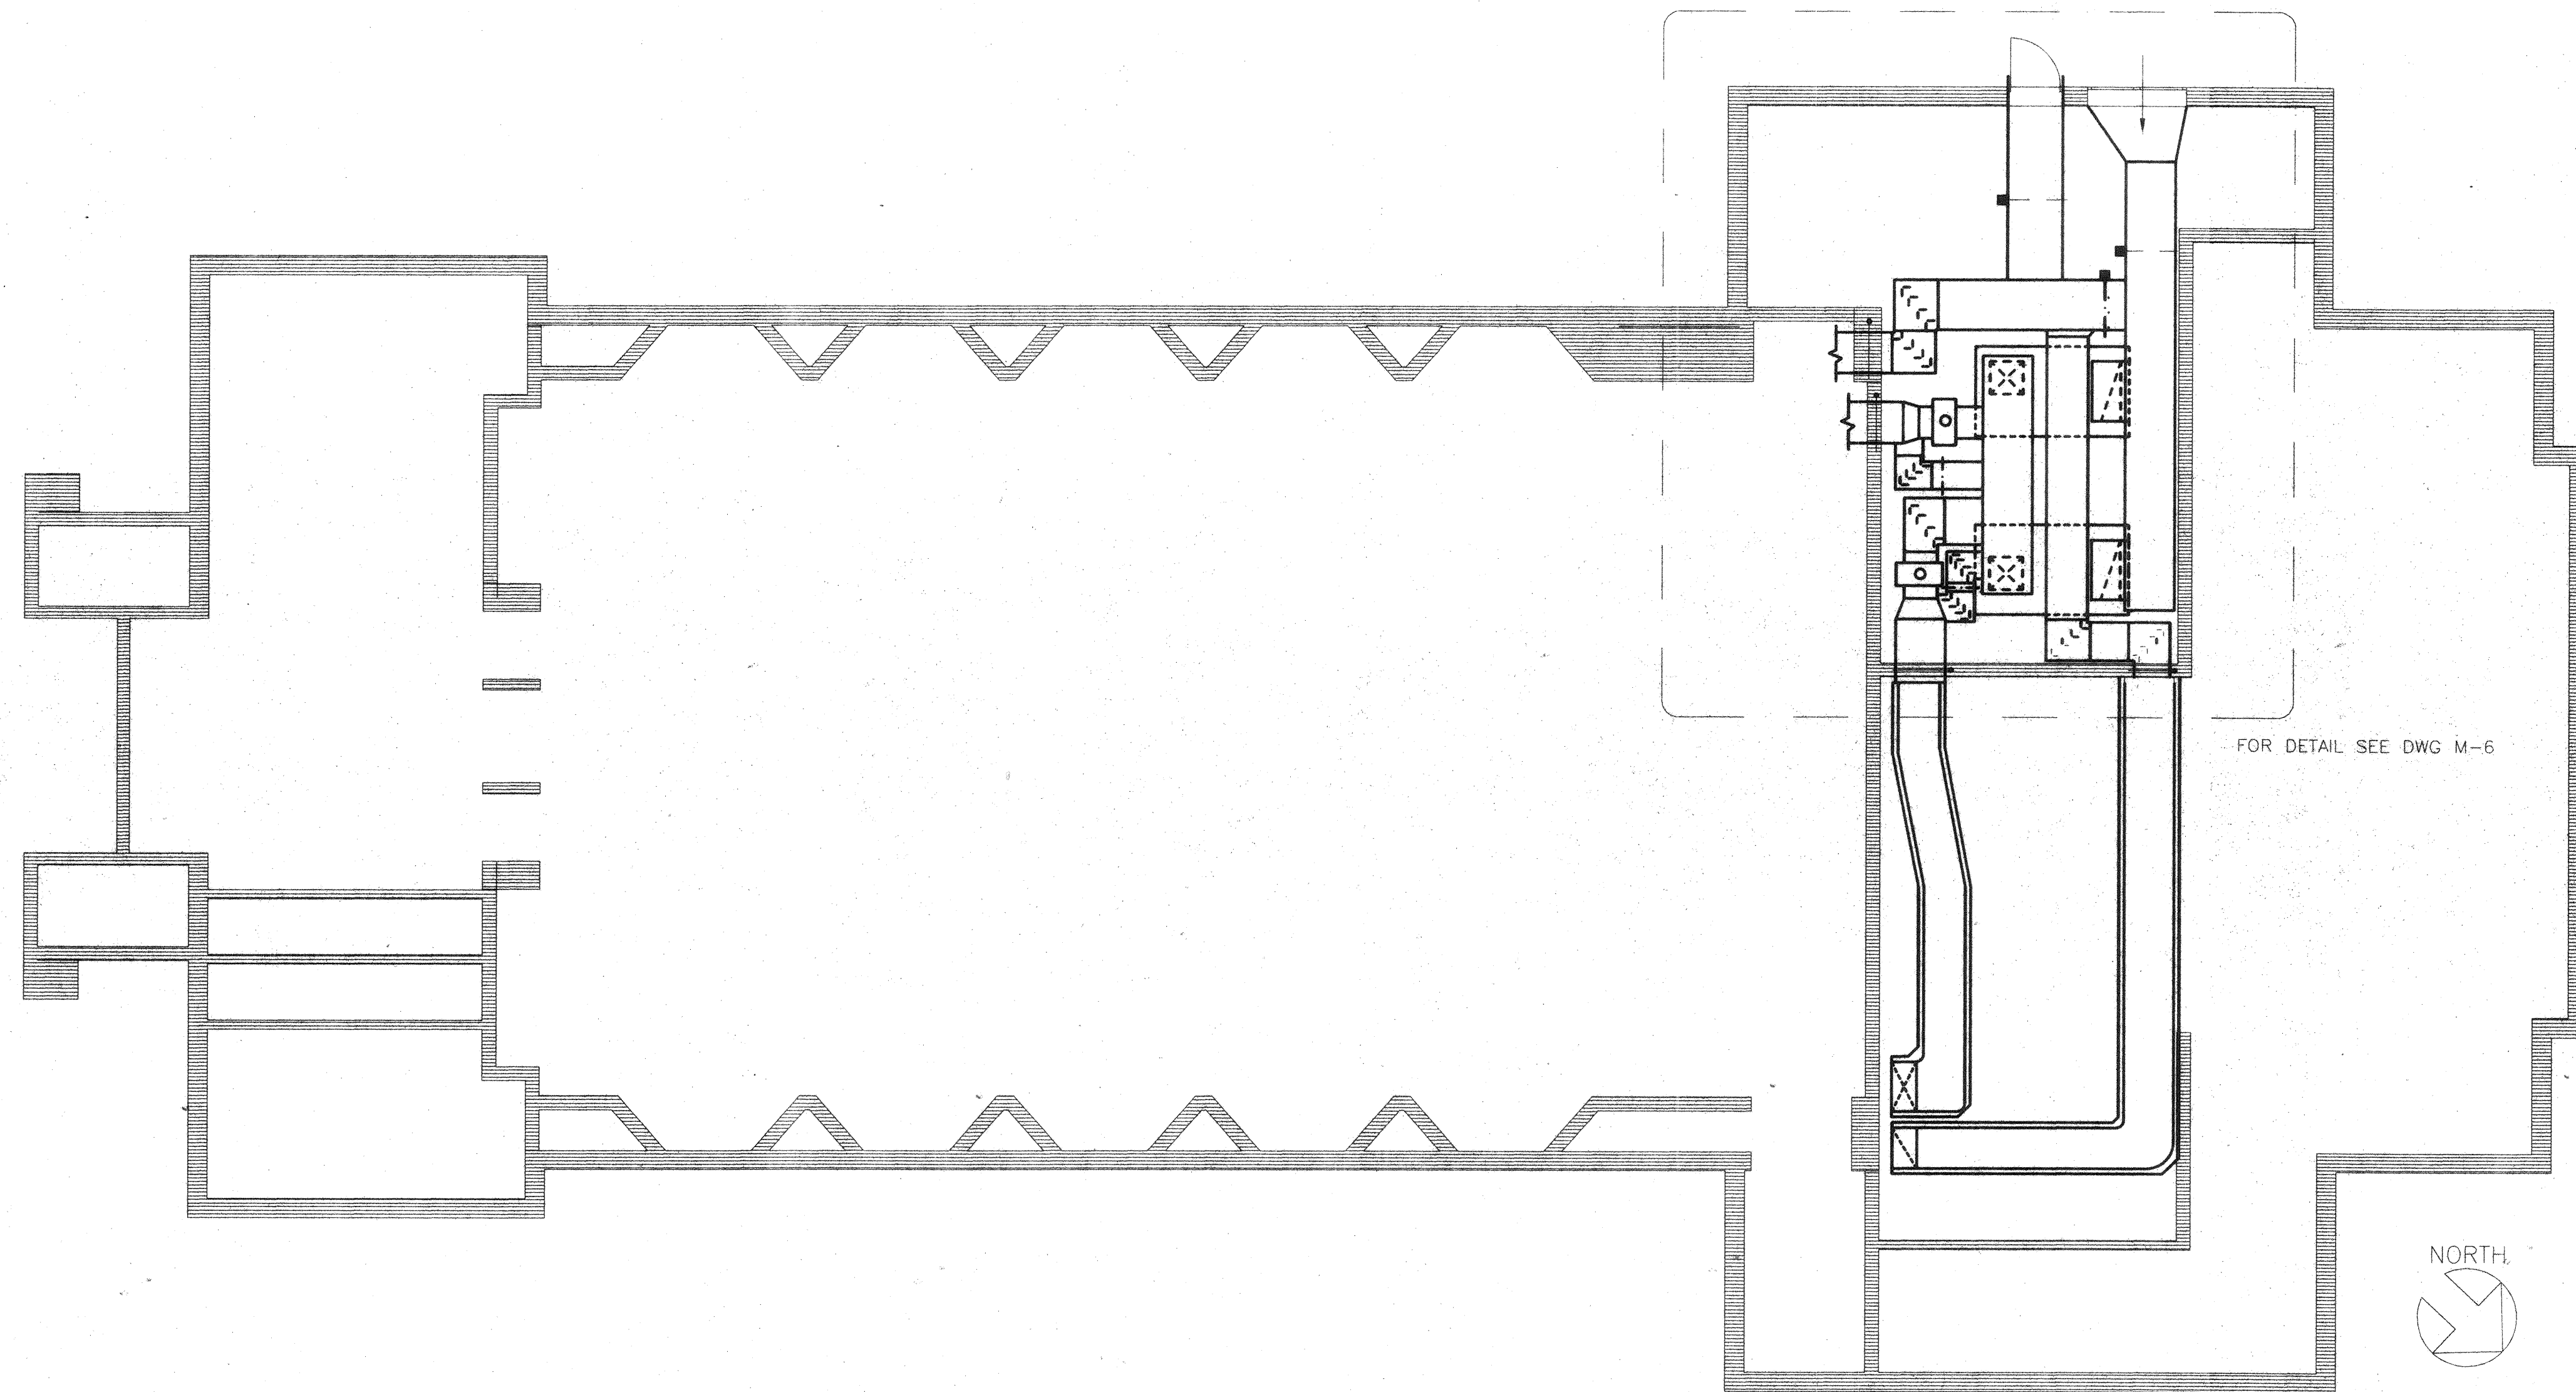

BASEMENT AIR CONDITIONING PLAN

SCALE: 1/8"=1'-0"


Onuma & Associates
 Architecture, Planning, Consult.
 511 Mission Street
 South Pasadena, CA 9103
 tel 626.799.9920
 fax 626.799.8260
 e-mail: info@onuma.co

Consultants

DEBIBI & ROSHANIAN INC.
 MECHANICAL & ELECTRICAL ENGINEERS
 1175 SAN GABRIEL BLVD., Suite 202
 North Hollywood, CA 91607
 TEL: (818) 980-0837
 FAX: (818) 980-1251

REMODEL
 FOR
 SAINT EDMUND'S
 EPISCOPAL CHURCH
 1175 SAN GABRIEL BLVD SAN MARINO CA 91108-R04R

STAMPS

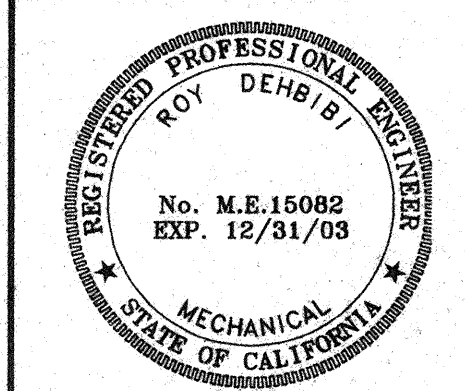

REVISIONS

DESCRIPTION	DATE

PROJECT NUMBER 2000

SCALE AS NOTE


PRINTED 01/18/01

TITLE
 BASEMENT A/C
 PLAN
 SHEET

M-5
 OF

PLAN NOTES:

- 01 EXISTING 12"Ø FLUE THRU ROOF TO BE CLEANED.
- 02 DO NOT TOUCH EXISTING DUCT SYSTEM RELATED TO MUSICAL INSTRUMENT.
- 03 EXISTING MUSICAL INSTRUMENT SYSTEM TO REMAIN.
- 04 REMOVE ALL EXISTING H/V DUCT SYSTEM AND RELATED EQUIPMENTS.
- 05 CLEAN UNDER STAGE DUCT USE VACUUM PUMP TO PROCEED 5" NEGATIVE STATIC PRESSURE.

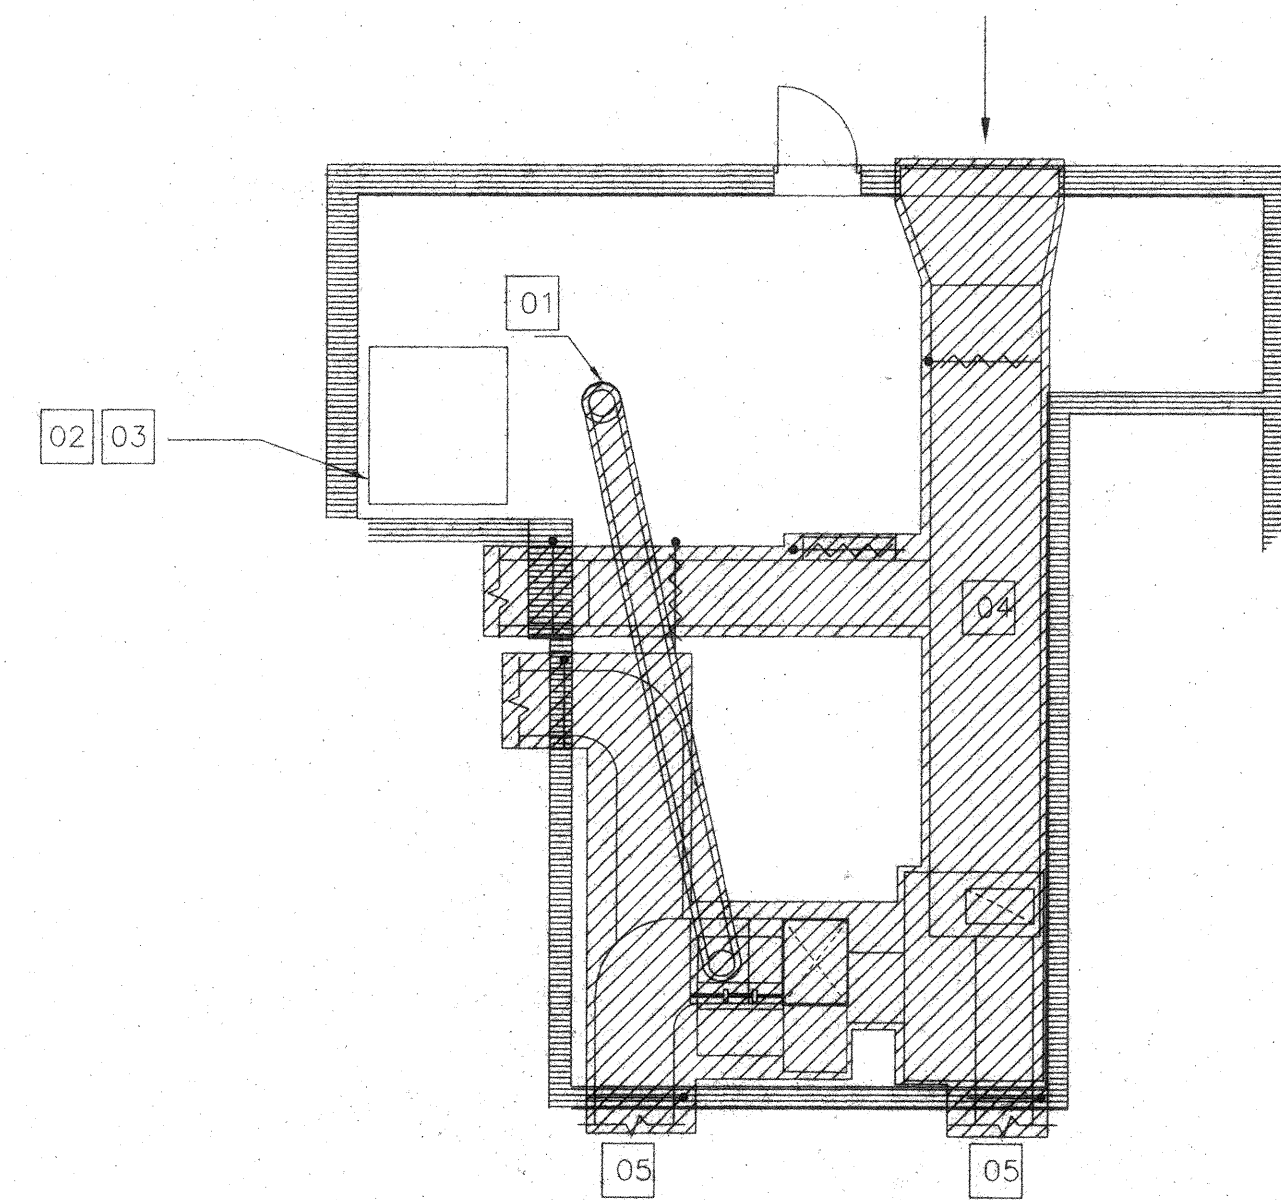

BASEMENT AIR CONDITIONING DEMOLITION PLAN

SCALE: 1/8"=1'-0"

**Wittler
 Young /co.
 Inc.**
AS BUILT
 DATE: 04/15/2001