



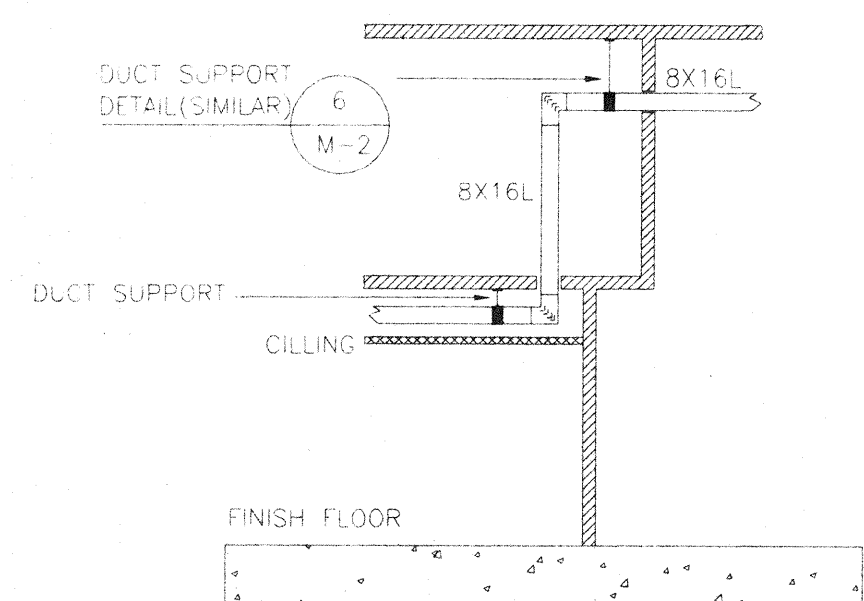


SECTION
NOT TO SCALE

B
M-7

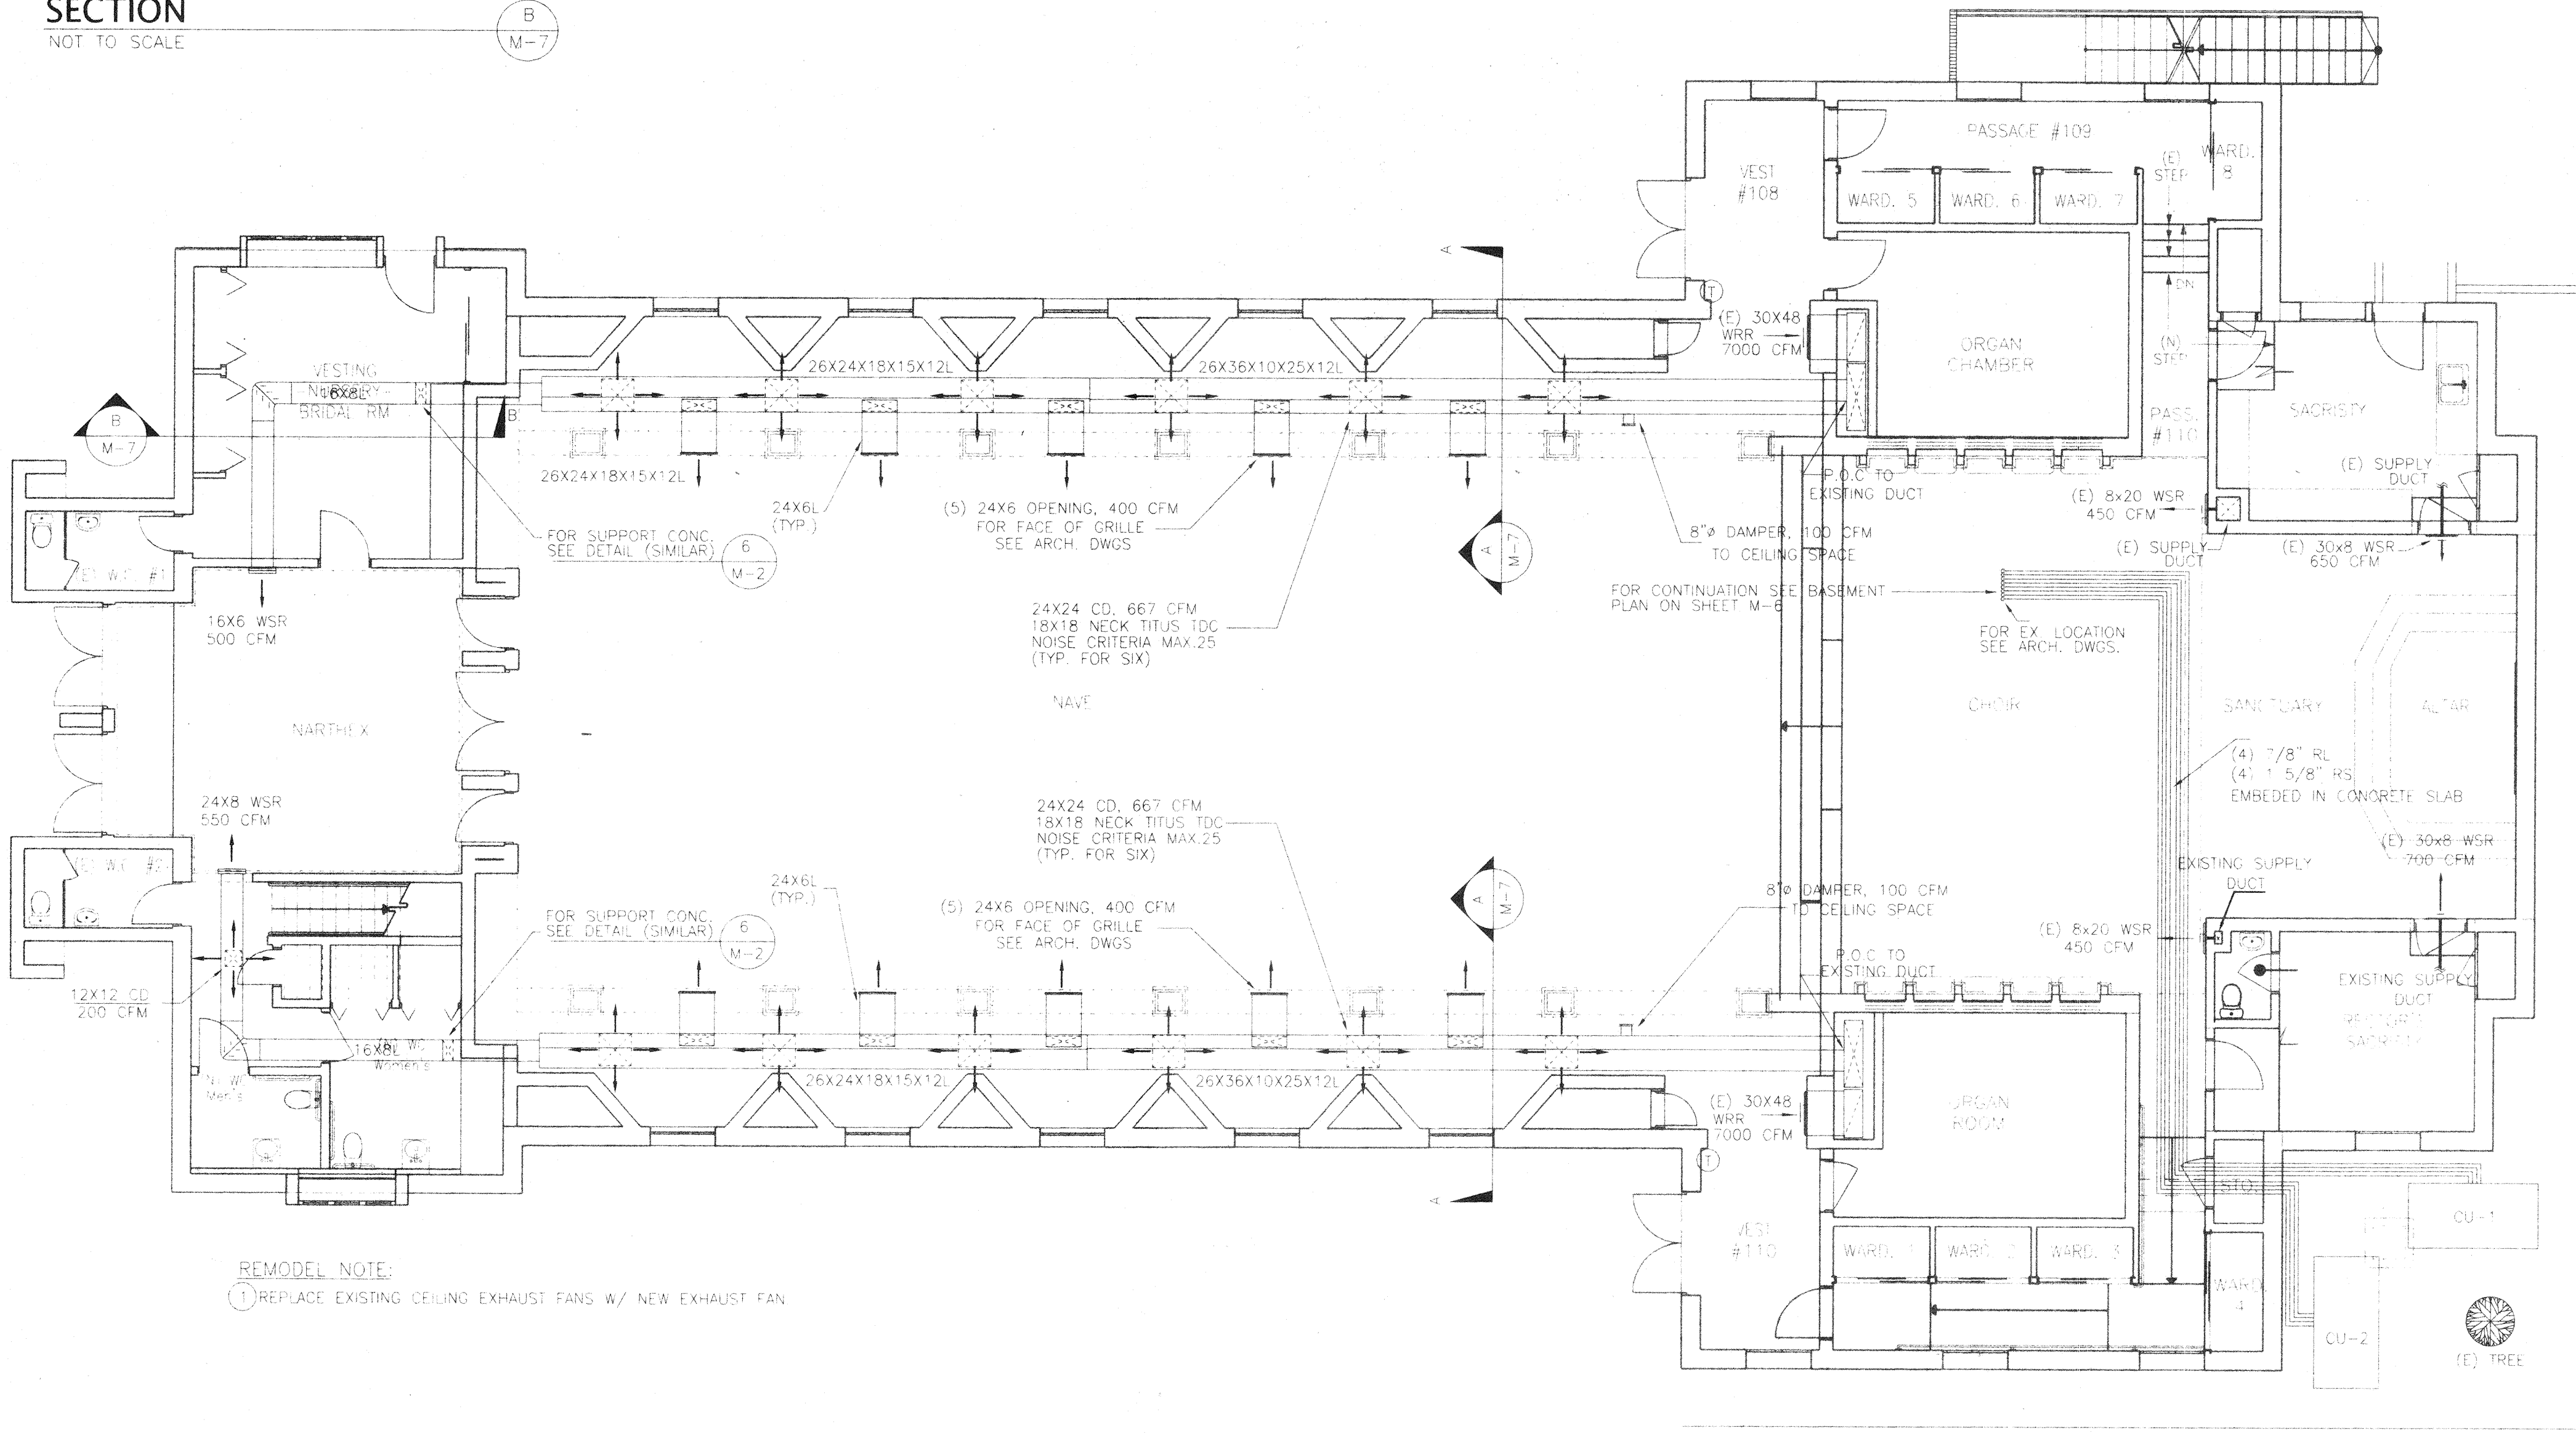


FIRST FLOOR AIR CONDITIONING PLAN

SCALE: 1/8"=1'-0"

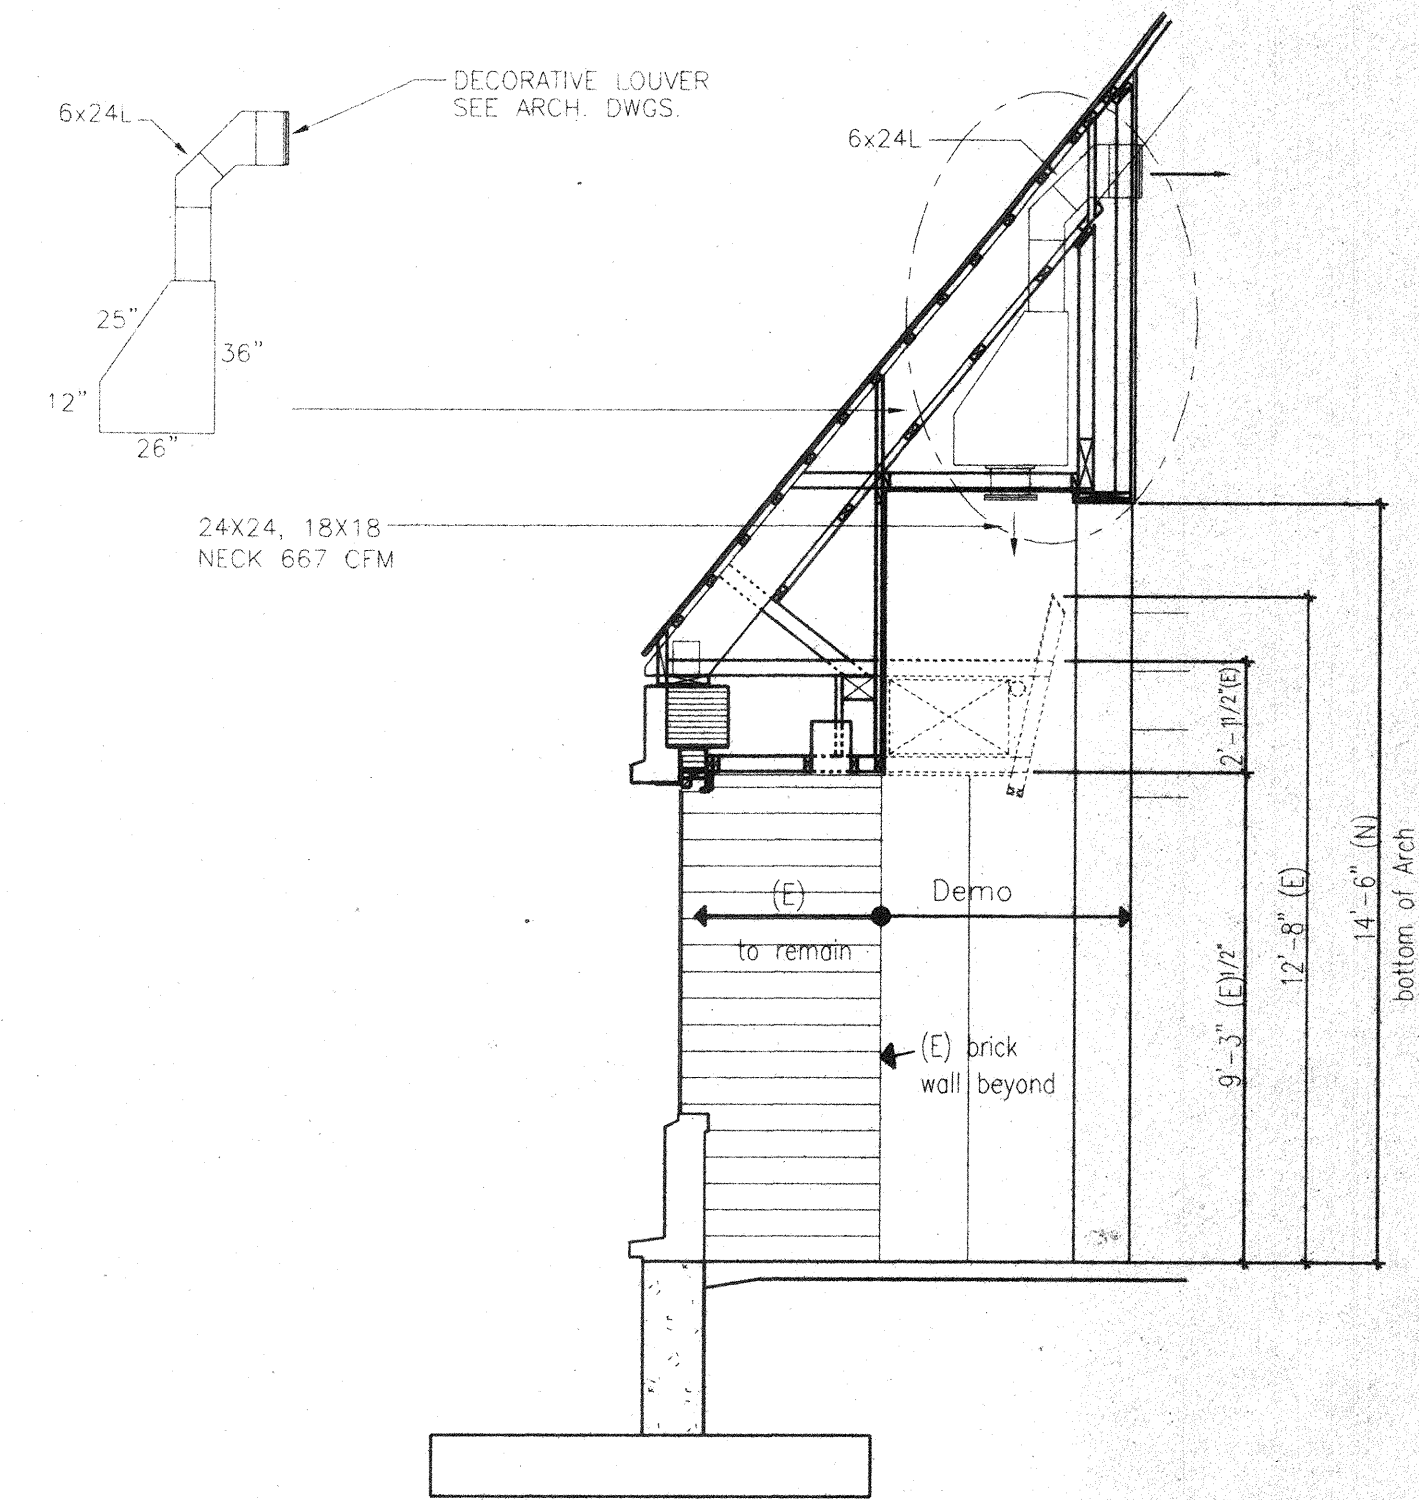

SECTION
1/8"=1'-0"

A
M-7

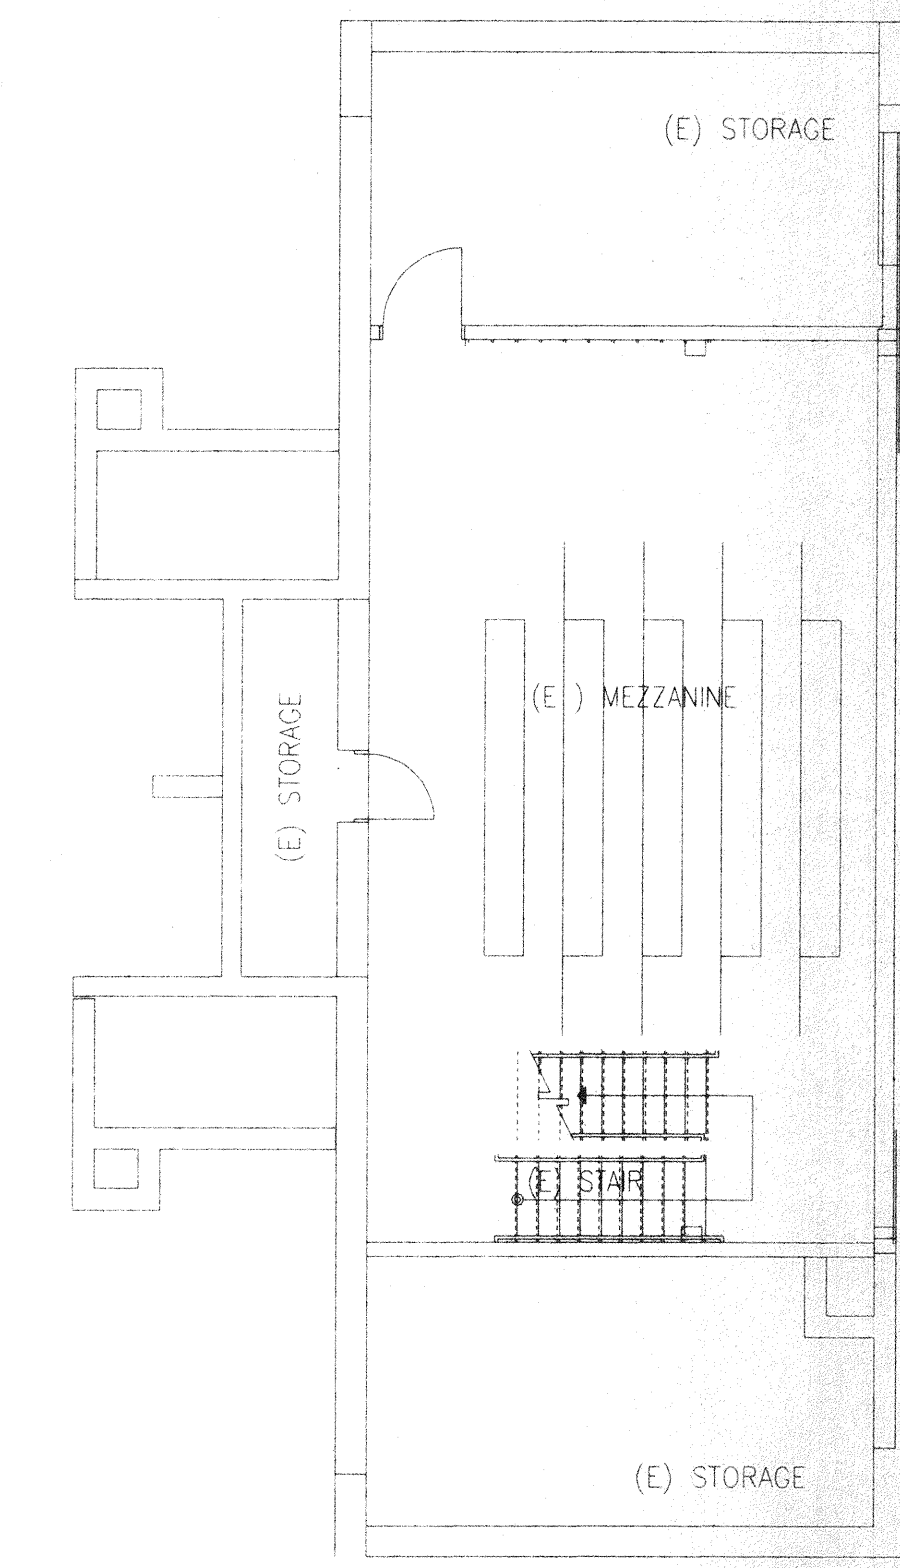

MEZANINE FLOOR PLAN
1/8"=1'-0"

Wittler Young & Co. Inc.
AS BUILT
DATE: 04/15/2001


Onuma & Associates
Architecture, Planning, Consult
511 Mission Street
South Pasadena, CA 91030
tel 626.799.9920
fax 626.799.8260
e-mail: info@onuma.cc

Consultants

DEBIBI & ROSHANIAN INC.
MECHANICAL & ELECTRICAL ENGINEERS
North Hollywood, CA 91607
TEL: (818) 980-0837
FAX: (818) 980-1151

REMODEL
FOR
SAINT EDMUND'S
EPISCOPAL CHURCH
1175 SAN CARLOS BLVD SAN MARINO CA 91108-0018

STAMPS

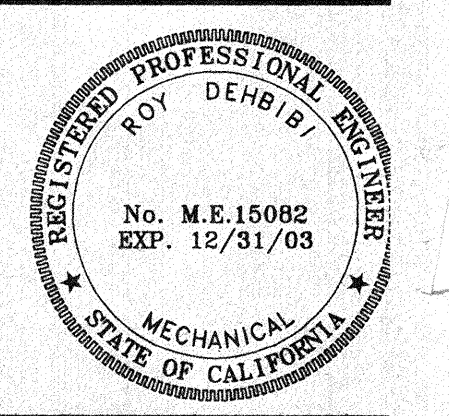

REVISIONS

DESCRIPTION	DATE

PROJECT NUMBER
200

SCALE AS NOTE

PRINTED 01/18/

TITLE 1st

FLOOR A/C PLAN

SHEET

M-7
OF