



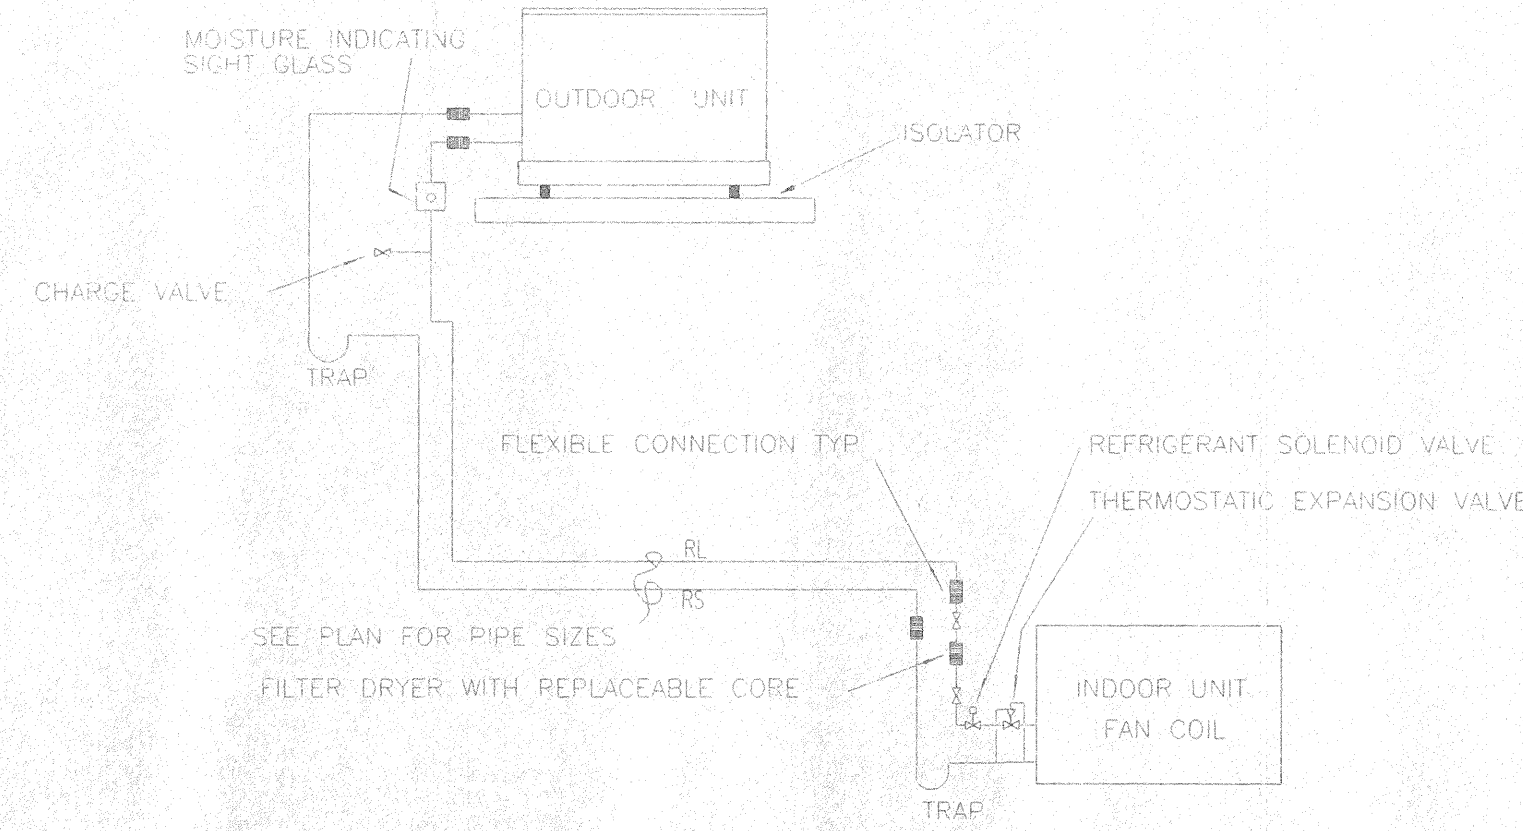


TYPICAL REFRIGERATE PIPING DIAGRAM

N.T.S. 2

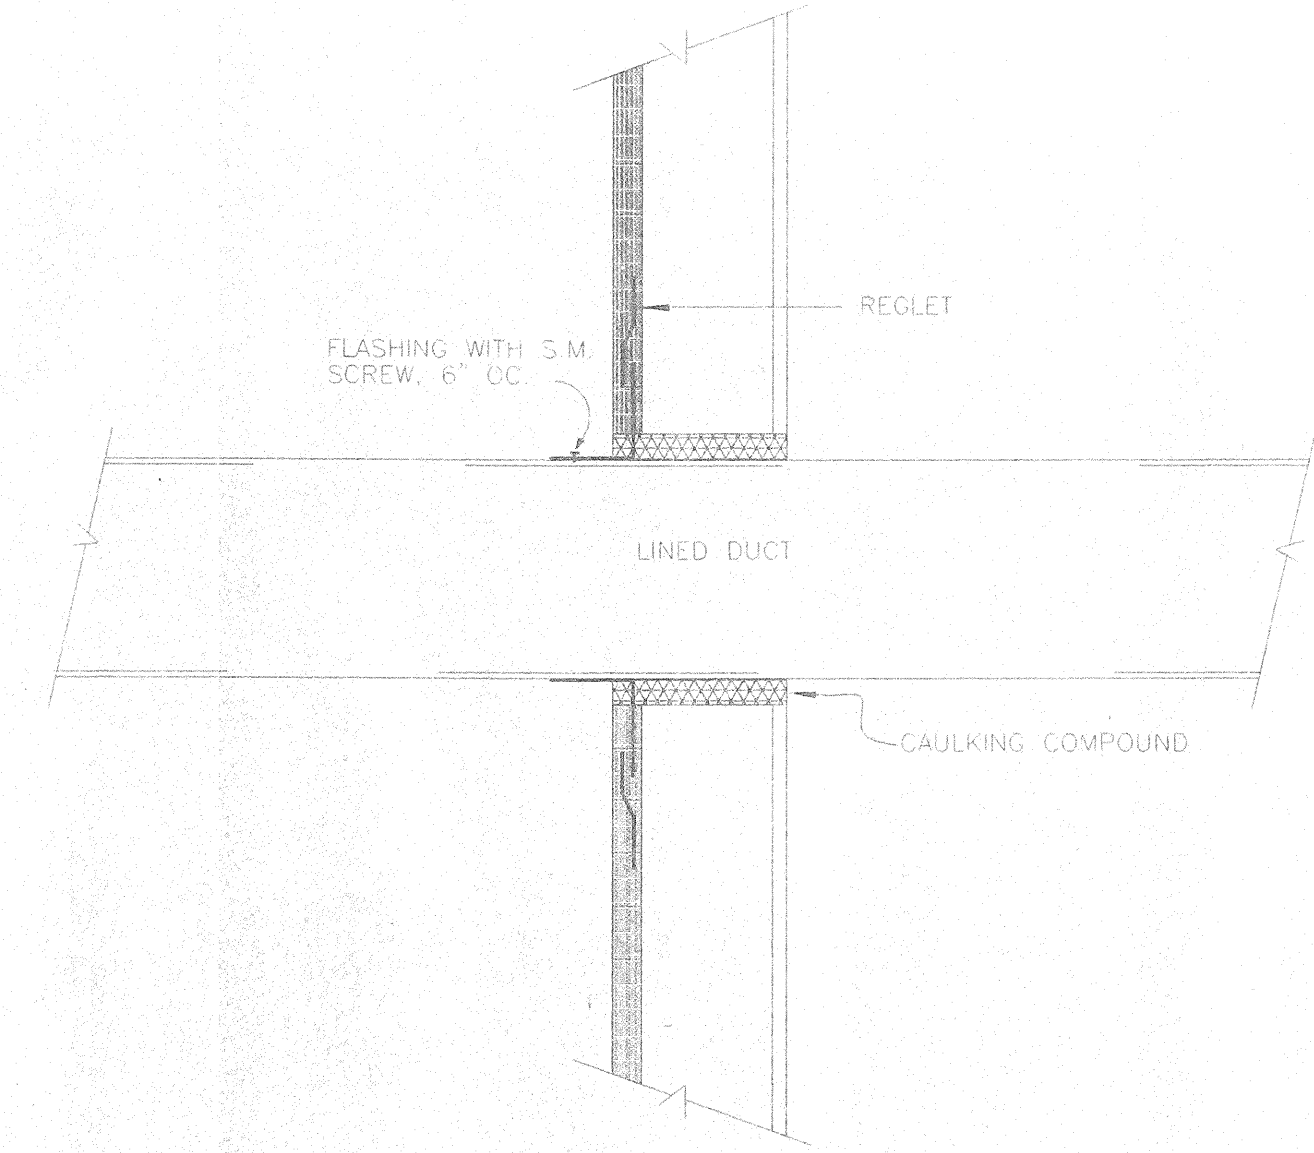

DUCT THRU EXTERIOR WALL


N.T.S. 3

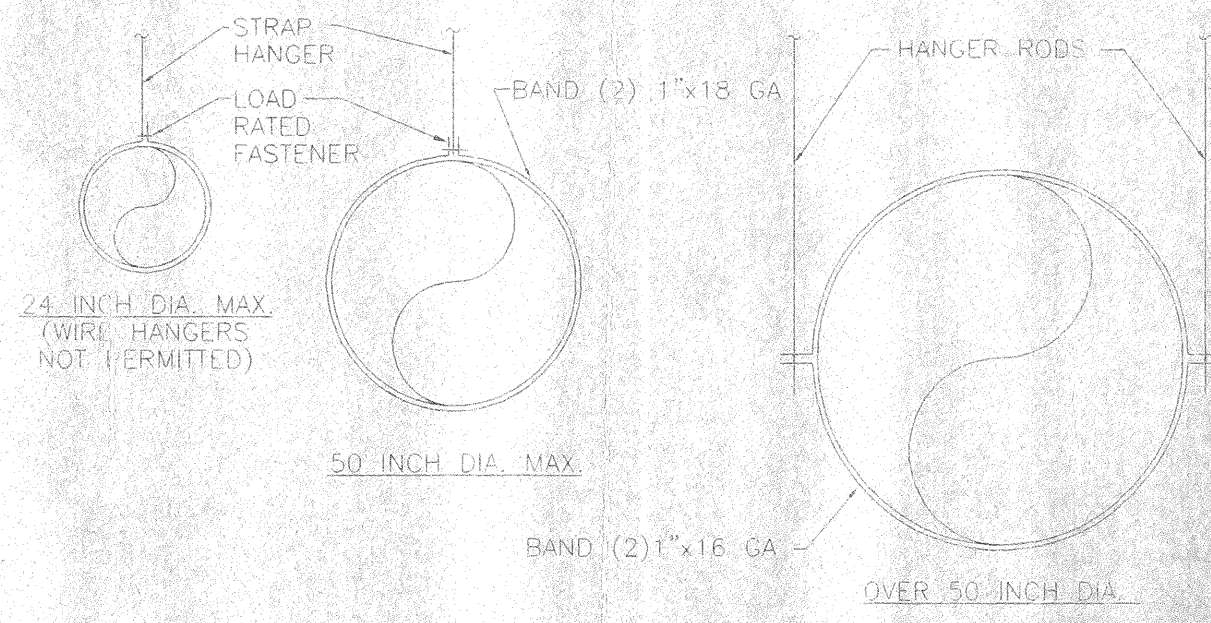

- NOTES:
- FOR HANGER SIZE AND SPACING, SEE SMACNA HVAC DUCT CONSTRUCTION STANDARDS TABLE 4-2.
 - FOR UPPER ATTACHMENT TO BUILDING, SEE SMACNA HVAC DUCT CONSTRUCTION STANDARDS FIG. 4-1 AND FIG. 4-2, WITH SPECIFIC BUILDING STRUCTURAL ENGINEER APPROVAL.
 - FOR BRACING AND OTHER SEISMIC REQUIREMENTS, SEE GUIDELINES FOR SEISMIC RESTRAINTS OF MECHANICAL SYSTEMS AND PLUMBING PIPING SYSTEMS PUBLISHED BY SMACNA AND PPIC. ALSO REFER TO NATIONAL UNIFORM SEISMIC INSTALLATION GUIDELINES (NUSIG) 1991.


TYPICAL HORIZONTAL ROUND DUCT SUPPORTS

N.T.S. 4

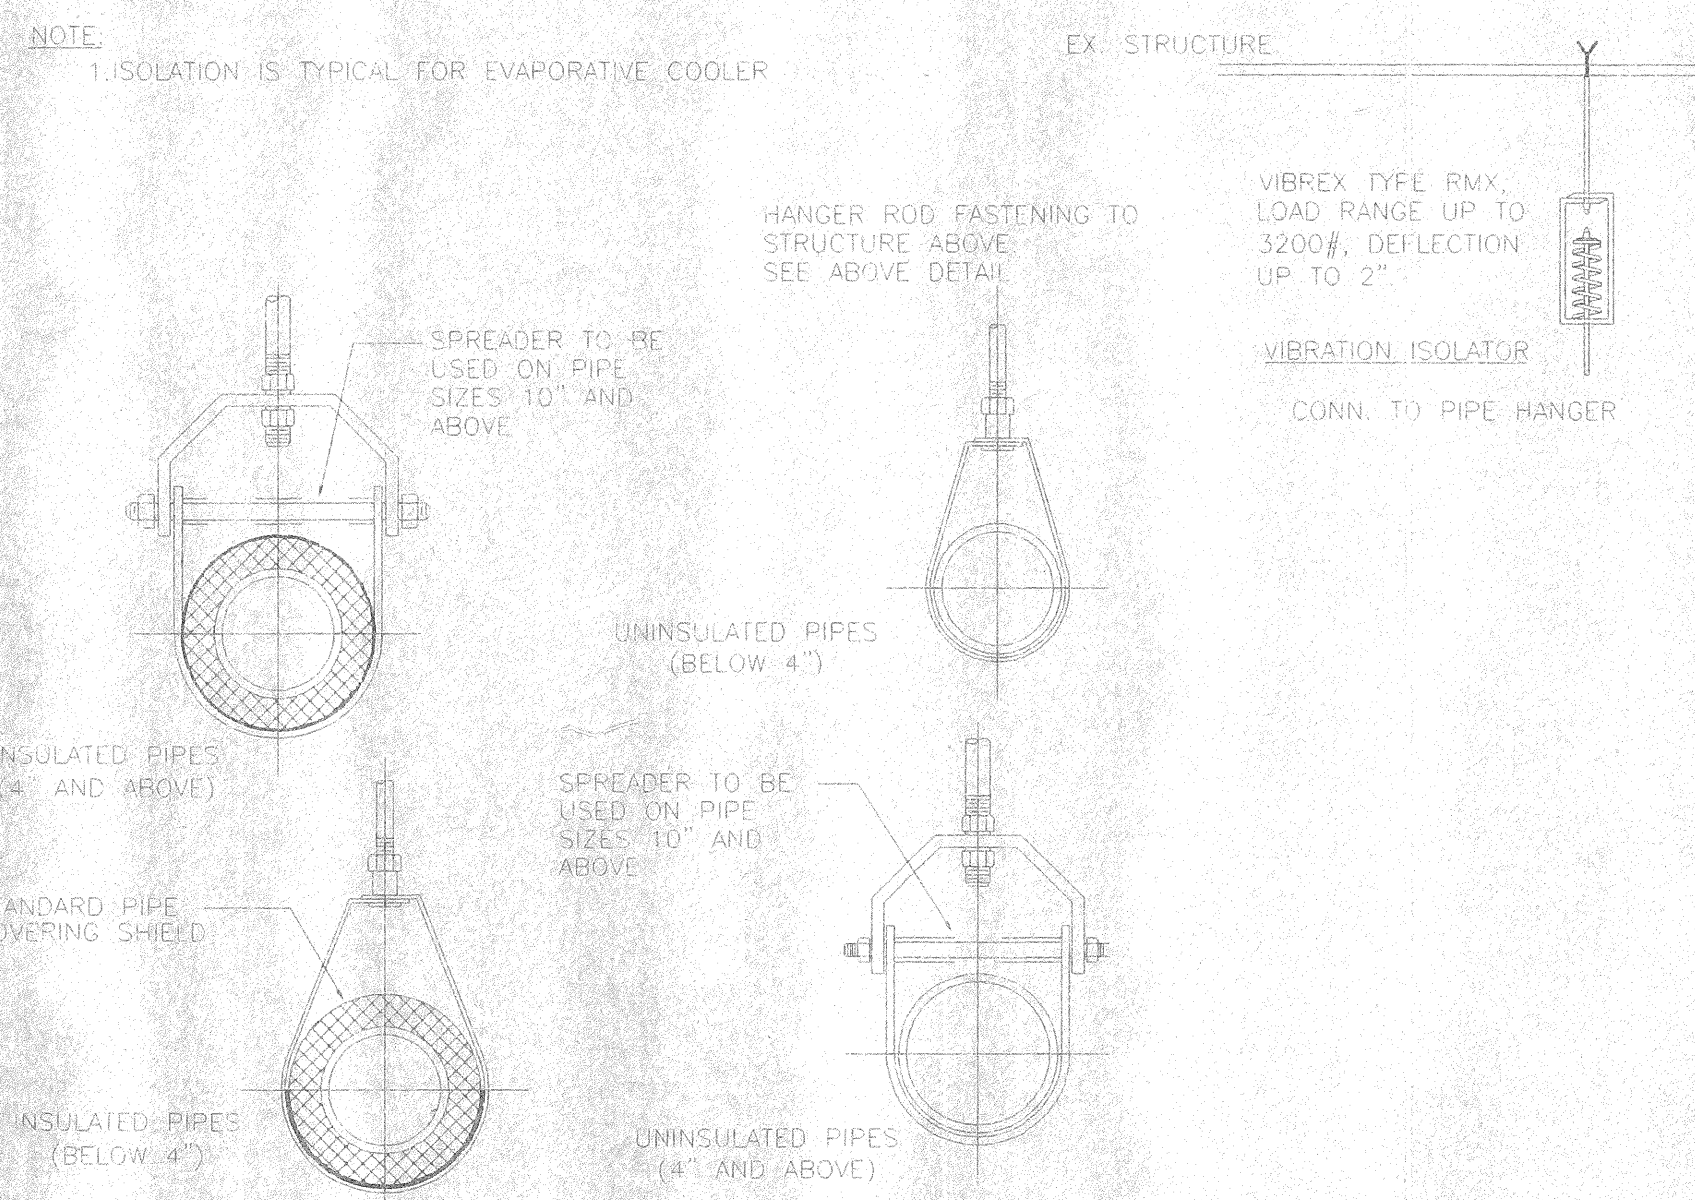

TYPICAL PIPE HANGER DETAIL


N.T.S. 5

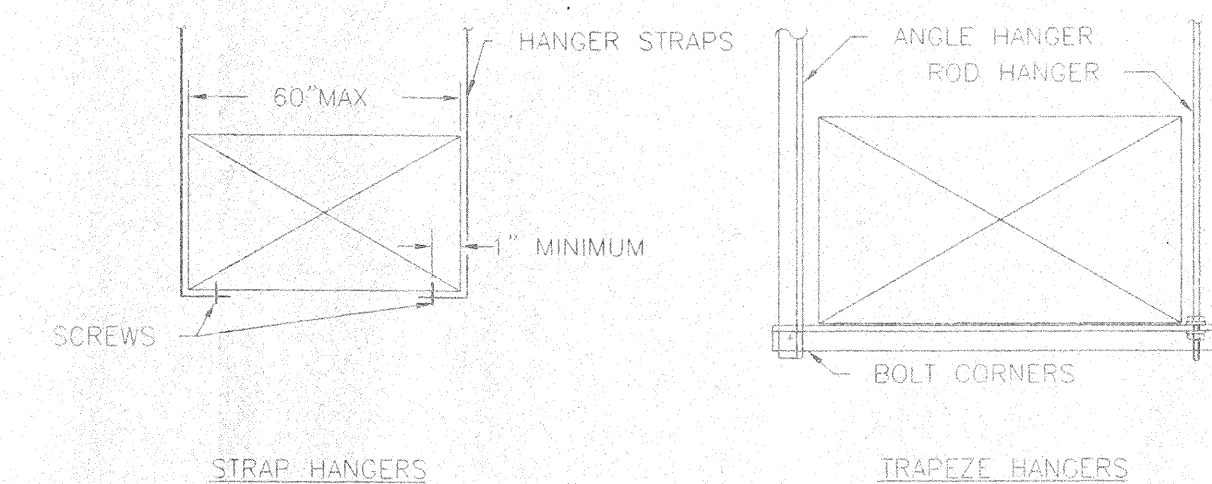

- NOTE:
- FOR HANGERS SIZE AND SPACING, SEE SMACNA HVAC DUCT CONSTRUCTION STANDARDS TABLE 4-1.
 - FOR UPPER ATTACHMENT TO BUILDING, SEE SMACNA HVAC DUCT CONSTRUCTION STANDARDS FIG. 4-1 & FIG. 4-2, WITH SPECIFIC BUILDING STRUCTURAL ENGINEER APPROVAL.
 - FOR BRACING AND OTHER SEISMIC REQUIREMENTS, SEE GUIDELINES FOR SEISMIC RESTRAINTS OF MECHANICAL SYSTEMS & PLUMBING PIPING SYSTEMS PUBLISHED BY SMACNA AND PPIC AS APPROVED BY OFFICE OF THE CALIFORNIA STATE ARCHITECT 10/31/82, OSHPD PRE-APPROVED R0010. ALSO REFER TO NATIONAL UNIFORM SEISMIC INSTALLATION GUIDELINES (NUSIG) 1991.

TYPICAL HORIZONTAL RECTANGULAR DUCT SUPPORTS


N.T.S. 6

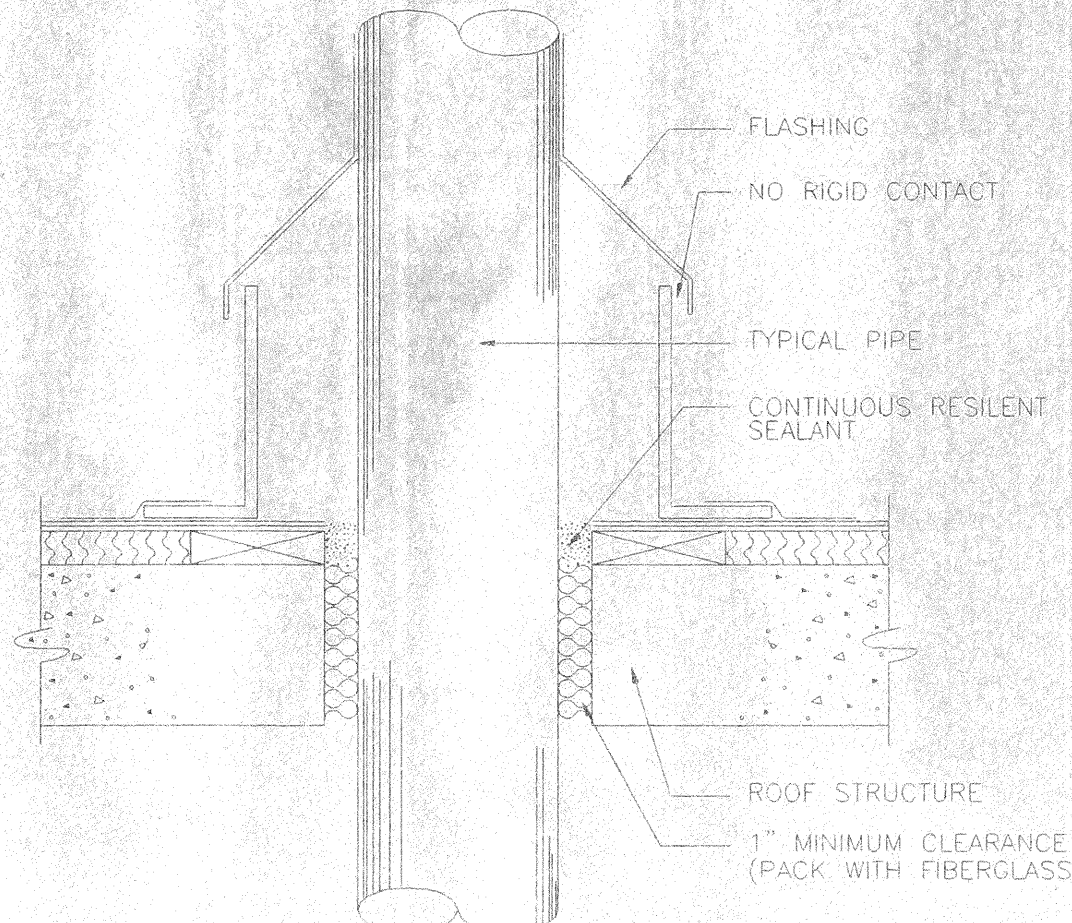

- NOTE:
- FLASHING, COUNTER FLASHING & ROOFING DETAILS ARE SCHEMATIC AND ARE TO INDICATE THE CONCEPT ONLY. SEE ARCHITECTURAL PLANS FOR DETAILS.
 - ALL PENETRATION THRU ROOF SHALL MAINTAIN THE DISTRICT EXISTING WARRANTY OF THE ROOF.


WATERPROOF PENETRATION DETAIL

N.T.S. 7

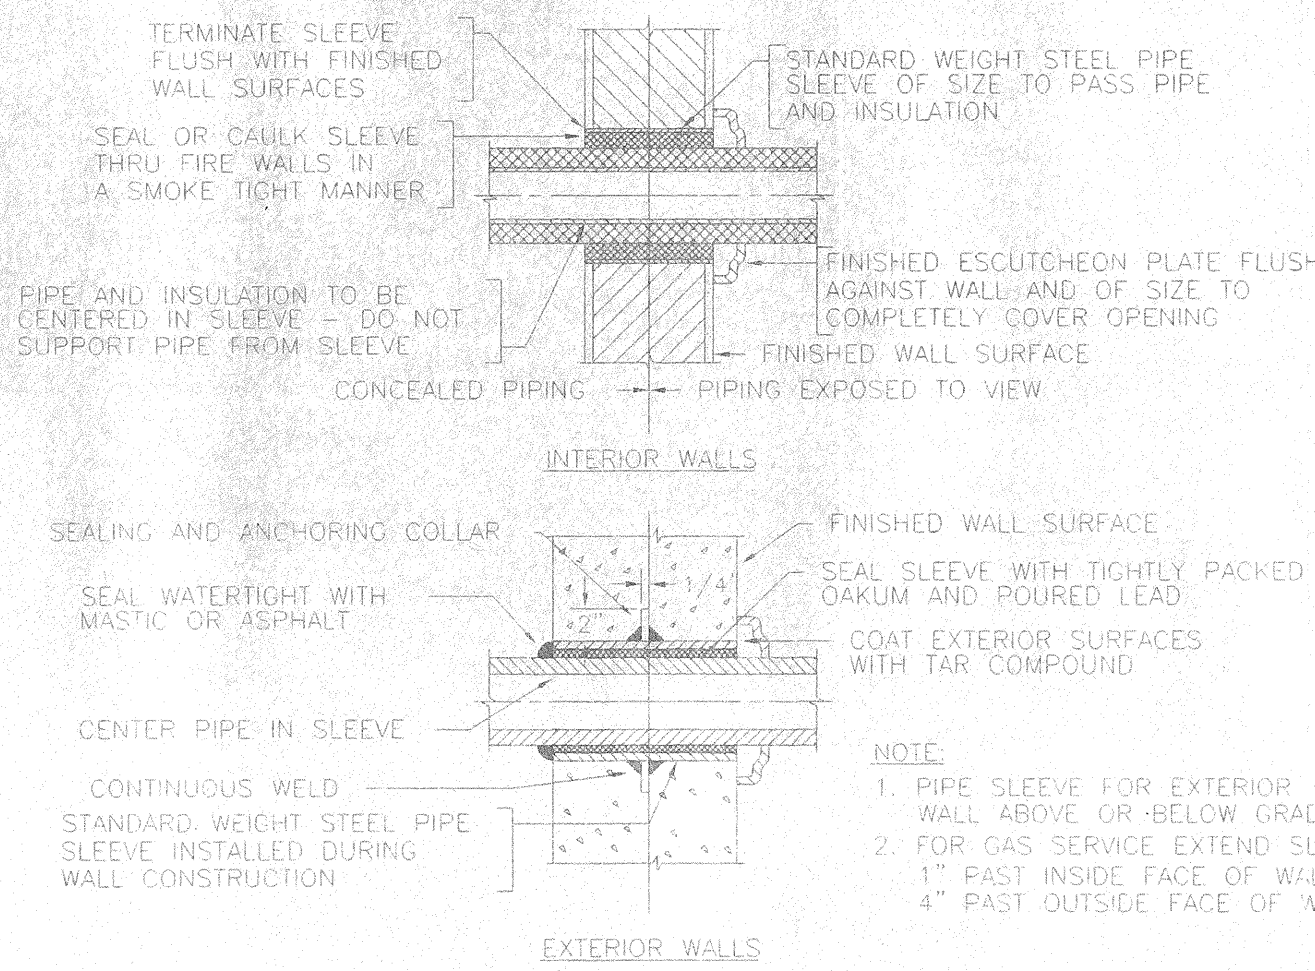

PIPE SLEEVES THRU WALL

N.T.S. 8

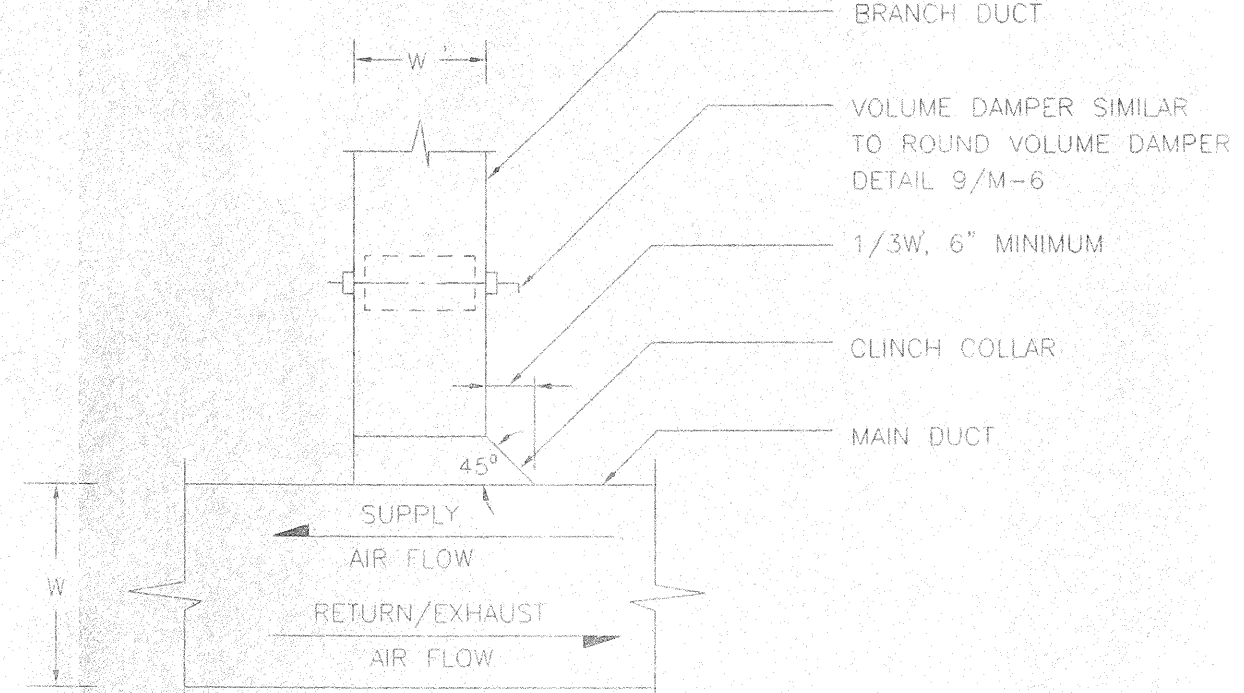

RECTANGULAR DUCT ANGULAR TAP WITH VOLUME DAMPER

N.T.S. 9