


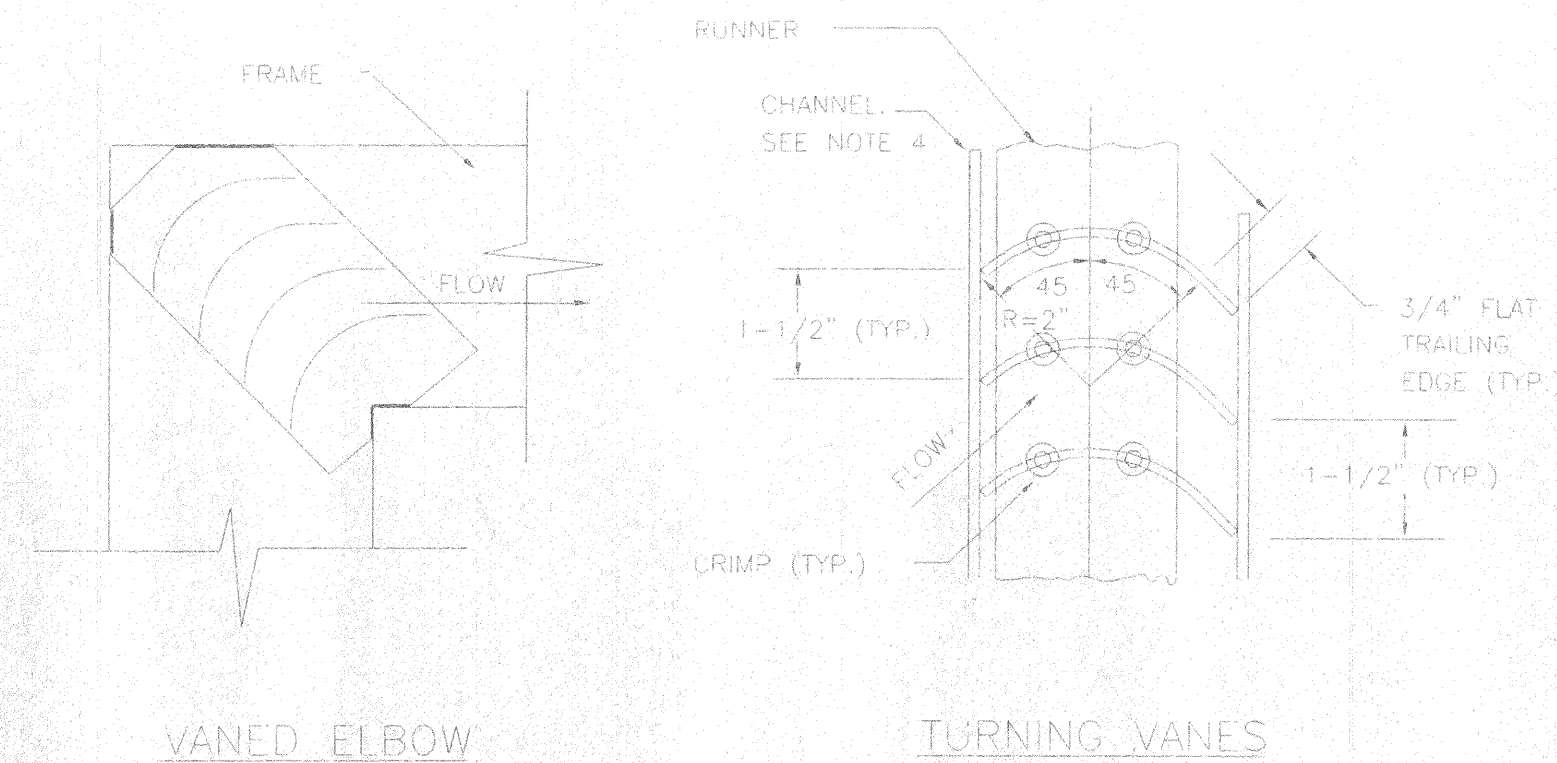


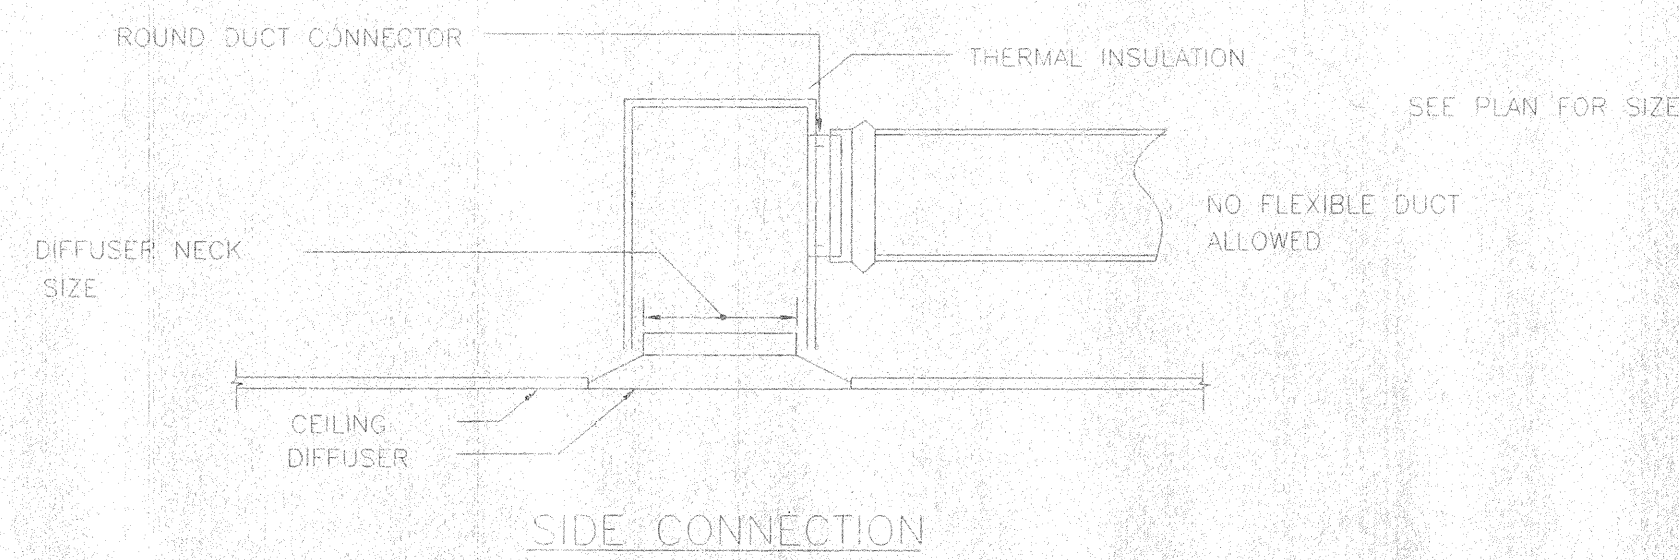


- NOTES
1. MAXIMUM UNSUPPORTED VANE LENGTH 36"
 2. VANES AND FRAMES - 24 GAUGE
 3. DUCT INLET AND OUTLET DIMENSIONS TO BE EQUAL
 4. FOR HIGH VELOCITY (1500 FPM AND ABOVE) APPLICATIONS PROVIDE 18 GAUGE CHANNEL AND TACK WELD VANE EDGES TO CHANNEL, TYPICAL BOTH ENDS
 5. FRAMES AND CHANNELS - BOLTED OR TACK WELDED TO ELBOW

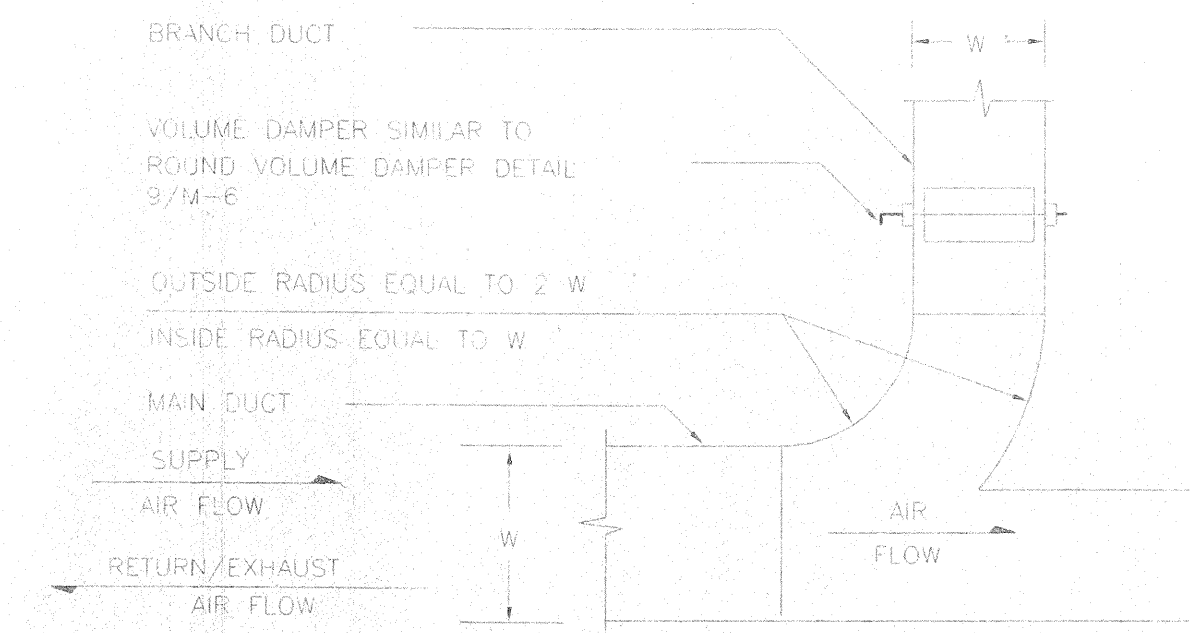

- NOTES
1. USE FOR SYMBOL **L** WHERE BRANCH DUCT AIR QUANTITY IS MORE THAN 25% AND LESS THAN 50% OF THE TOTAL AIR FLOW.
 2. DEPTH OF DUCT FOR W AND W SHOULD BE EQUAL

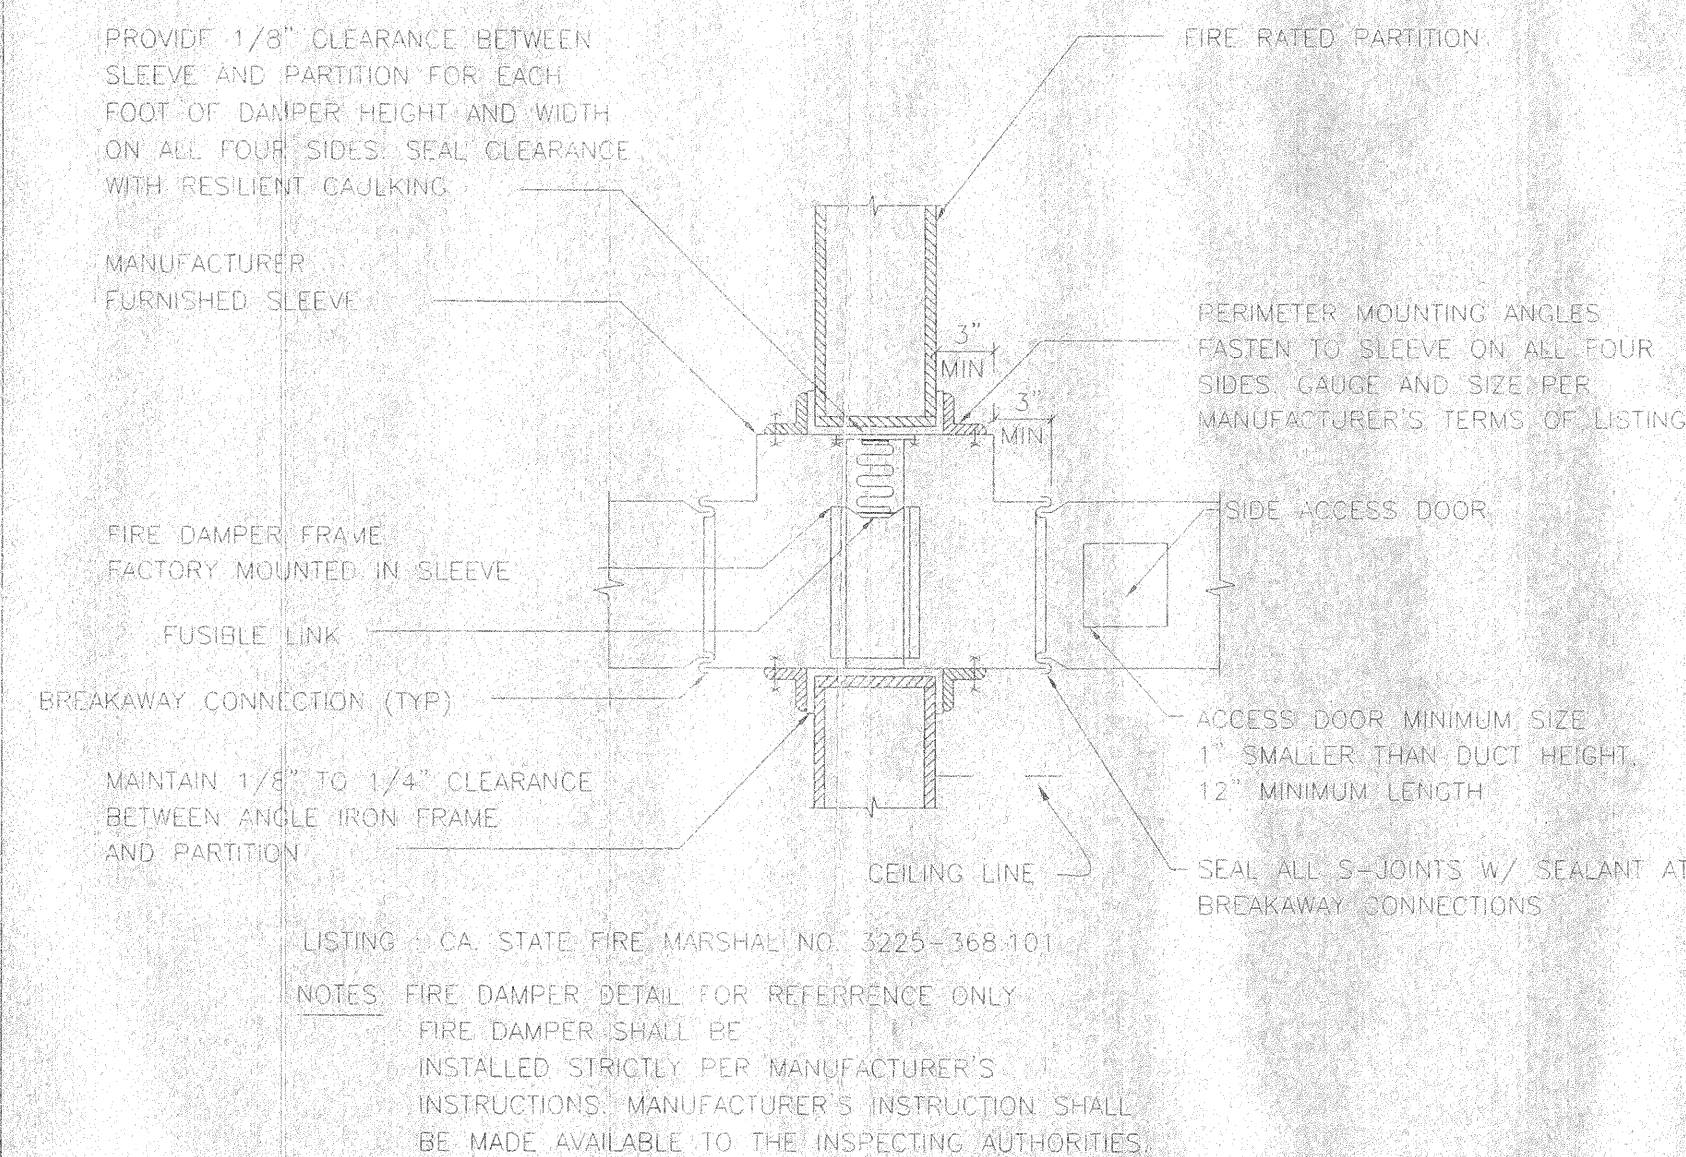

FOR MECH. ROOM WEST CAMPUS, BUILDING 'N'

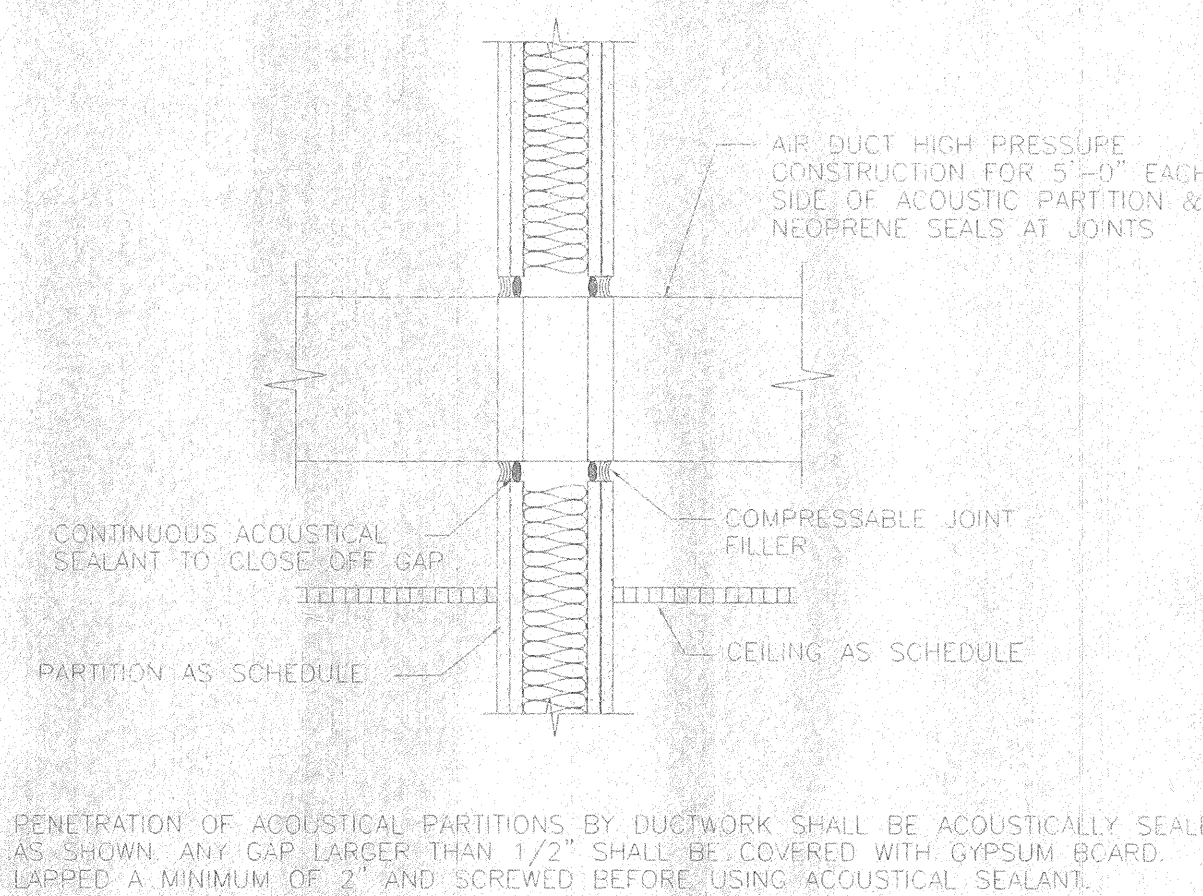

Architecture, Planning, Consult
511 Mission Street
South Pasadena, CA 91030
tel 626 799 9920
fax 626 799 8260
e-mail: info@onuma.co


Consultants

DEBIBI & ROSHANIAN INC.
MECHANICAL & ELECTRICAL ENGINEERS
North Hollywood, CA 91607
TEL: (818) 980-0837
FAX: (818) 980-1251

AS BUILT

REMODEL
FOR
SAINT EDMUND'S
EPISCOPAL CHURCH
1175 SAN CARLOS BLVD SAN MATEO, CA 94401

STAMPS

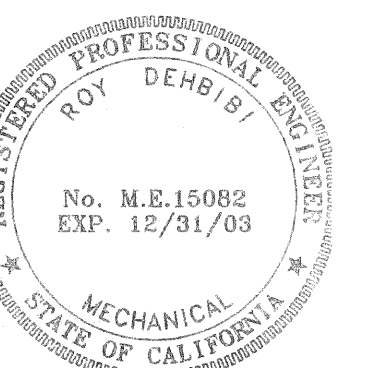

REVISIONS

DESCRIPTION	DATE
PROJECT NUMBER	200
SCALE	AS NOTED
PRINTED	01/18/04
TITLE	

SHEET

**Wittler
Young/co.
Inc.**
AS BUILT
DATE: 04/15/2001

M-3

OF