


Consultants

AS BUILT
 DEBIBI & ROSHANIAN INC.
 MECHANICAL & ELECTRICAL ENGINEERS
 10000 Wilshire Blvd., Suite 202
 North Hollywood, CA 91607
 TEL (818) 980-0837
 FAX (818) 508-1251

REMODEL
 FOR
 SAINT EDMUND'S
 EPISCOPAL CHURCH
 1175 SAN GABRIEL BLVD SAN MARINO CA 91108-8048

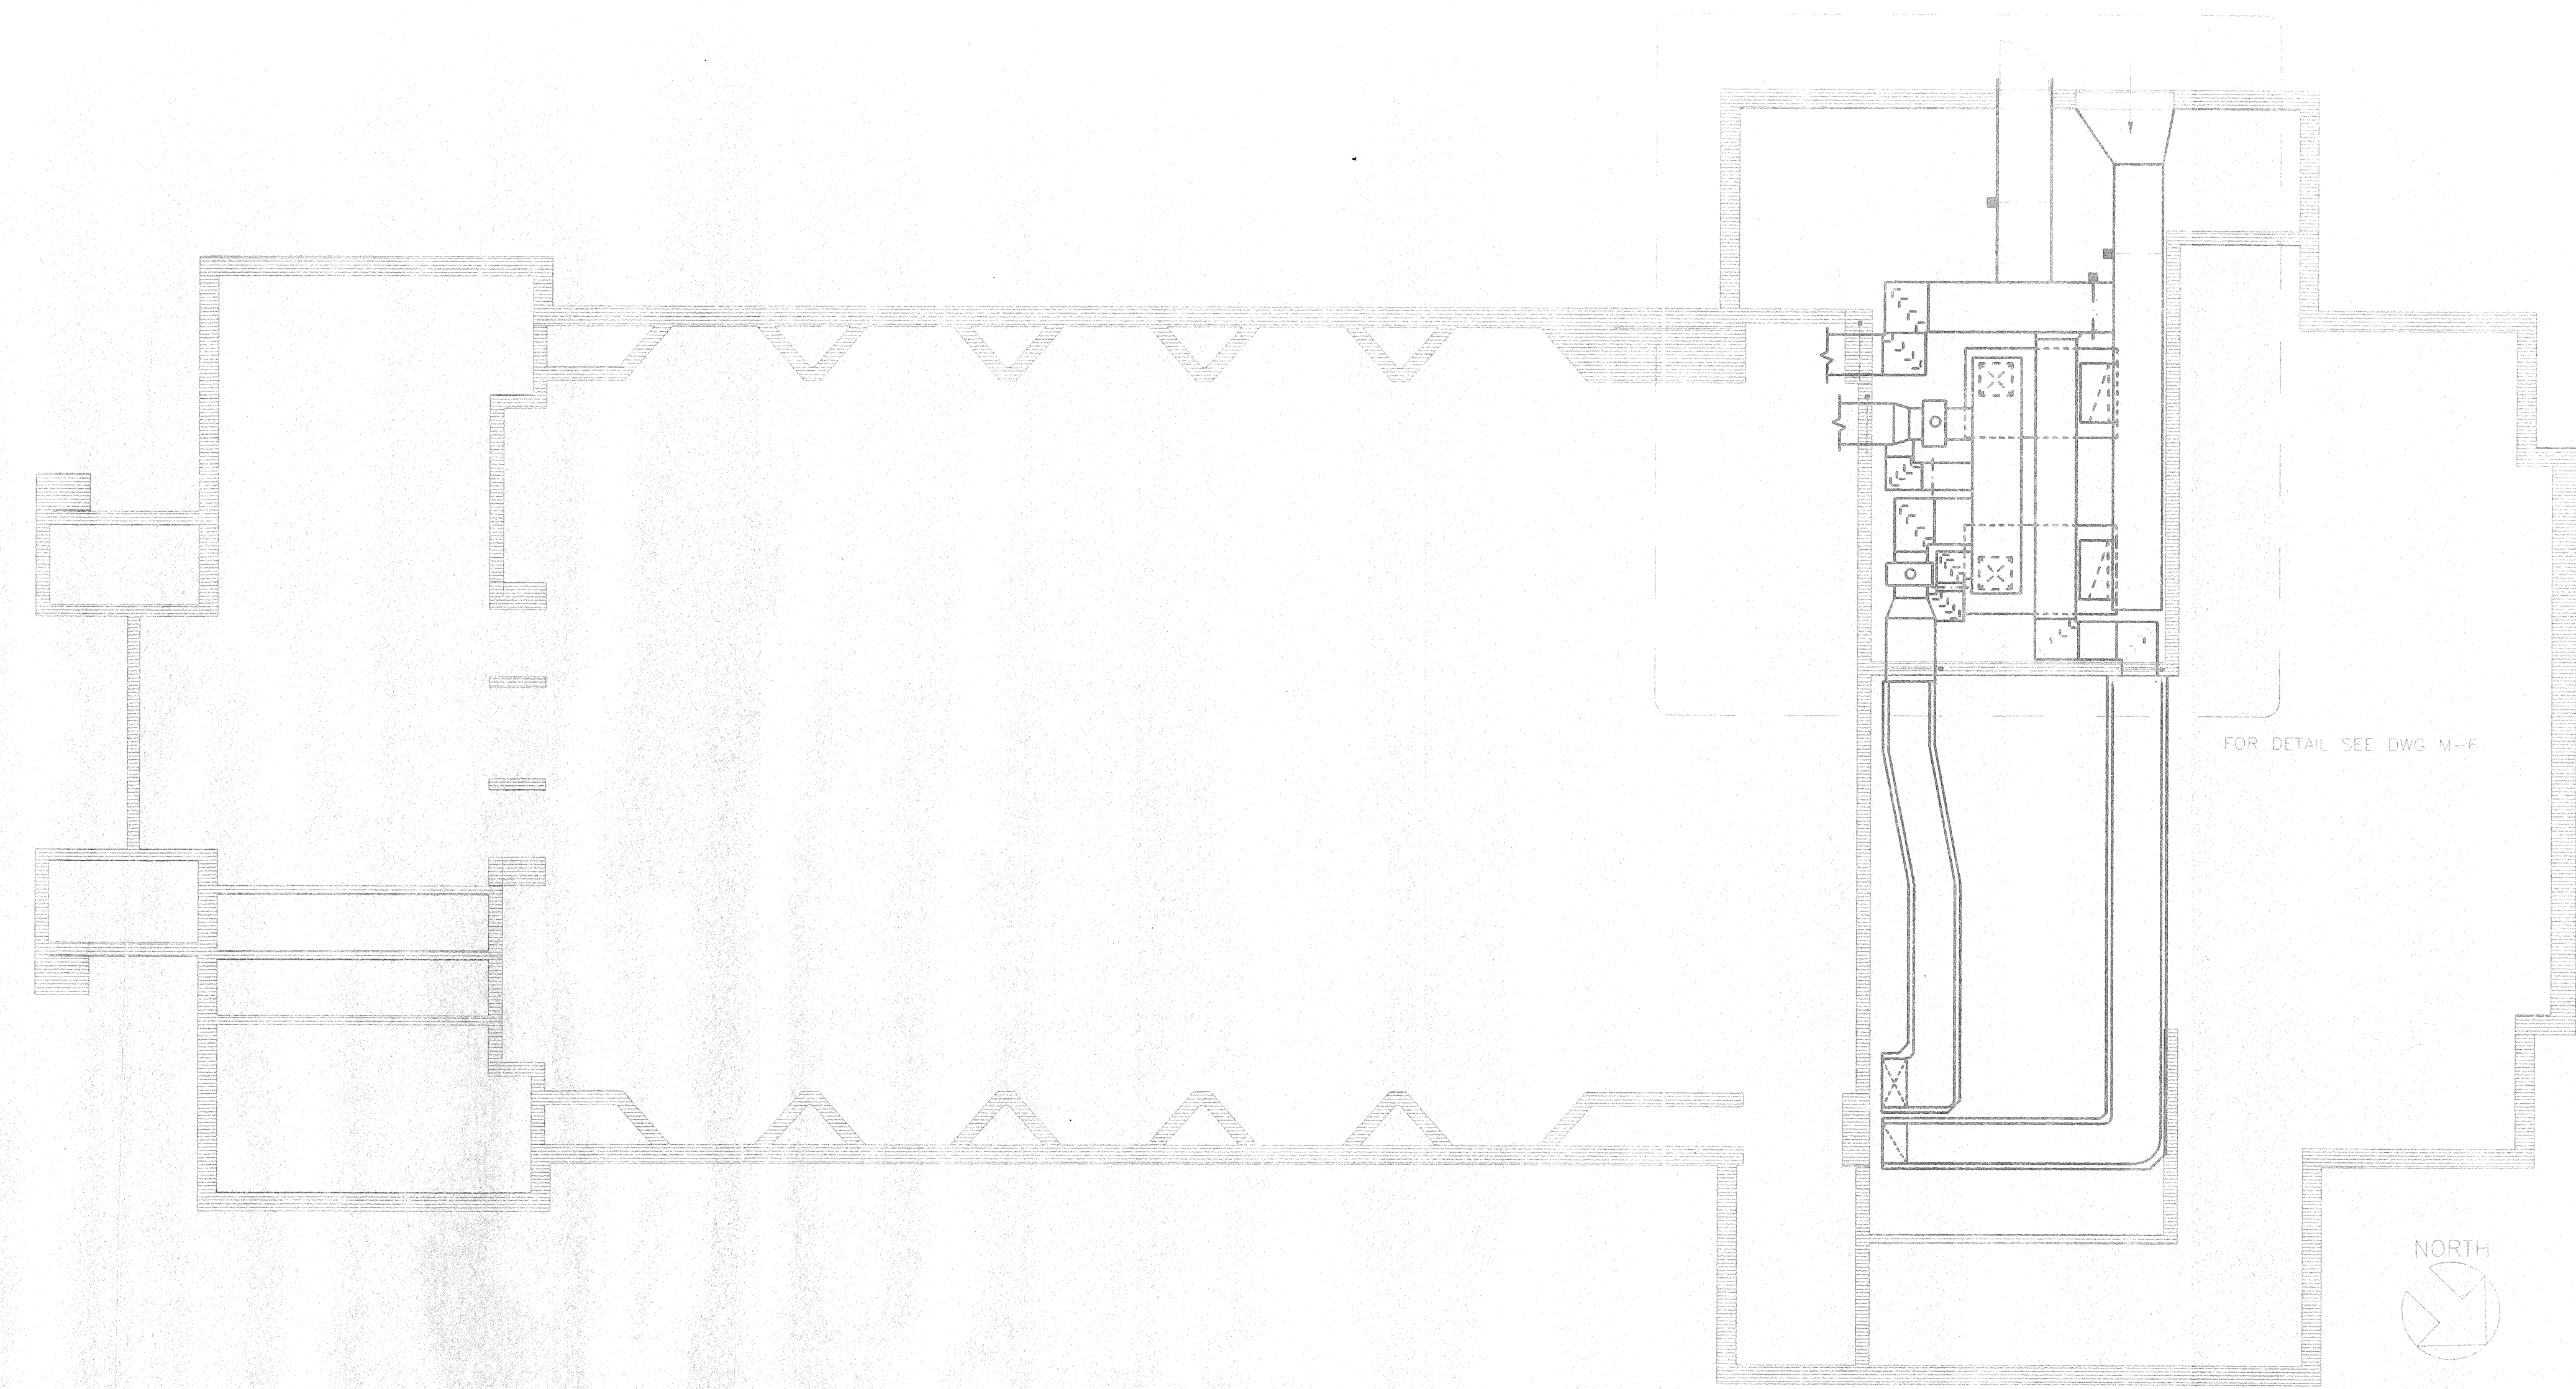


BASEMENT AIR CONDITIONING PLAN

SCALE: 1/8"=1'-0"

PLAN NOTES:

- 01 EXISTING 12"Ø FLUE THRU ROOF TO BE CLEANED.
- 02 DO NOT TOUCH EXISTING DUCT SYSTEM RELATED TO MUSICAL INSTRUMENT.
- 03 EXISTING MUSICAL INSTRUMENT SYSTEM TO REMAIN.
- 04 REMOVE ALL EXISTING H/V DUCT SYSTEM AND RELATED EQUIPMENTS.
- 05 CLEAN UNDER STAGE DUCT USE VACUUM PUMP TO PROCEED 5" NEGATIVE STATIC PRESSURE.

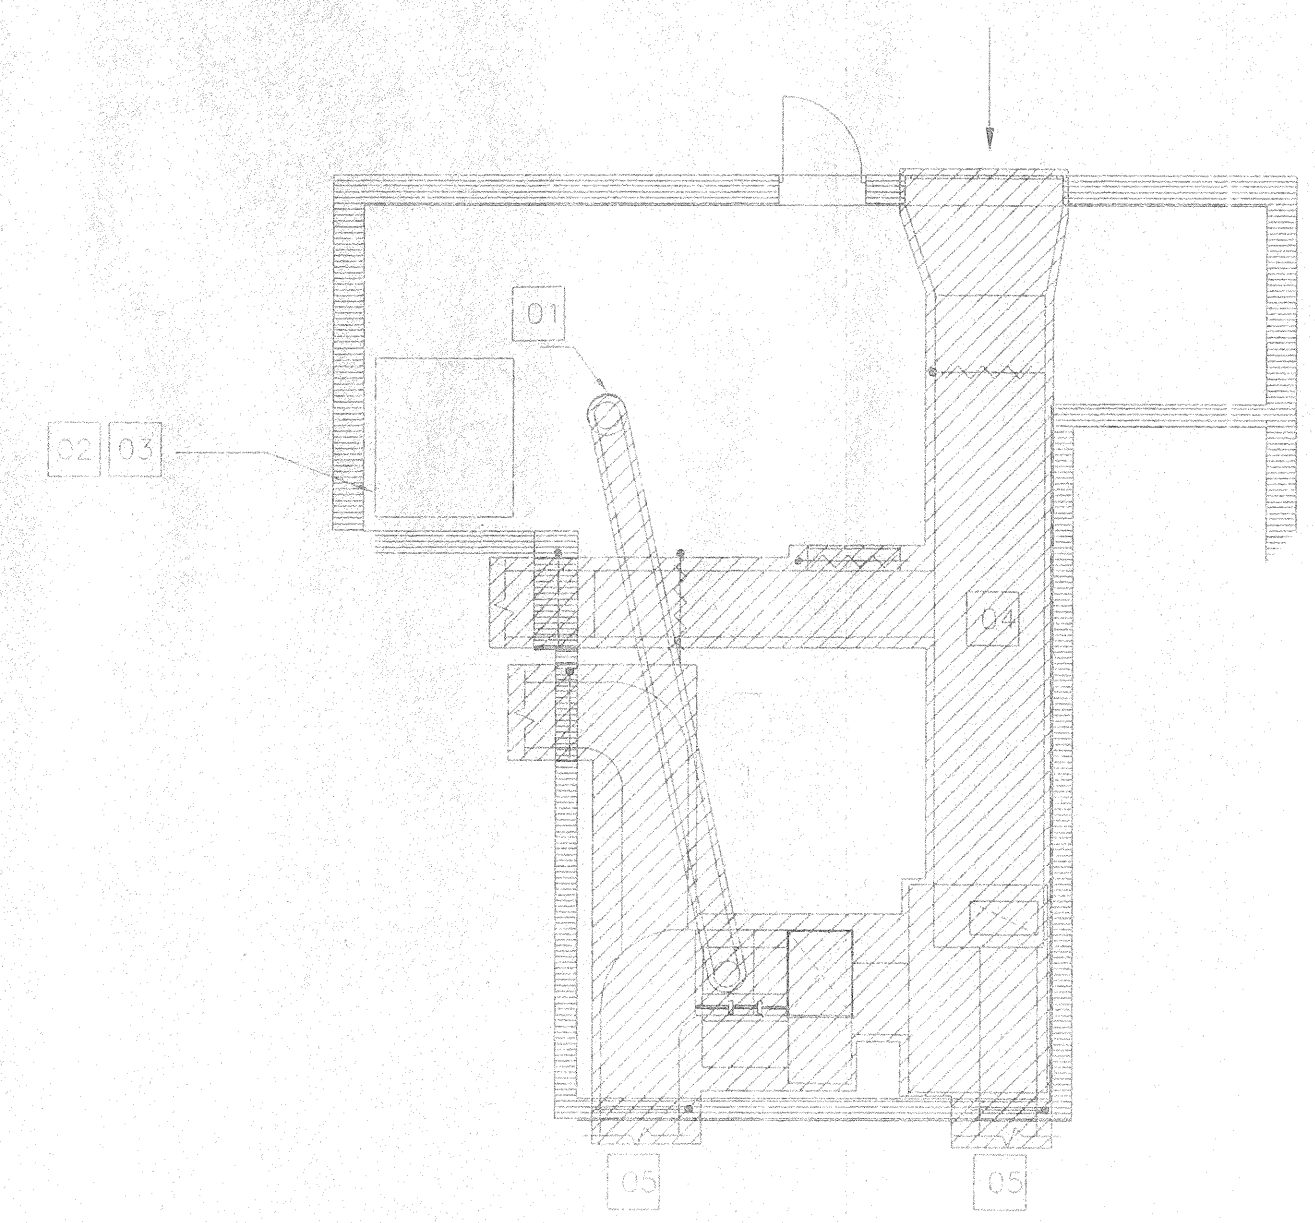


BASEMENT AIR CONDITIONING DEMOLITION PLAN

SCALE: 1/8"=1'-0"

Wittler Young & Co. Inc.
AS BUILT
 DATE: 04/15/2001

STAMPS

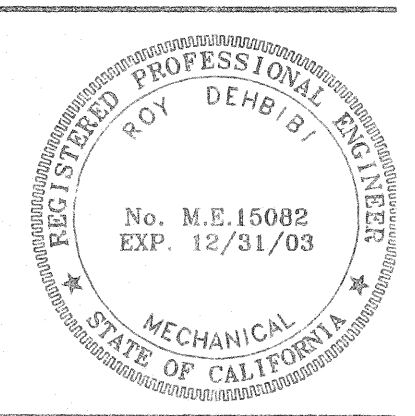

REVISIONS

DESCRIPTION	DATE
PROJECT NUMBER	2000
SCALE	AS NOTE
PRINTED	01/18/01

TITLE
 BASEMENT A/C
 PLAN
 SHEET

M-5
 OF