



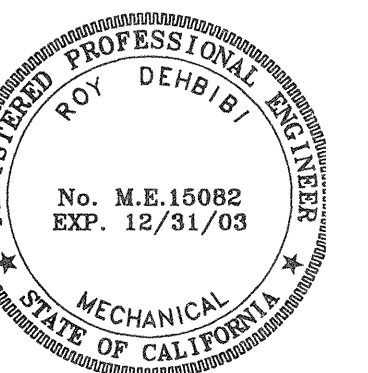


DESCRIPTION	DATE	BY
PROJECT NUMBER	200	
SCALE	AS NOTE	
PRINTED	01/18/84	
TITLE	1st FLOOR PLAN	
SHEET		

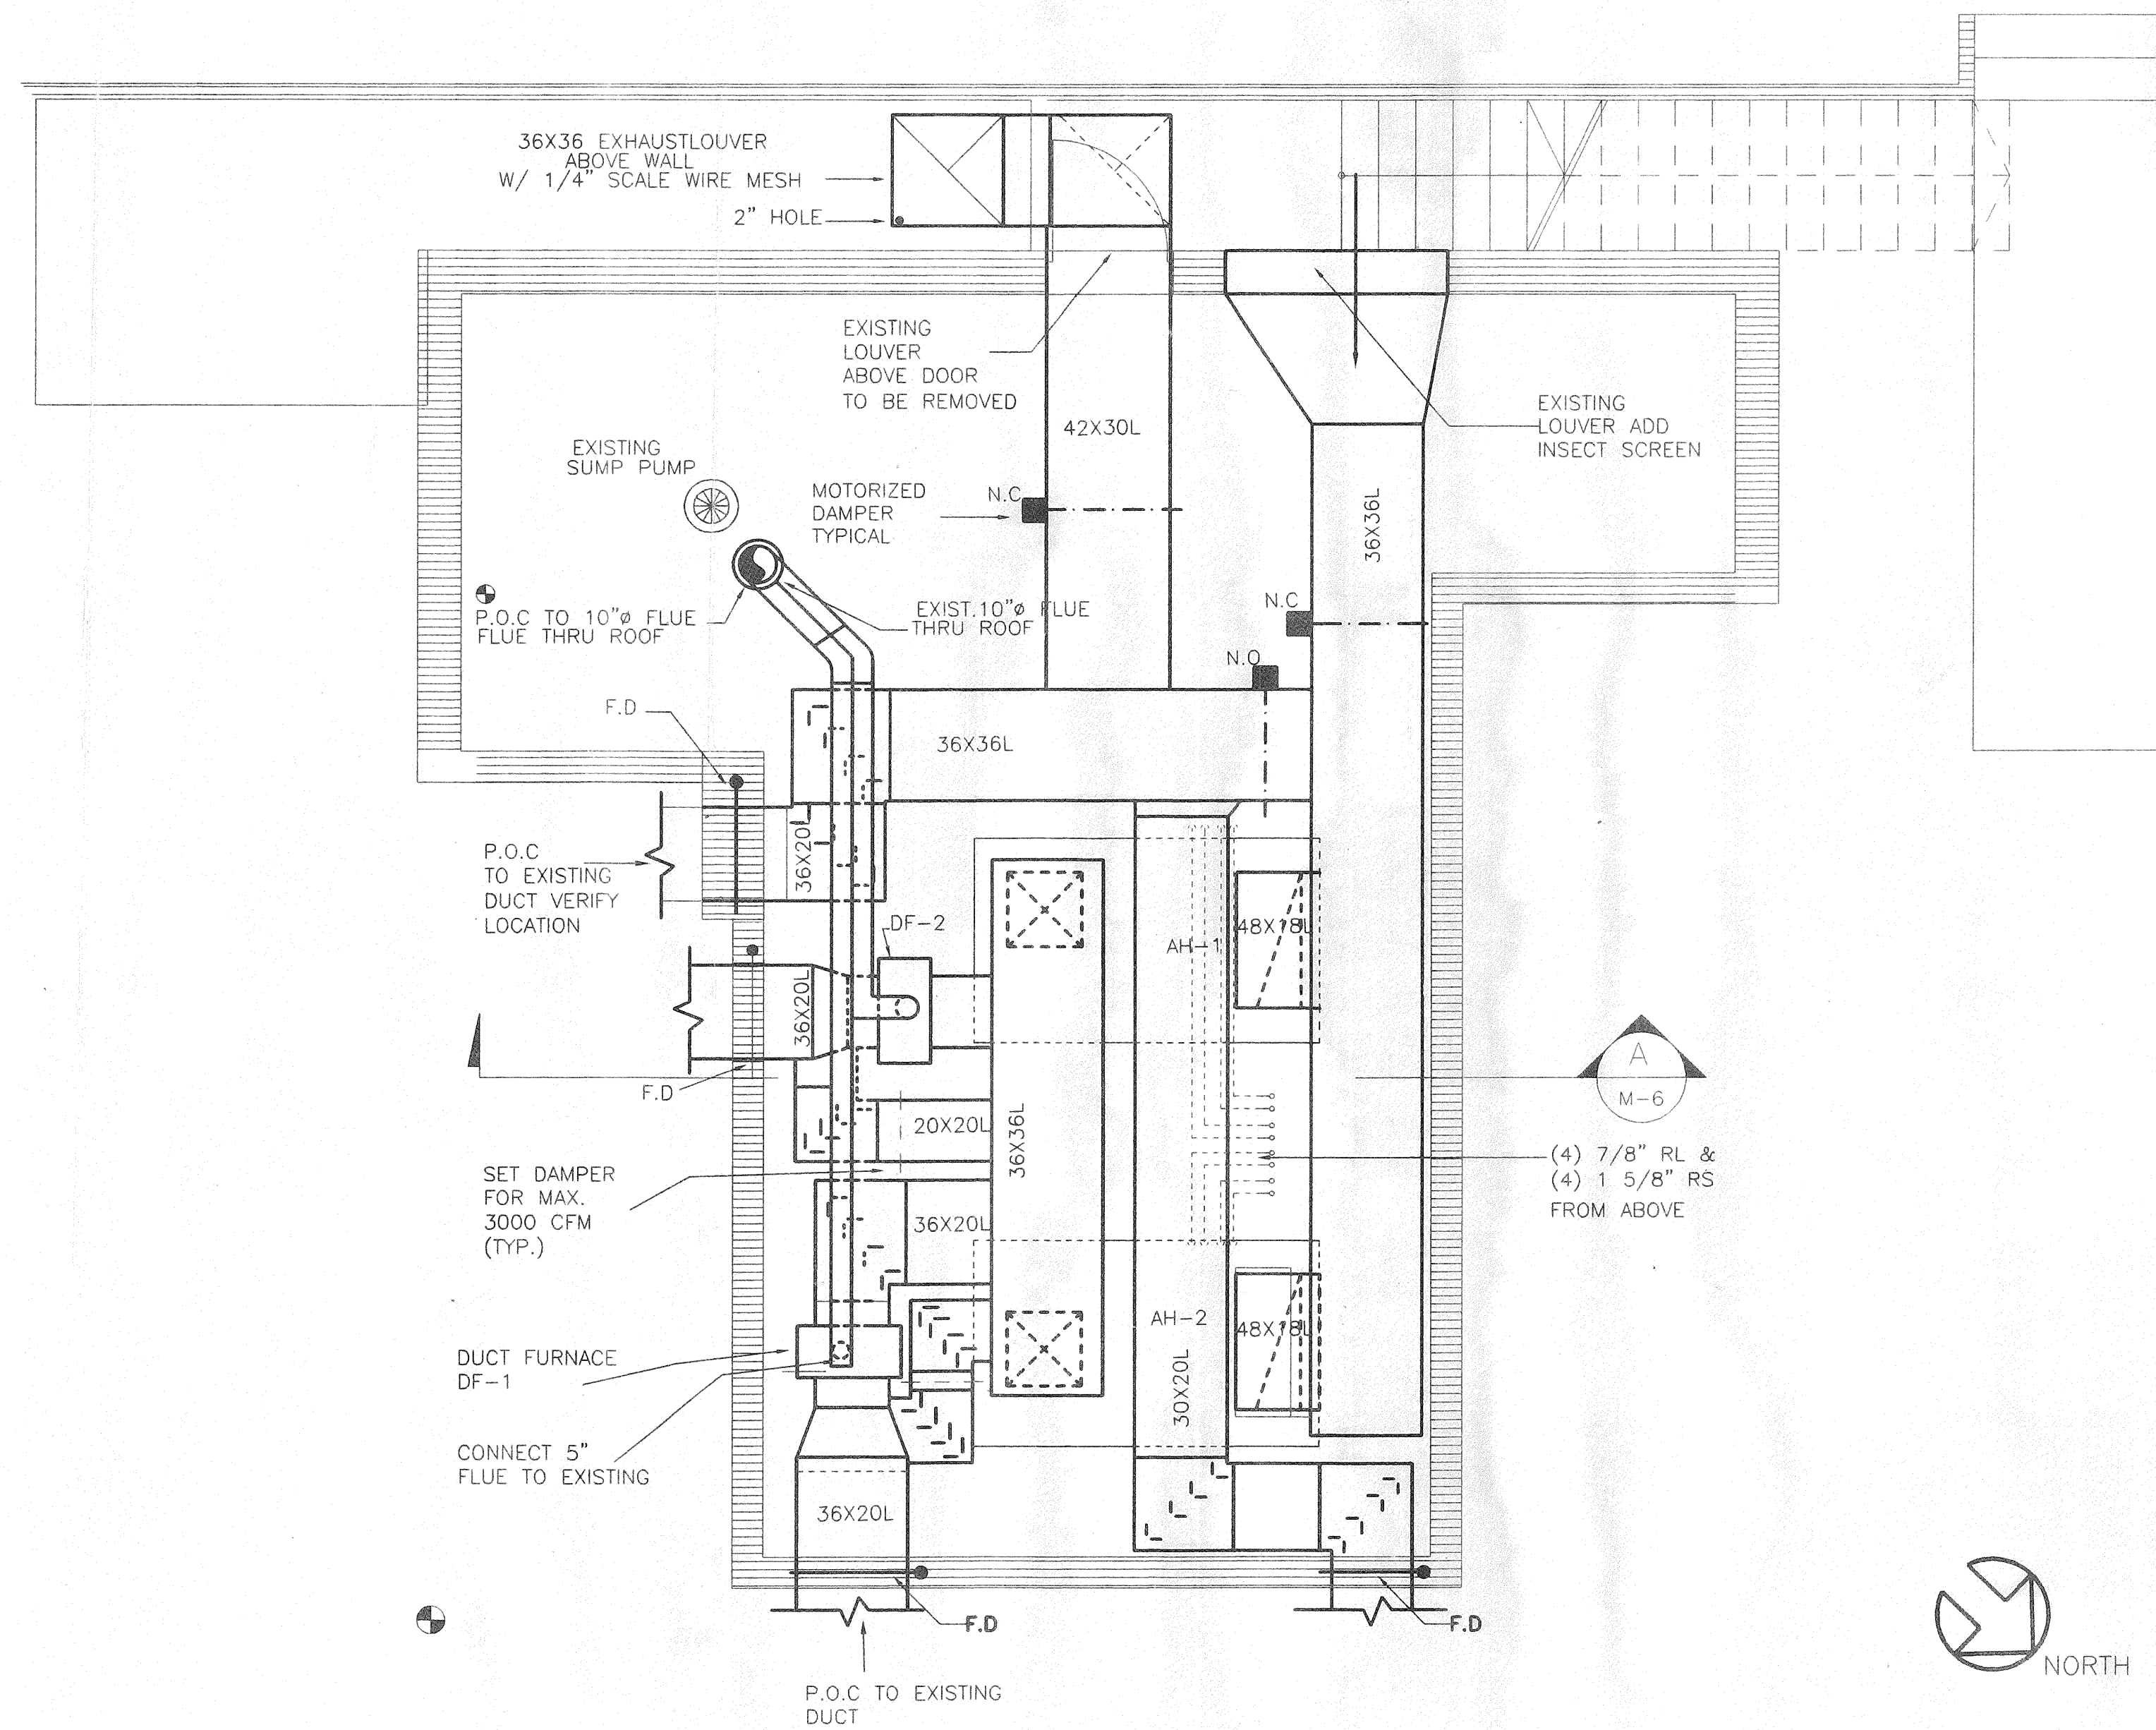


BASEMENT NEW AIR CONDITIONING PLAN

SCALE: 1/4"=1'-0"

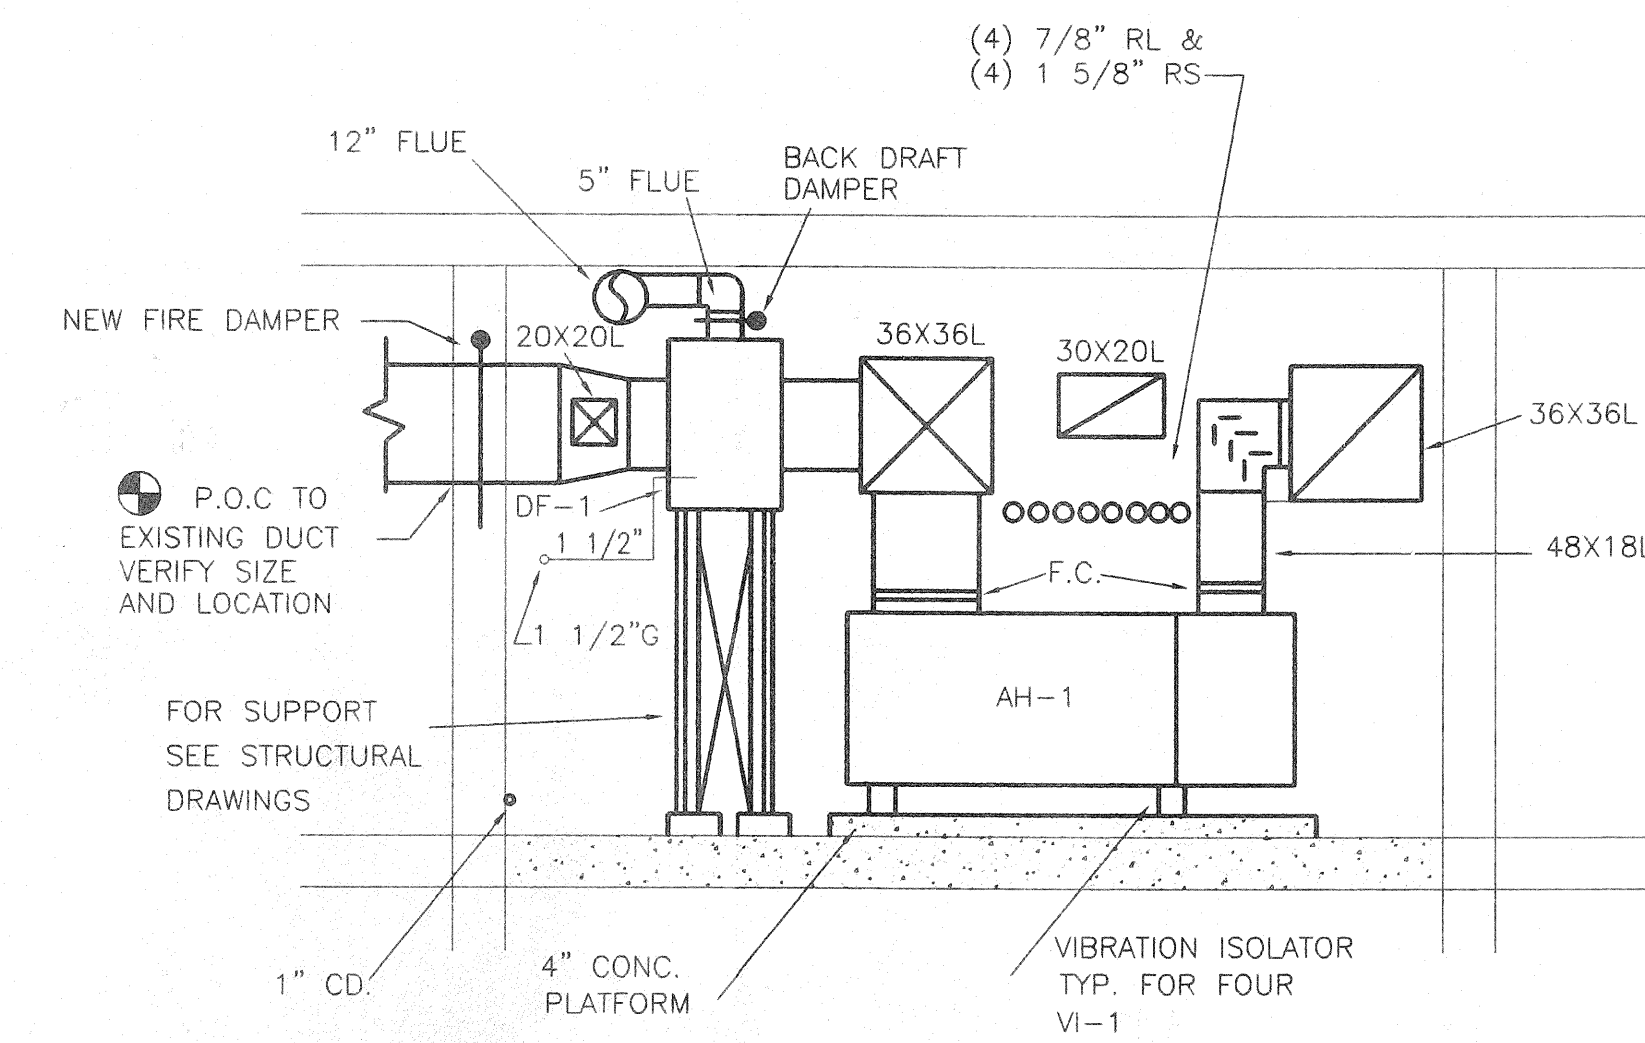

SECTION
SCALE: 1/4"=1'-0"

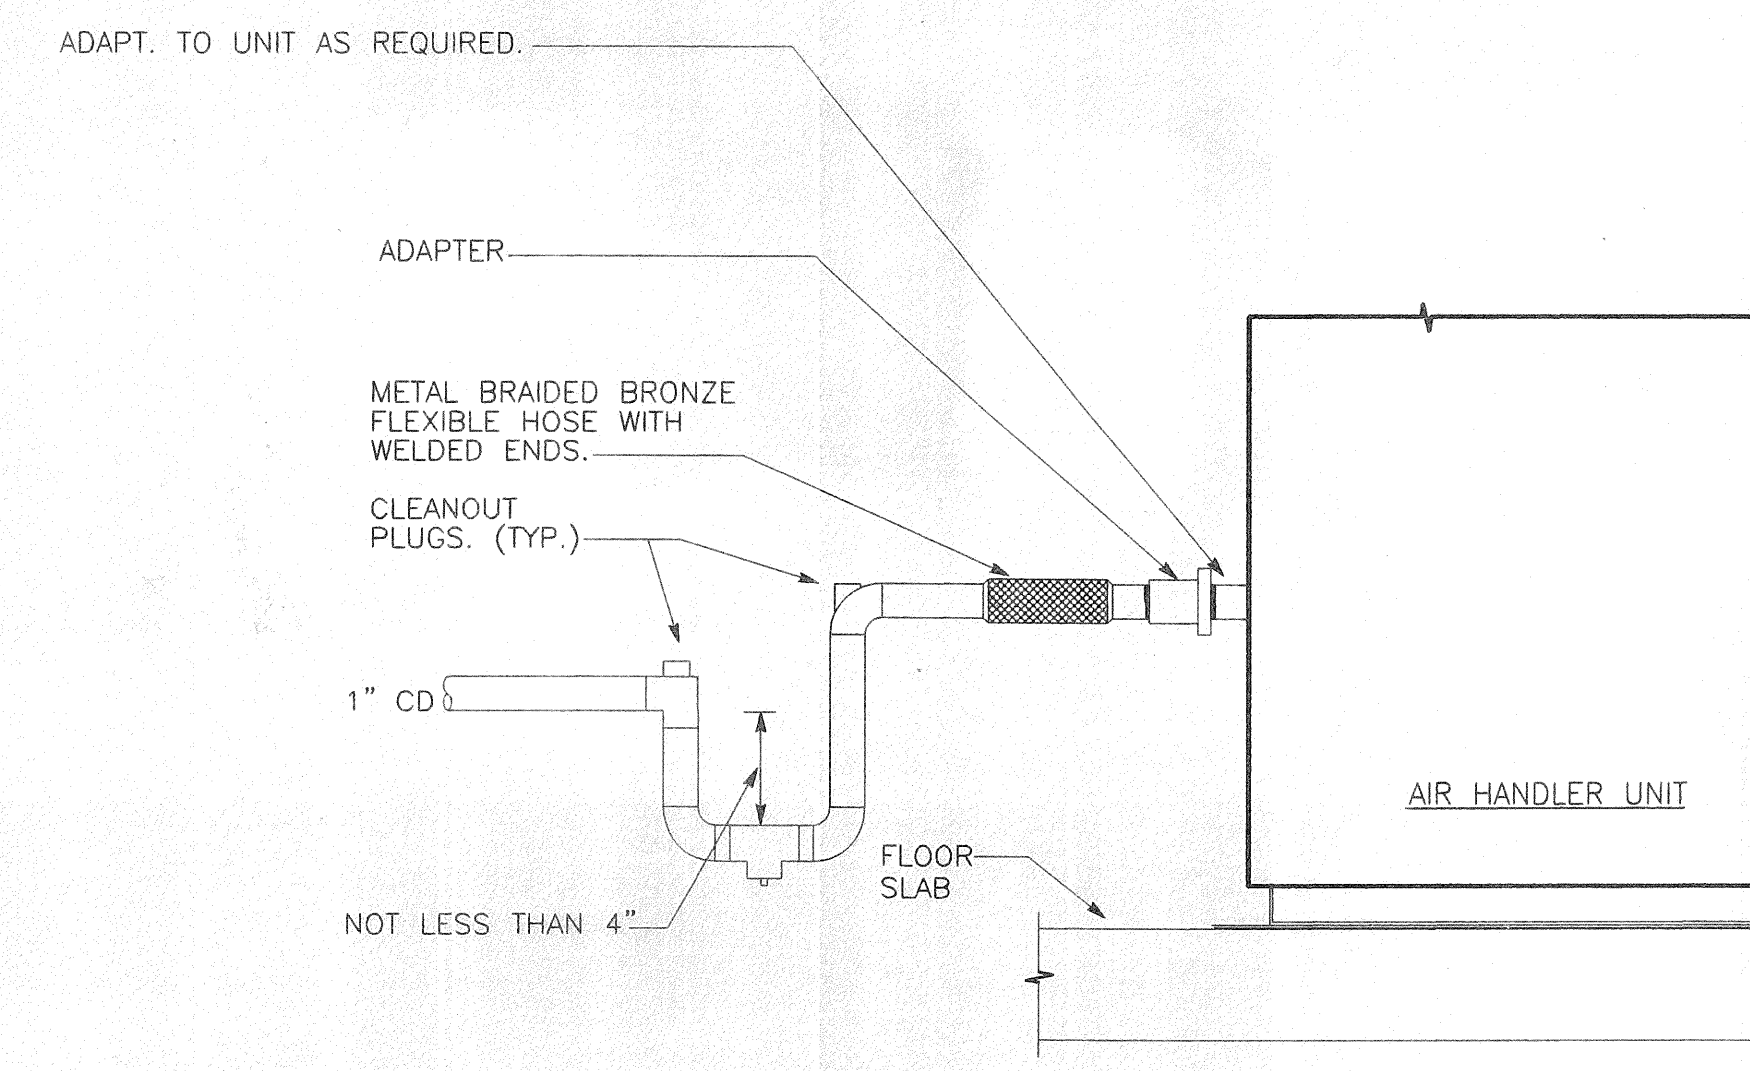

AS BUILT

DATE: 04/15/2001

AIR HANDLER CONDENSATE DRAIN DETAIL