



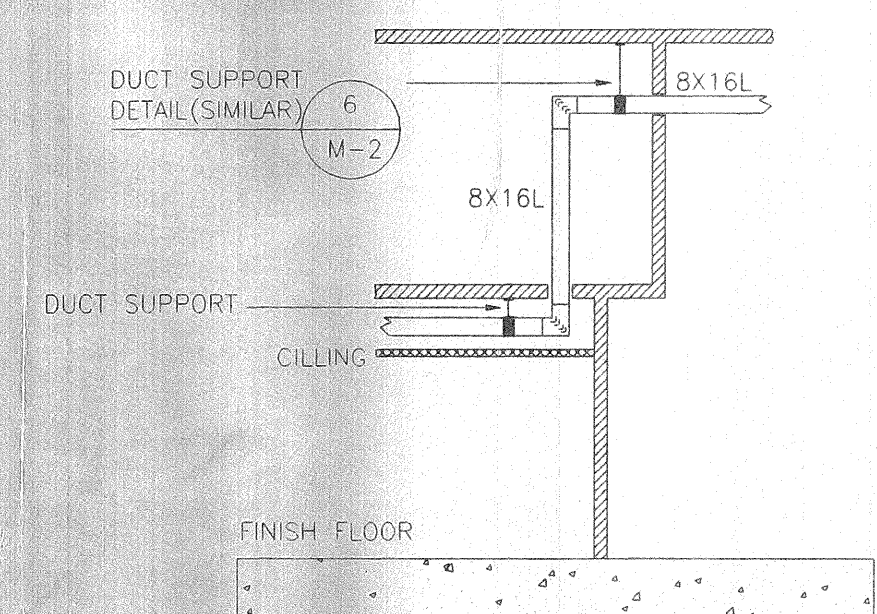


SECTION
NOT TO SCALE

B
M-7

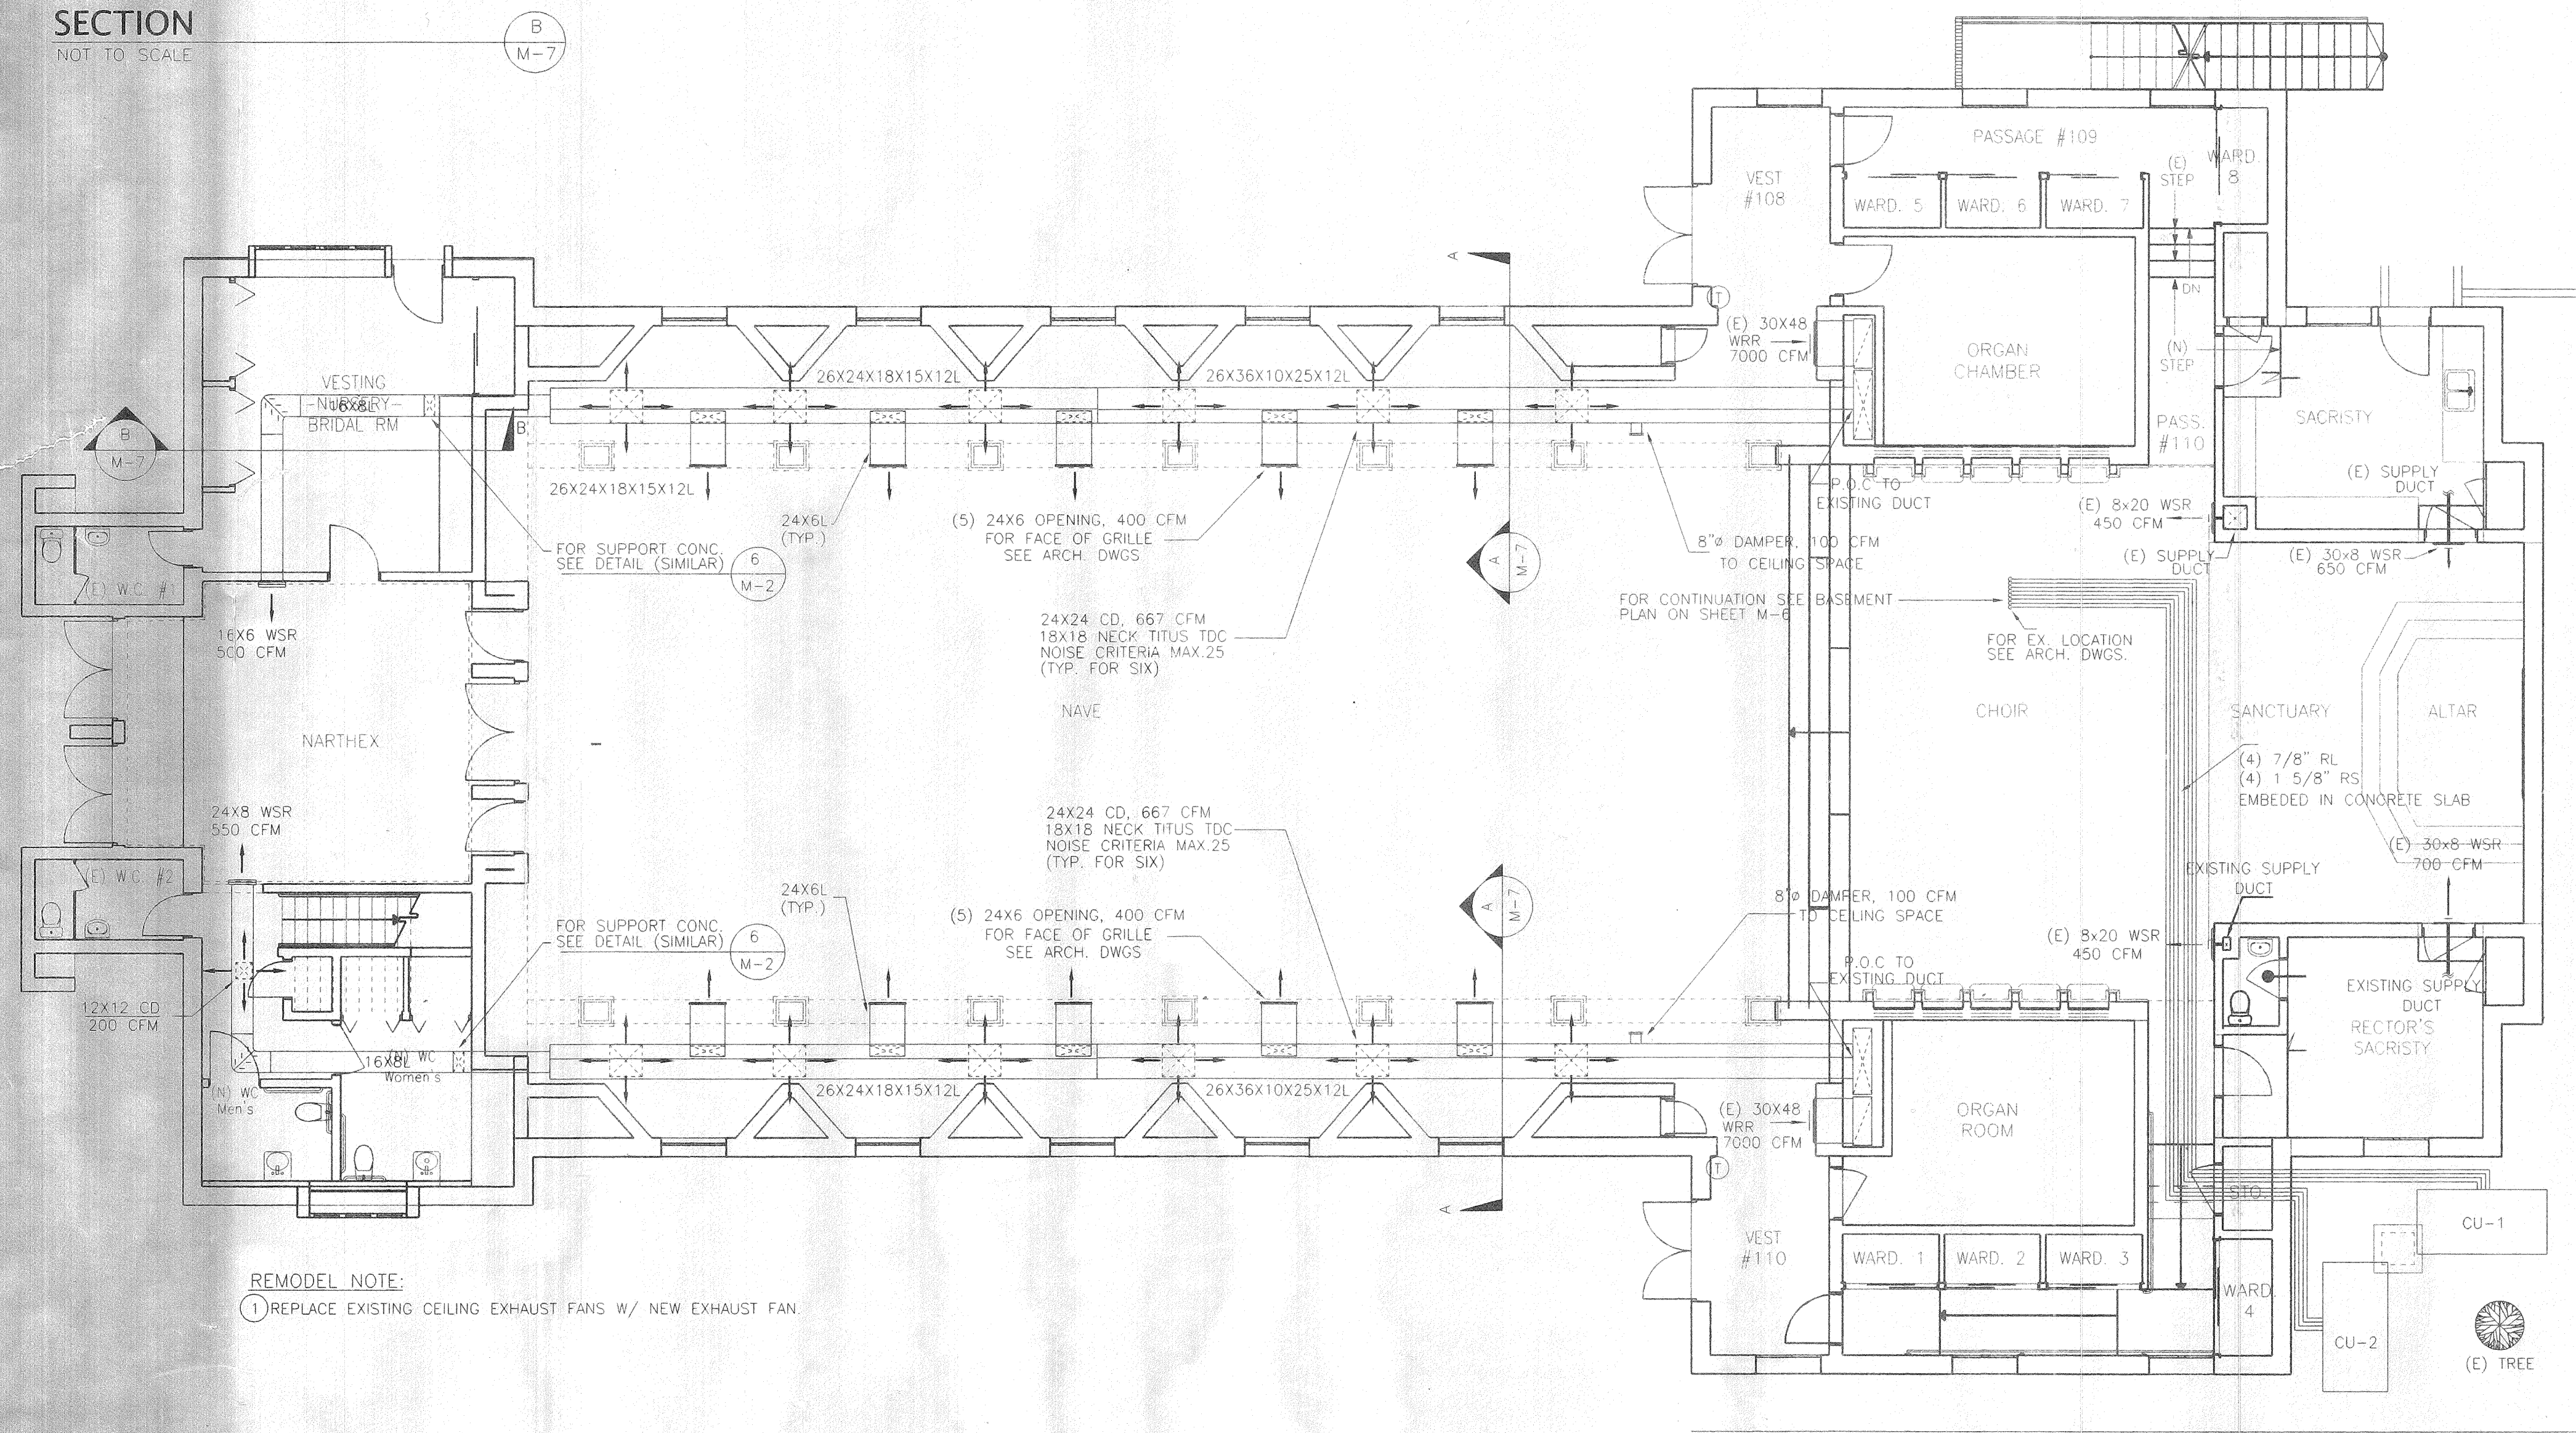


REMODEL NOTE:
① REPLACE EXISTING CEILING EXHAUST FANS W/ NEW EXHAUST FAN.

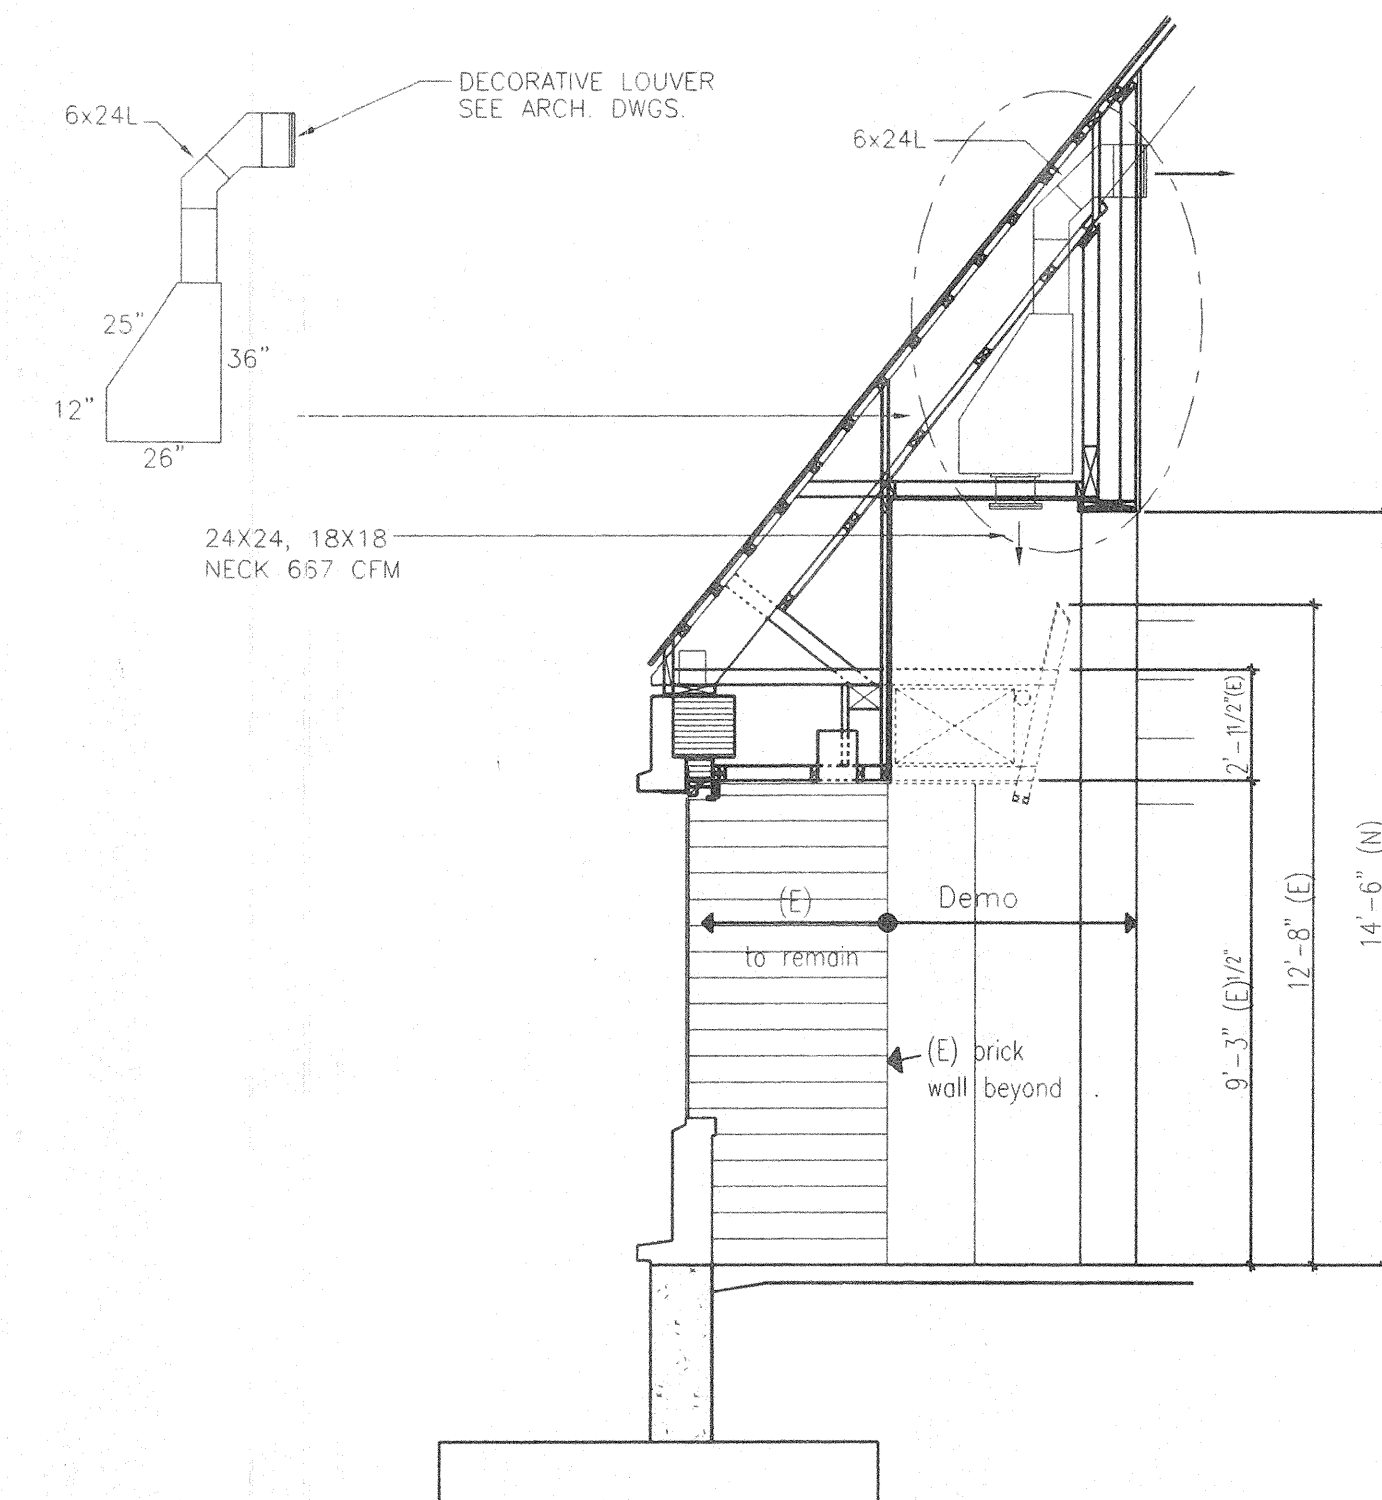

SECTION
1/8"=1'-0"

A
M-7

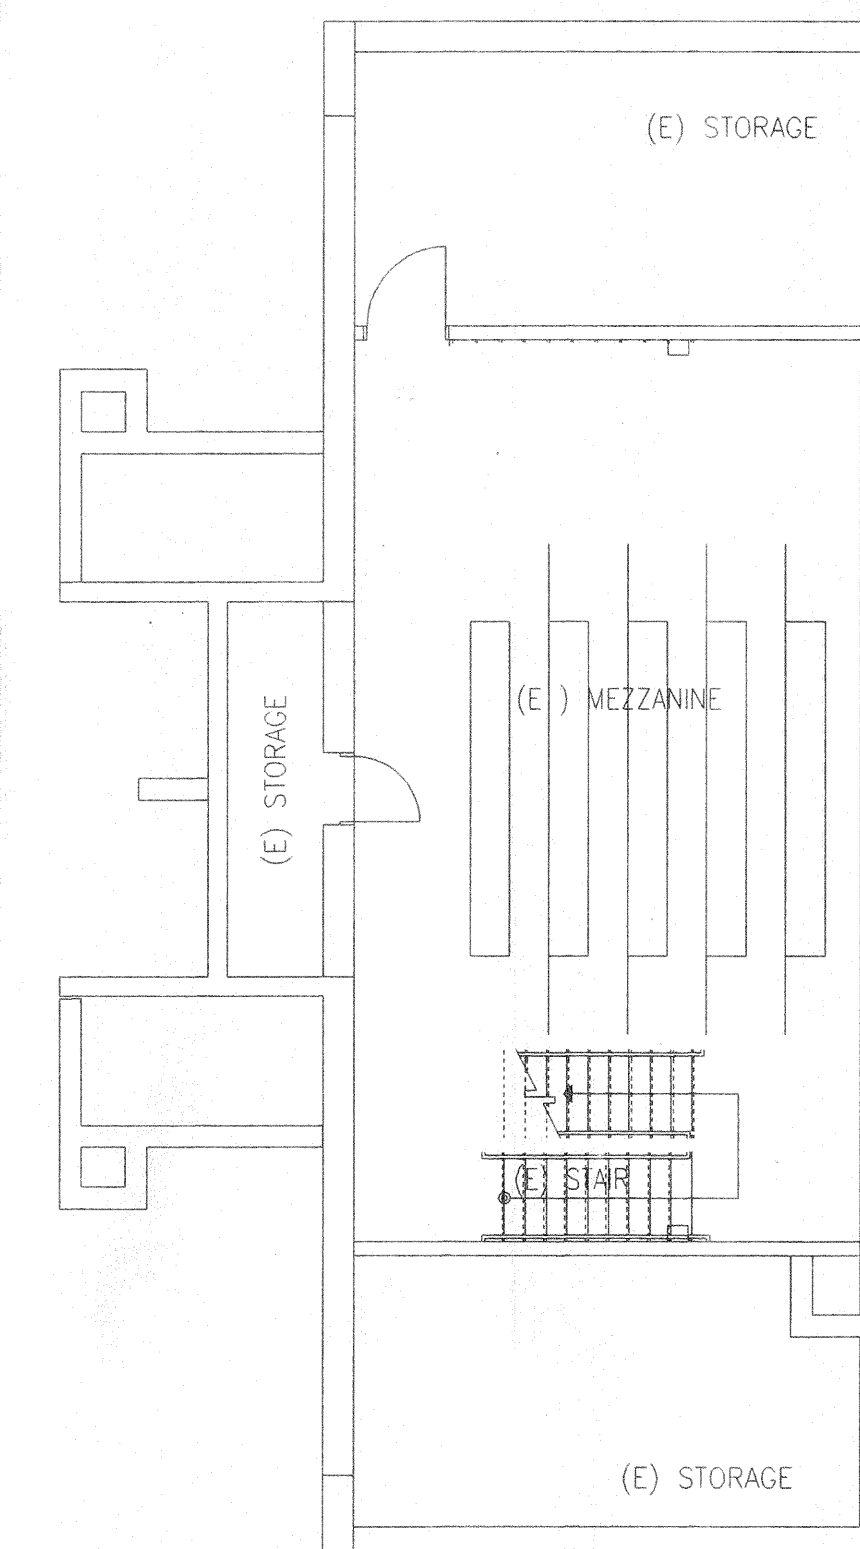

MEZANINE FLOOR PLAN
1/8"=1'-0"

**Wittler
Young/co.
nc.**
AS BUILT
DATE: 04/15/2001

FIRST FLOOR AIR CONDITIONING PLAN

SCALE: 1/8"=1'-0"

**Onuma &
Associates**
Architecture, Planning, Consult
511 Mission Street
South Pasadena, CA 9103
tel 626.799.9920
fax 626.799.8260
e-mail: info@onuma.co


Consultants

DEBIBI & ROSHANIAN INC.
MECHANICAL & ELECTRICAL ENGINEERS
4741 Laurel Canyon Blvd., Suite 202
Van Nuys, CA 91411
TEL: (818) 980-0837
FAX: (818) 508-1251

AS BUILT

REMODEL
FOR
SAINT EDMUND'S
EPISCOPAL CHURCH
1175 SAN GABRIEL BLVD SAN MARINO CA 91108-8048

STAMPS

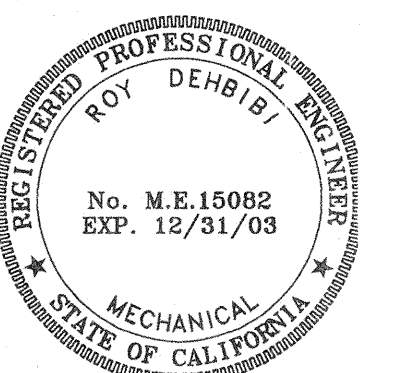

REVISIONS

DESCRIPTION	DATE

PROJECT NUMBER
200

SCALE AS NOTE

PRINTED 01/18/01

TITLE 1st

FLOOR A/C PLAN

SHEET

M-7

OF