


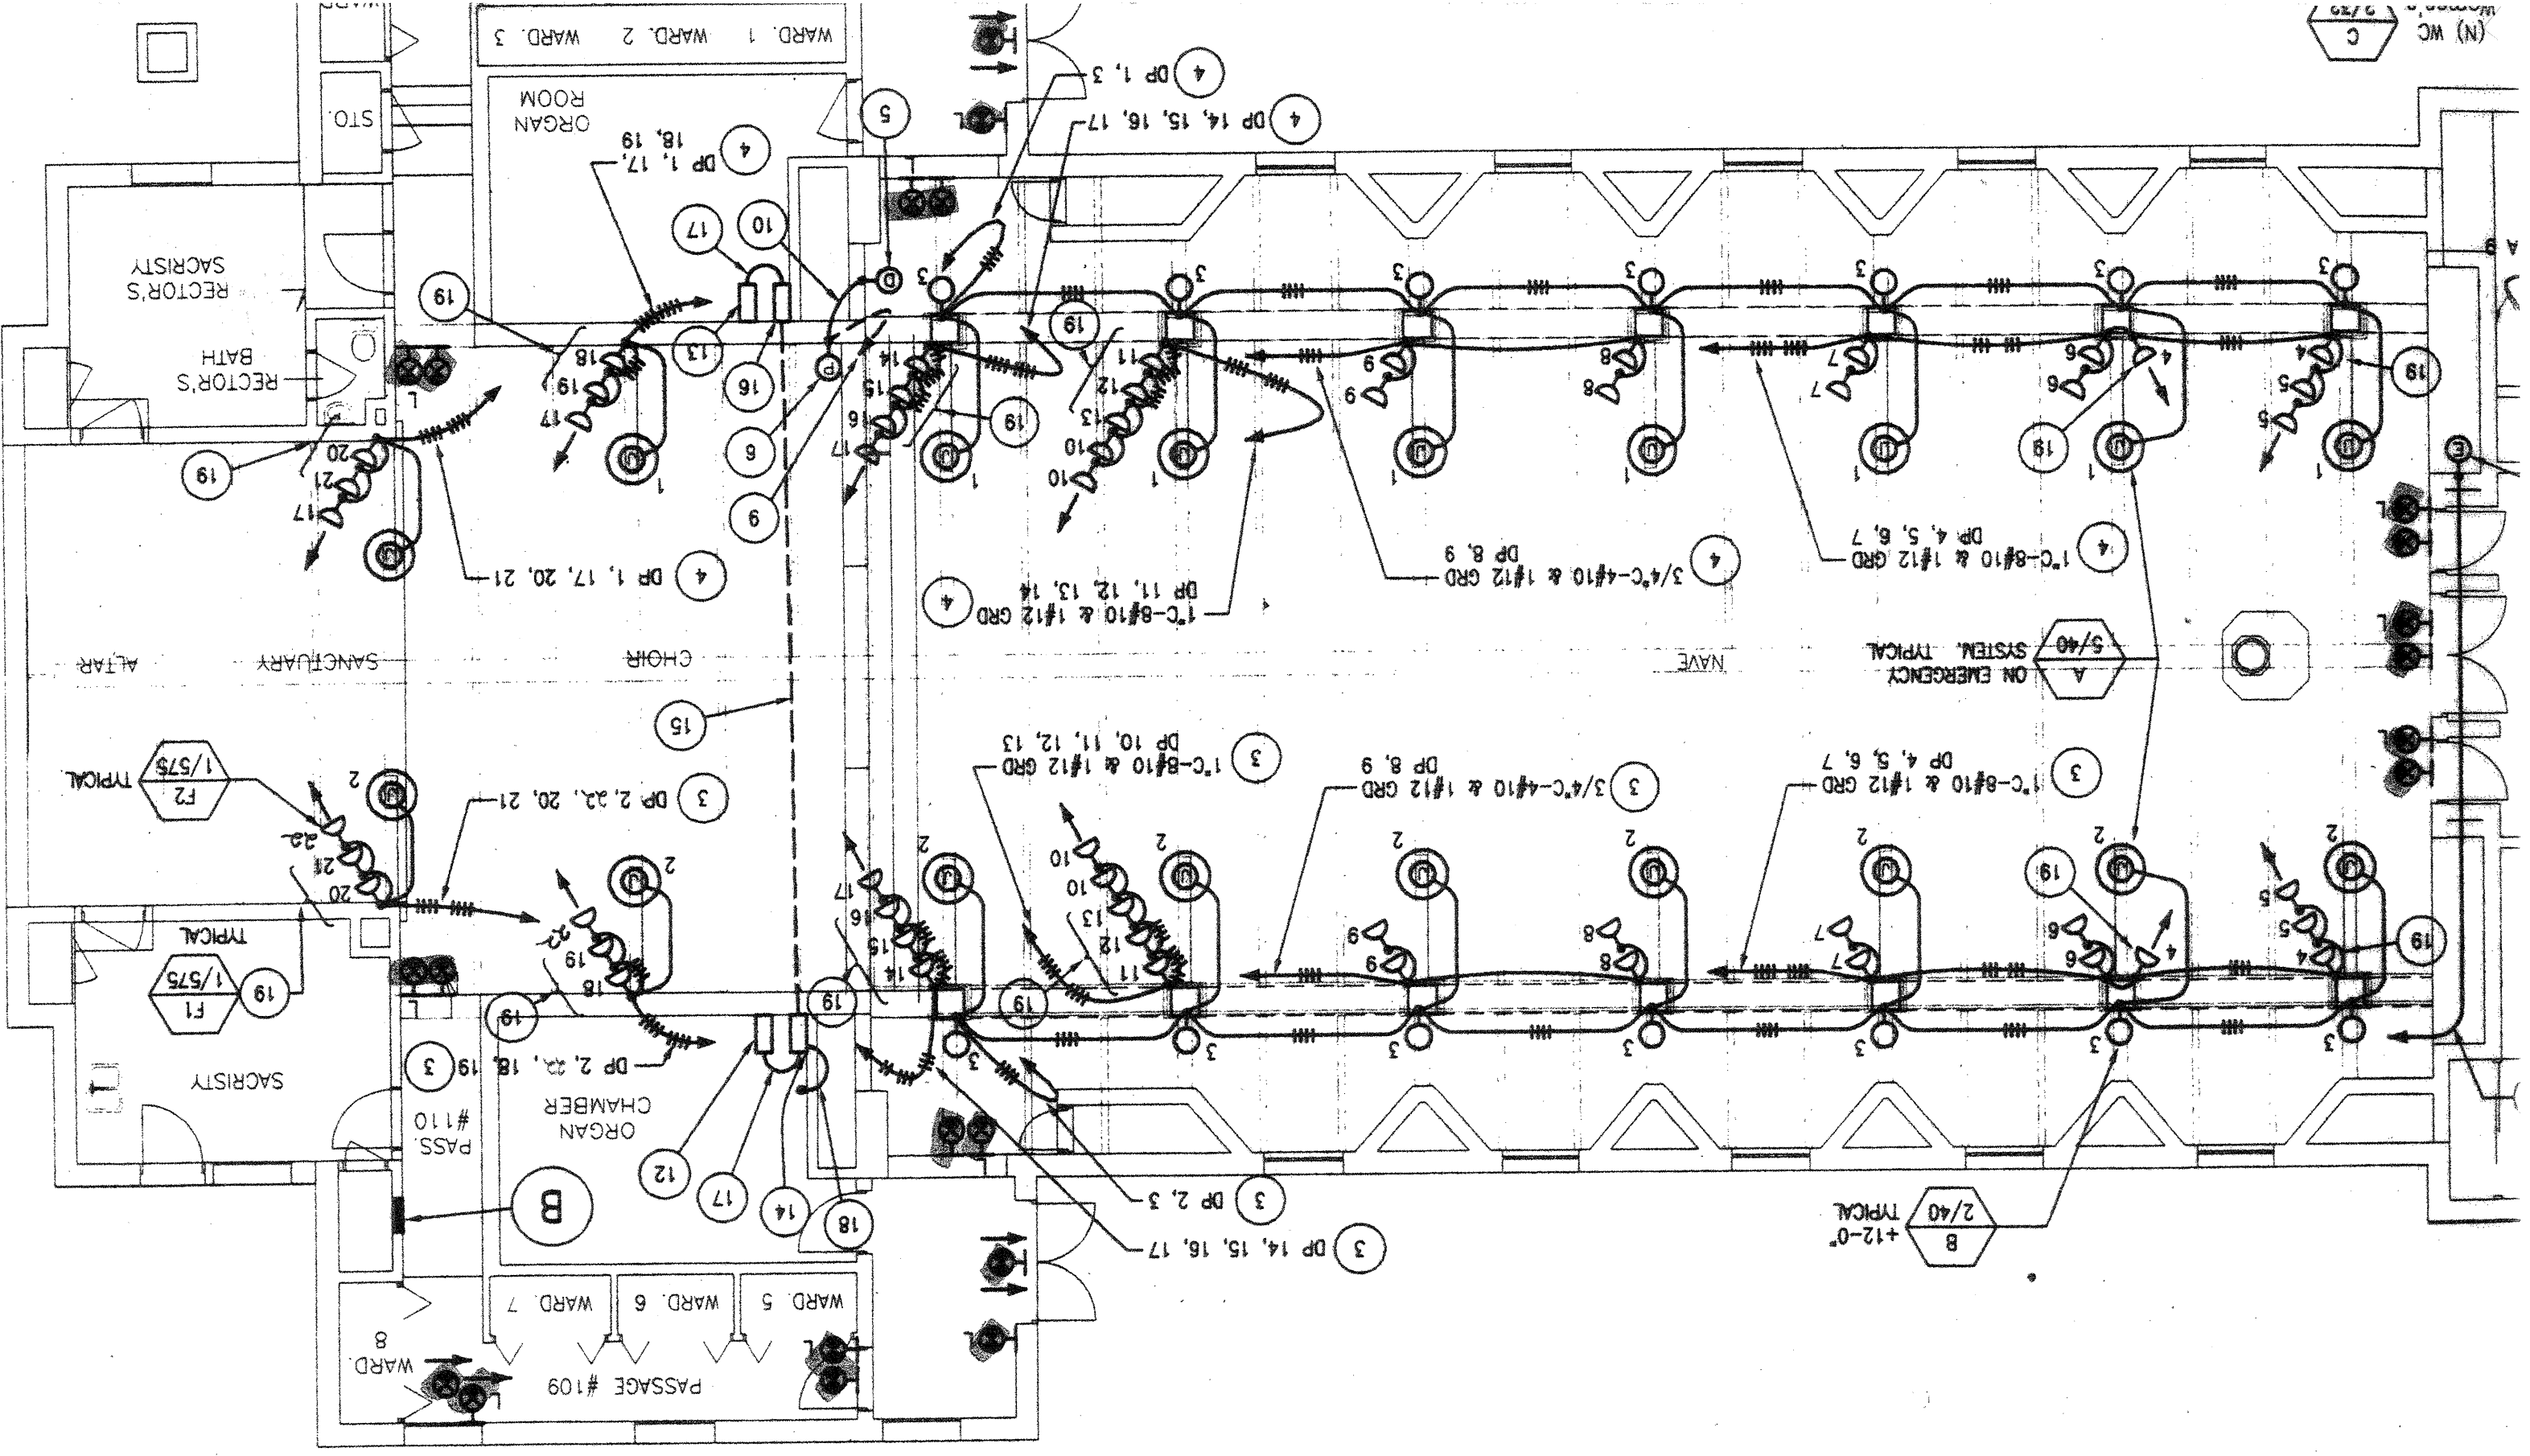

TAILORED METHOD

TOTAL ALLOWED WATTS
(From LTG-4 or from Computer Run)

0

For windows, use the Window Wall Ratio for the room.
For skylights, use the Skylight-to-Roof ratio for the room.

BUILDING TOTAL 3020

Enter on LTG-2: Actual Lighting Power calculation.

Nonresidential Compliance Form

December 1998