

Onuma & Associates

Architecture, Planning, Consulting
511 Mission Street
South Pasadena, CA 91030
tel 626.799.9920
fax 626.799.8260
e-mail: info@onuma.com

Consultants

RANDALL ENGINEERING
CONSULTING ELECTRICAL ENGINEER
2908 ALLESTON STREET
LOS ANGELES, CA 90008
TEL 323-667-0081 FAX 323-667-0083




AS-BUILT
MAMMOTH ELECTRIC, INC.
DATED:

REMODEL
FOR

SAINT EDMUND'S
EPISCOPAL CHURCH

1175 SAN GABRIEL BLVD., SAN MARINO, CA., 9108-9048

STAMPS

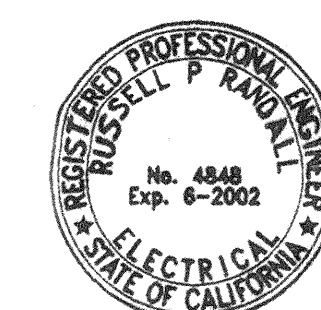

REVISIONS

DESCRIPTION	DATE	BY
PROJECT NUMBER	RE-123	
SCALE	NOT TO SCALE	
PRINTED	12/27/00	


TITLE
SINGLE LINE DIAGRAM
AND ELEVATION

SHEET

E-2

28 OF 44

K:\Drawings\99042 St Edmunds Church\9-02.dwg, DWG 12/28/00 13:58

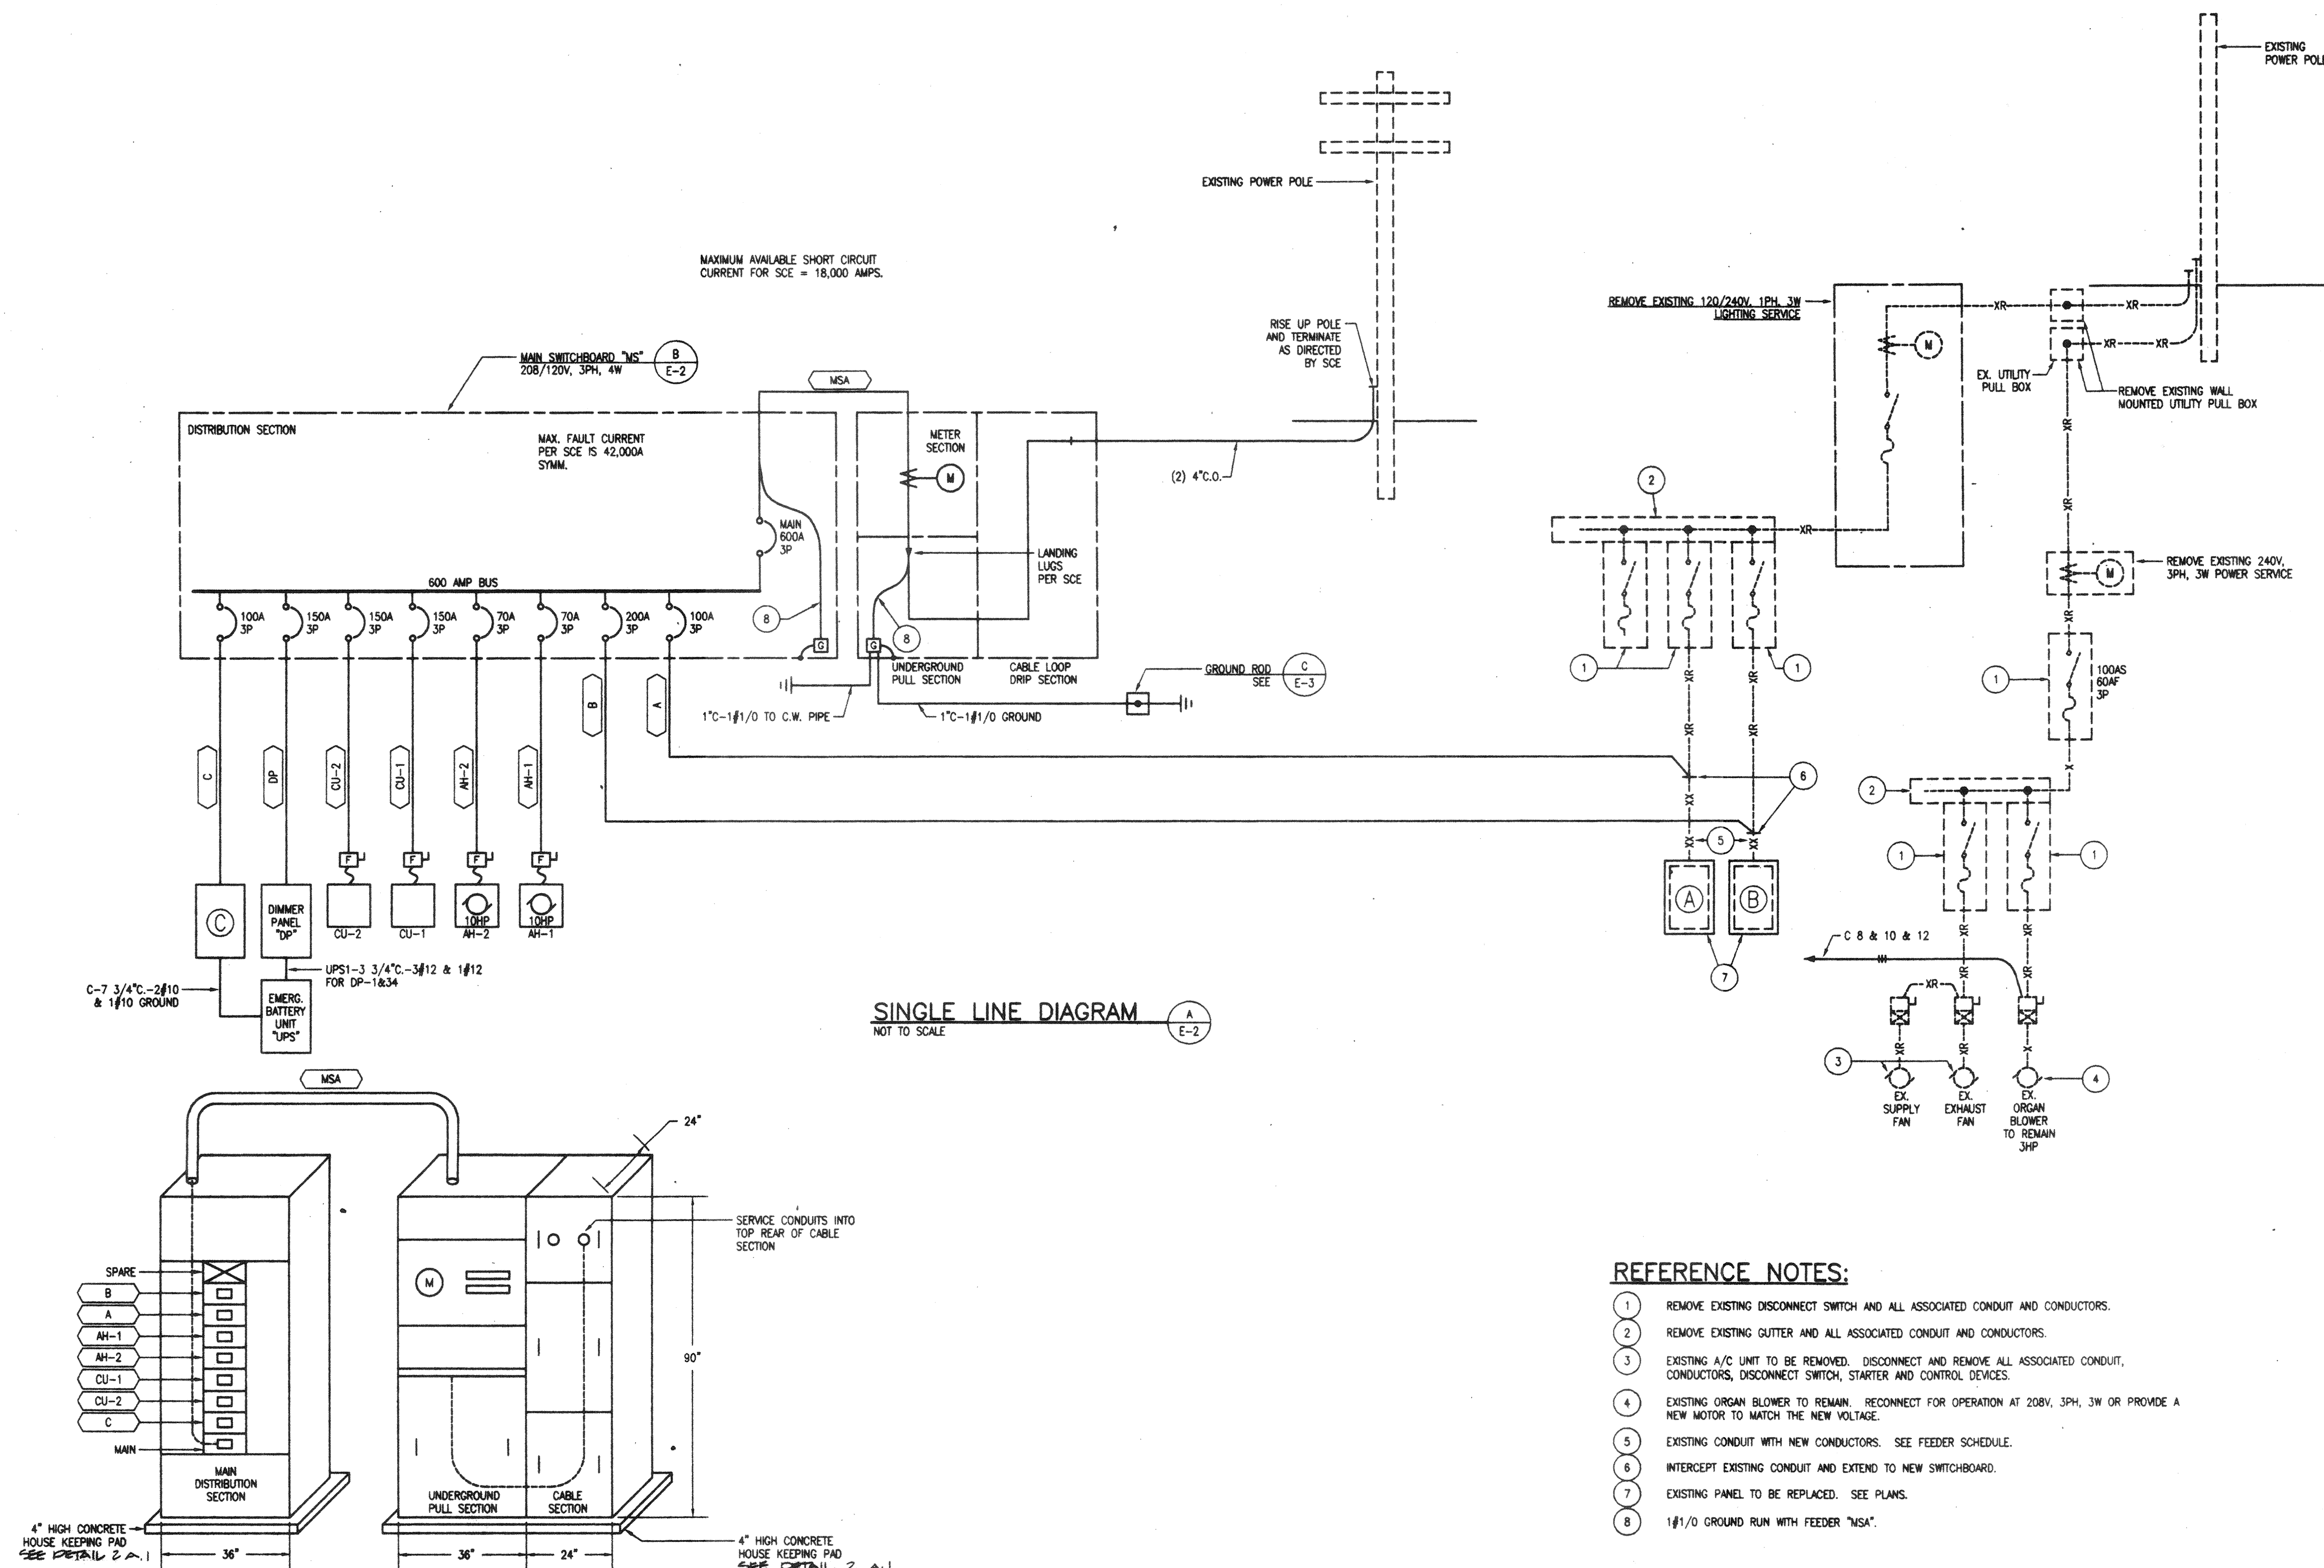

REFERENCE NOTES:

1. REMOVE EXISTING DISCONNECT SWITCH AND ALL ASSOCIATED CONDUIT AND CONDUCTORS.
2. REMOVE EXISTING GUTTER AND ALL ASSOCIATED CONDUIT AND CONDUCTORS.
3. EXISTING A/C UNIT TO BE REMOVED. DISCONNECT AND REMOVE ALL ASSOCIATED CONDUIT, CONDUCTORS, DISCONNECT SWITCH, STARTER AND CONTROL DEVICES.
4. EXISTING ORGAN BLOWER TO REMAIN. RECONNECT FOR OPERATION AT 208V, 3PH, 3W OR PROVIDE A NEW MOTOR TO MATCH THE NEW VOLTAGE.
5. EXISTING CONDUIT WITH NEW CONDUCTORS. SEE FEEDER SCHEDULE.
6. INTERCEPT EXISTING CONDUIT AND EXTEND TO NEW SWITCHBOARD.
7. EXISTING PANEL TO BE REPLACED. SEE PLANS.
8. 1#1/0 GROUND RUN WITH FEEDER "MSA".