

Onuma & Associates

Architecture, Planning, Consulting
511 Mission Street
South Pasadena, CA 91030
tel 626. 799. 9920
fax 626. 799. 6260
e-mail: info@onuma.com

Consultants

RANDALL ENGINEERING
CONSULTING ELECTRICAL ENGINEER
12000 WILSON AVENUE, SUITE 100
LOS ANGELES, CA 90039
323-667-9081 • Fax: 323-667-9083

REMODEL FOR
SAINT EDMUND'S
EPISCOPAL CHURCH
1175 SAN GABRIEL BLVD., SAN MARINO, CA, 91108-8048

STAMPS



REVISIONS

DESCRIPTION	DATE	BY
PROJECT NUMBER	RE-123	
SCALE	AS NOTED	
PRINTED	12/27/00	
TITLE	ELECTRICAL SITE PLAN AND DETAILS	

SHEET

E-3

39 OF 44



REFERENCE NOTES:

- GROUND RODS AS REQUIRED. SEE "C/E-3".
- 1" C-141/O SERVICE GROUND.
- ROUTE CONDUITS ON PIPE SUPPORT WITH REFRIGERANT LINES. CORE DRILL EXISTING WALL AS REQUIRED. PROVIDE WEATHERPROOF SEALANT AROUND CONDUIT OPENINGS.
- RISE ON POLE AS DIRECTED BY SCE.
- WEATHERPROOF 200AS, 125A-3P, MOUNTED DISCONNECT SWITCH ON NON-REMOVAL SECTION OF CONDENSING UNIT AS DIRECTED BY THE MECHANICAL CONTRACTOR OR PROVIDE A SEPARATE UNISTRUT SUPPORT STRUCTURE FOR THE DISCONNECT SWITCH. CONNECT TO UNIT WITH LIQUIDTIGHT FLEXIBLE CONDUIT. VERIFY THE EXACT FUSES REQUIRED BEFORE ORDERING.

NOTE:


- FOR SOLID CONCRETE WALLS, CENTER 3M # CP-25 N/S WITHIN WALL WITH DAMMING MATERIAL ON ONE SIDE
 - RECOMMENDATIONS BASED ON PRODUCT PERFORMANCE PER ASTM E-814 (UL 1479) FIRE TEST AND UL CLASSIFICATION FIRE STOP SYSTEM 49.
 - WET INSTALLED DEPTH OF CP-25 CAULKS DEPENDS ON TYPE AND SIZE OF PIPES AND DESIRED FIRE RATING.

WET DEPTH	PIPE SIZE	FIRE RATING
1/2" (13mm)	MAX 8" (203mm)	1-2 HRS.
1" (25mm)	MAX 8" (203mm)	3-4 HRS.
 - UP TO 40% SHRINKAGE OF CP-25 N/S OR S/L CAULK IS ACCEPTABLE AFTER INITIAL WET DEPTH INSTALLATION.
 - MAXIMUM ANNULAR SPACE TO BE FILLED IS 2 1/2" (64mm)
- 1,2,3, OR 4 HOUR FIRES 3M FIRE BARRIER CP-25 N/S AND S/L CAULK
- HOUR RATED CONCRETE FLOOR AND WALL PENETRATION FIRESTOP FOR METAL PIPE/CONDUIT THROUGH 1,2,3, OR 4

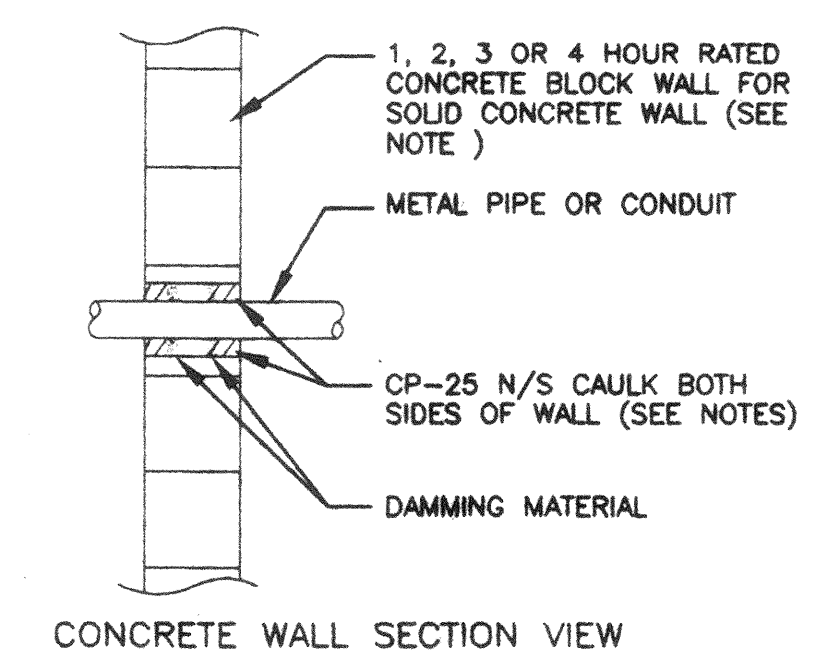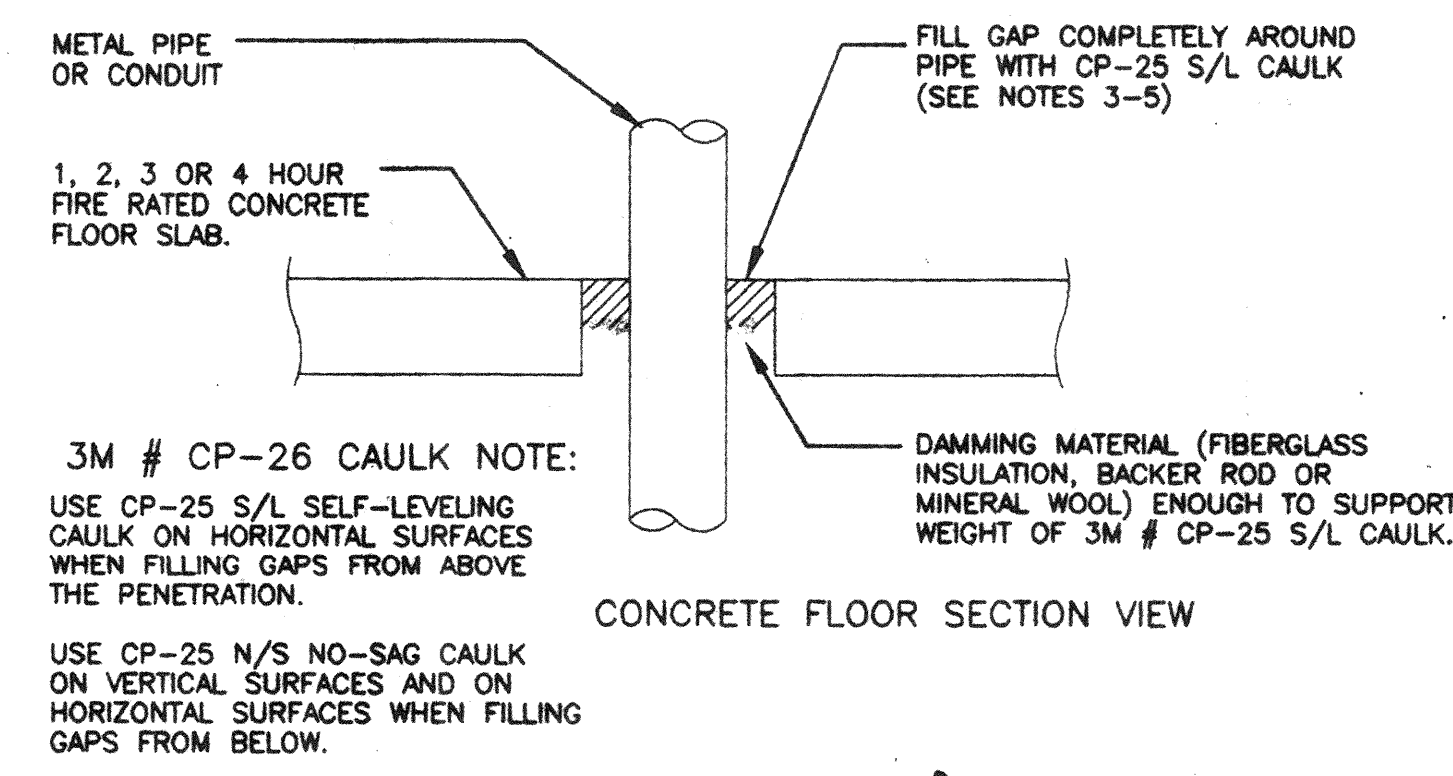


CONDUIT THROUGH RATED WALL DETAIL
NOT TO SCALE

C
E-3

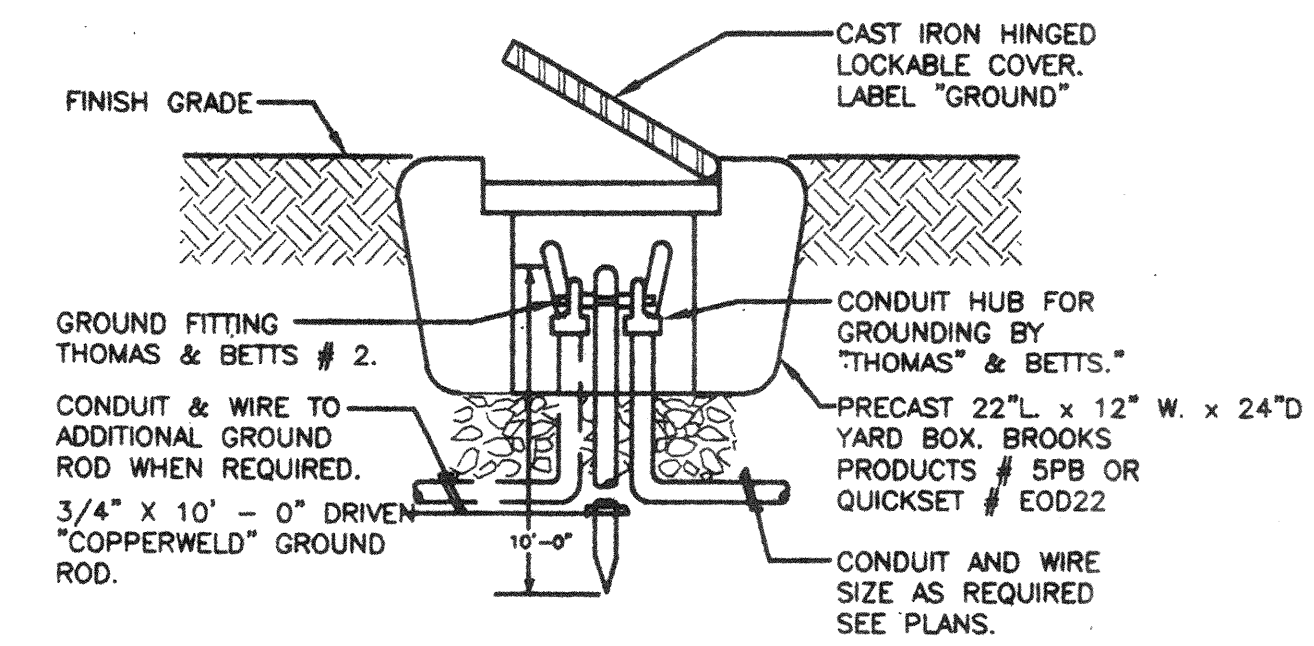

GROUND ROD DETAIL
NOT TO SCALE

B
E-3

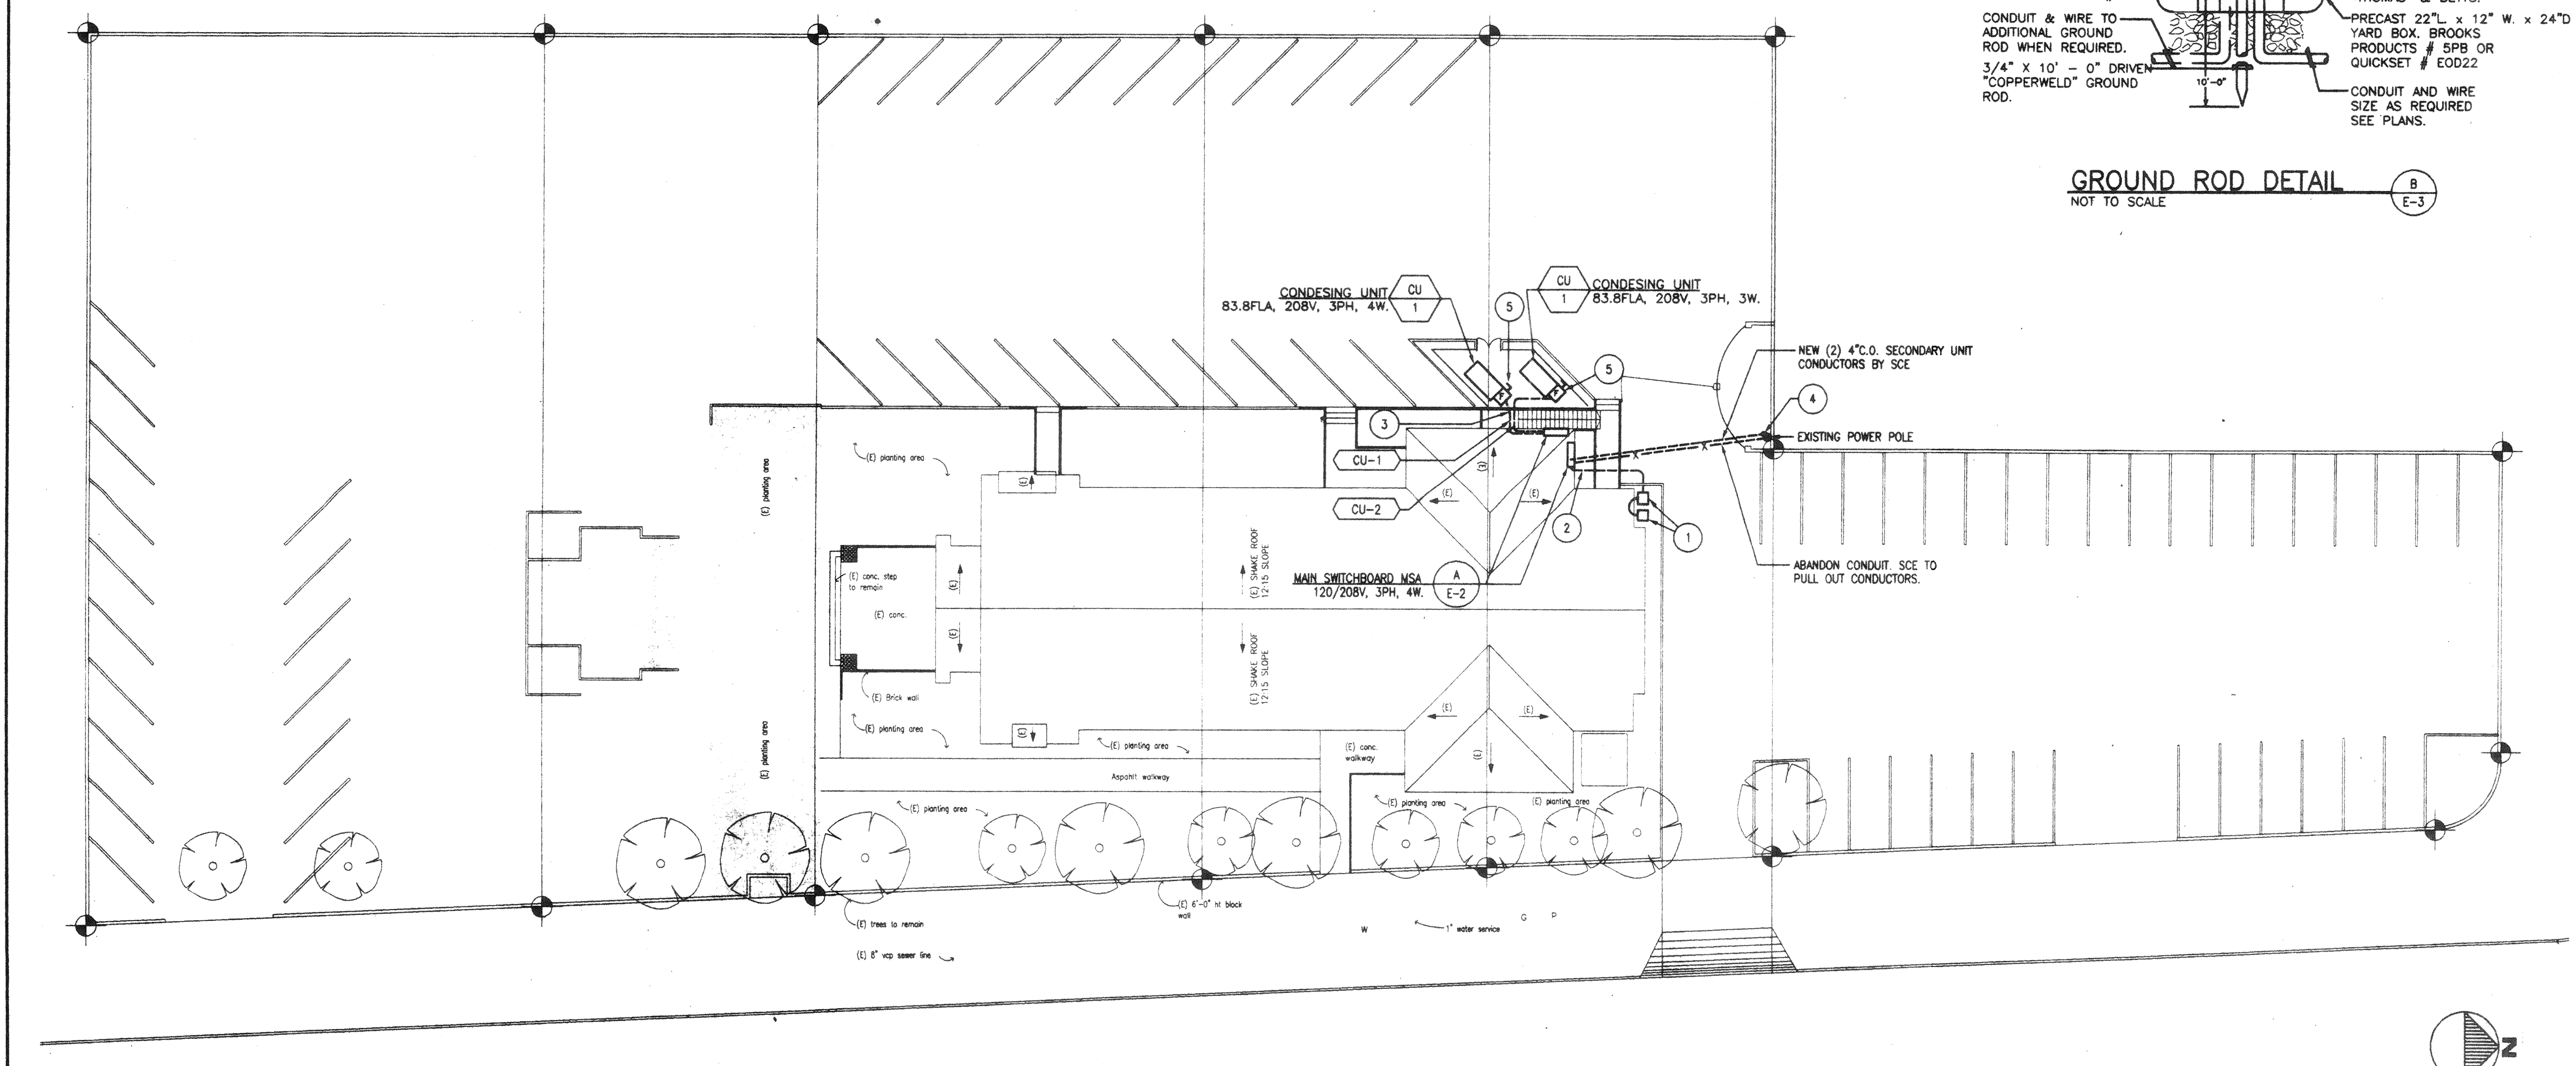

(A) ELECTRICAL SITE PLAN

1" = 20' - 0"