



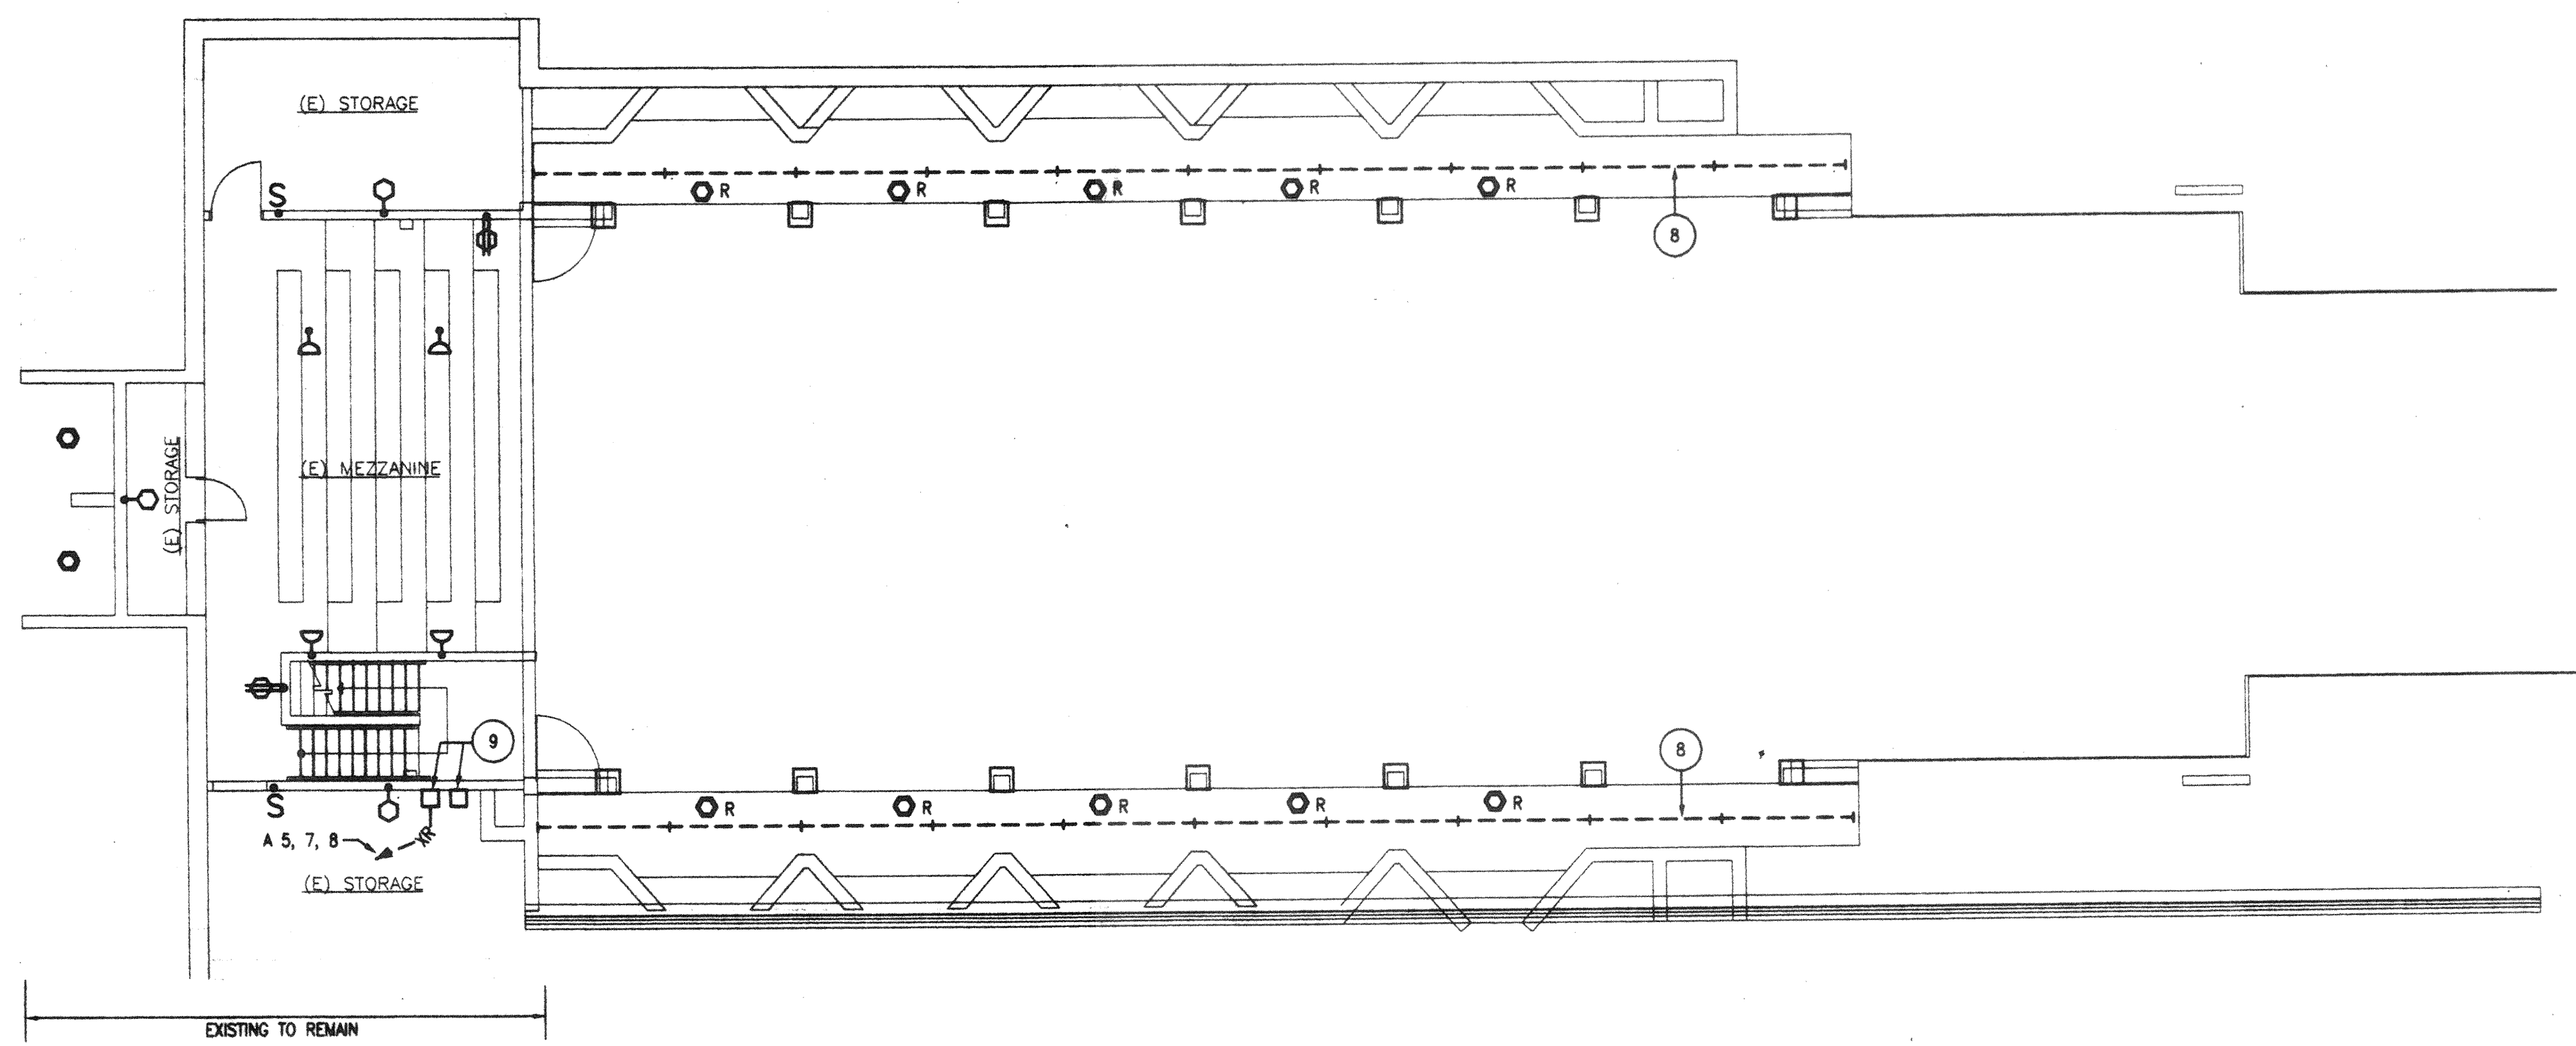

1 MEZZANINE DEMOLITION FLOOR PLAN 1/8" = 1'-0"

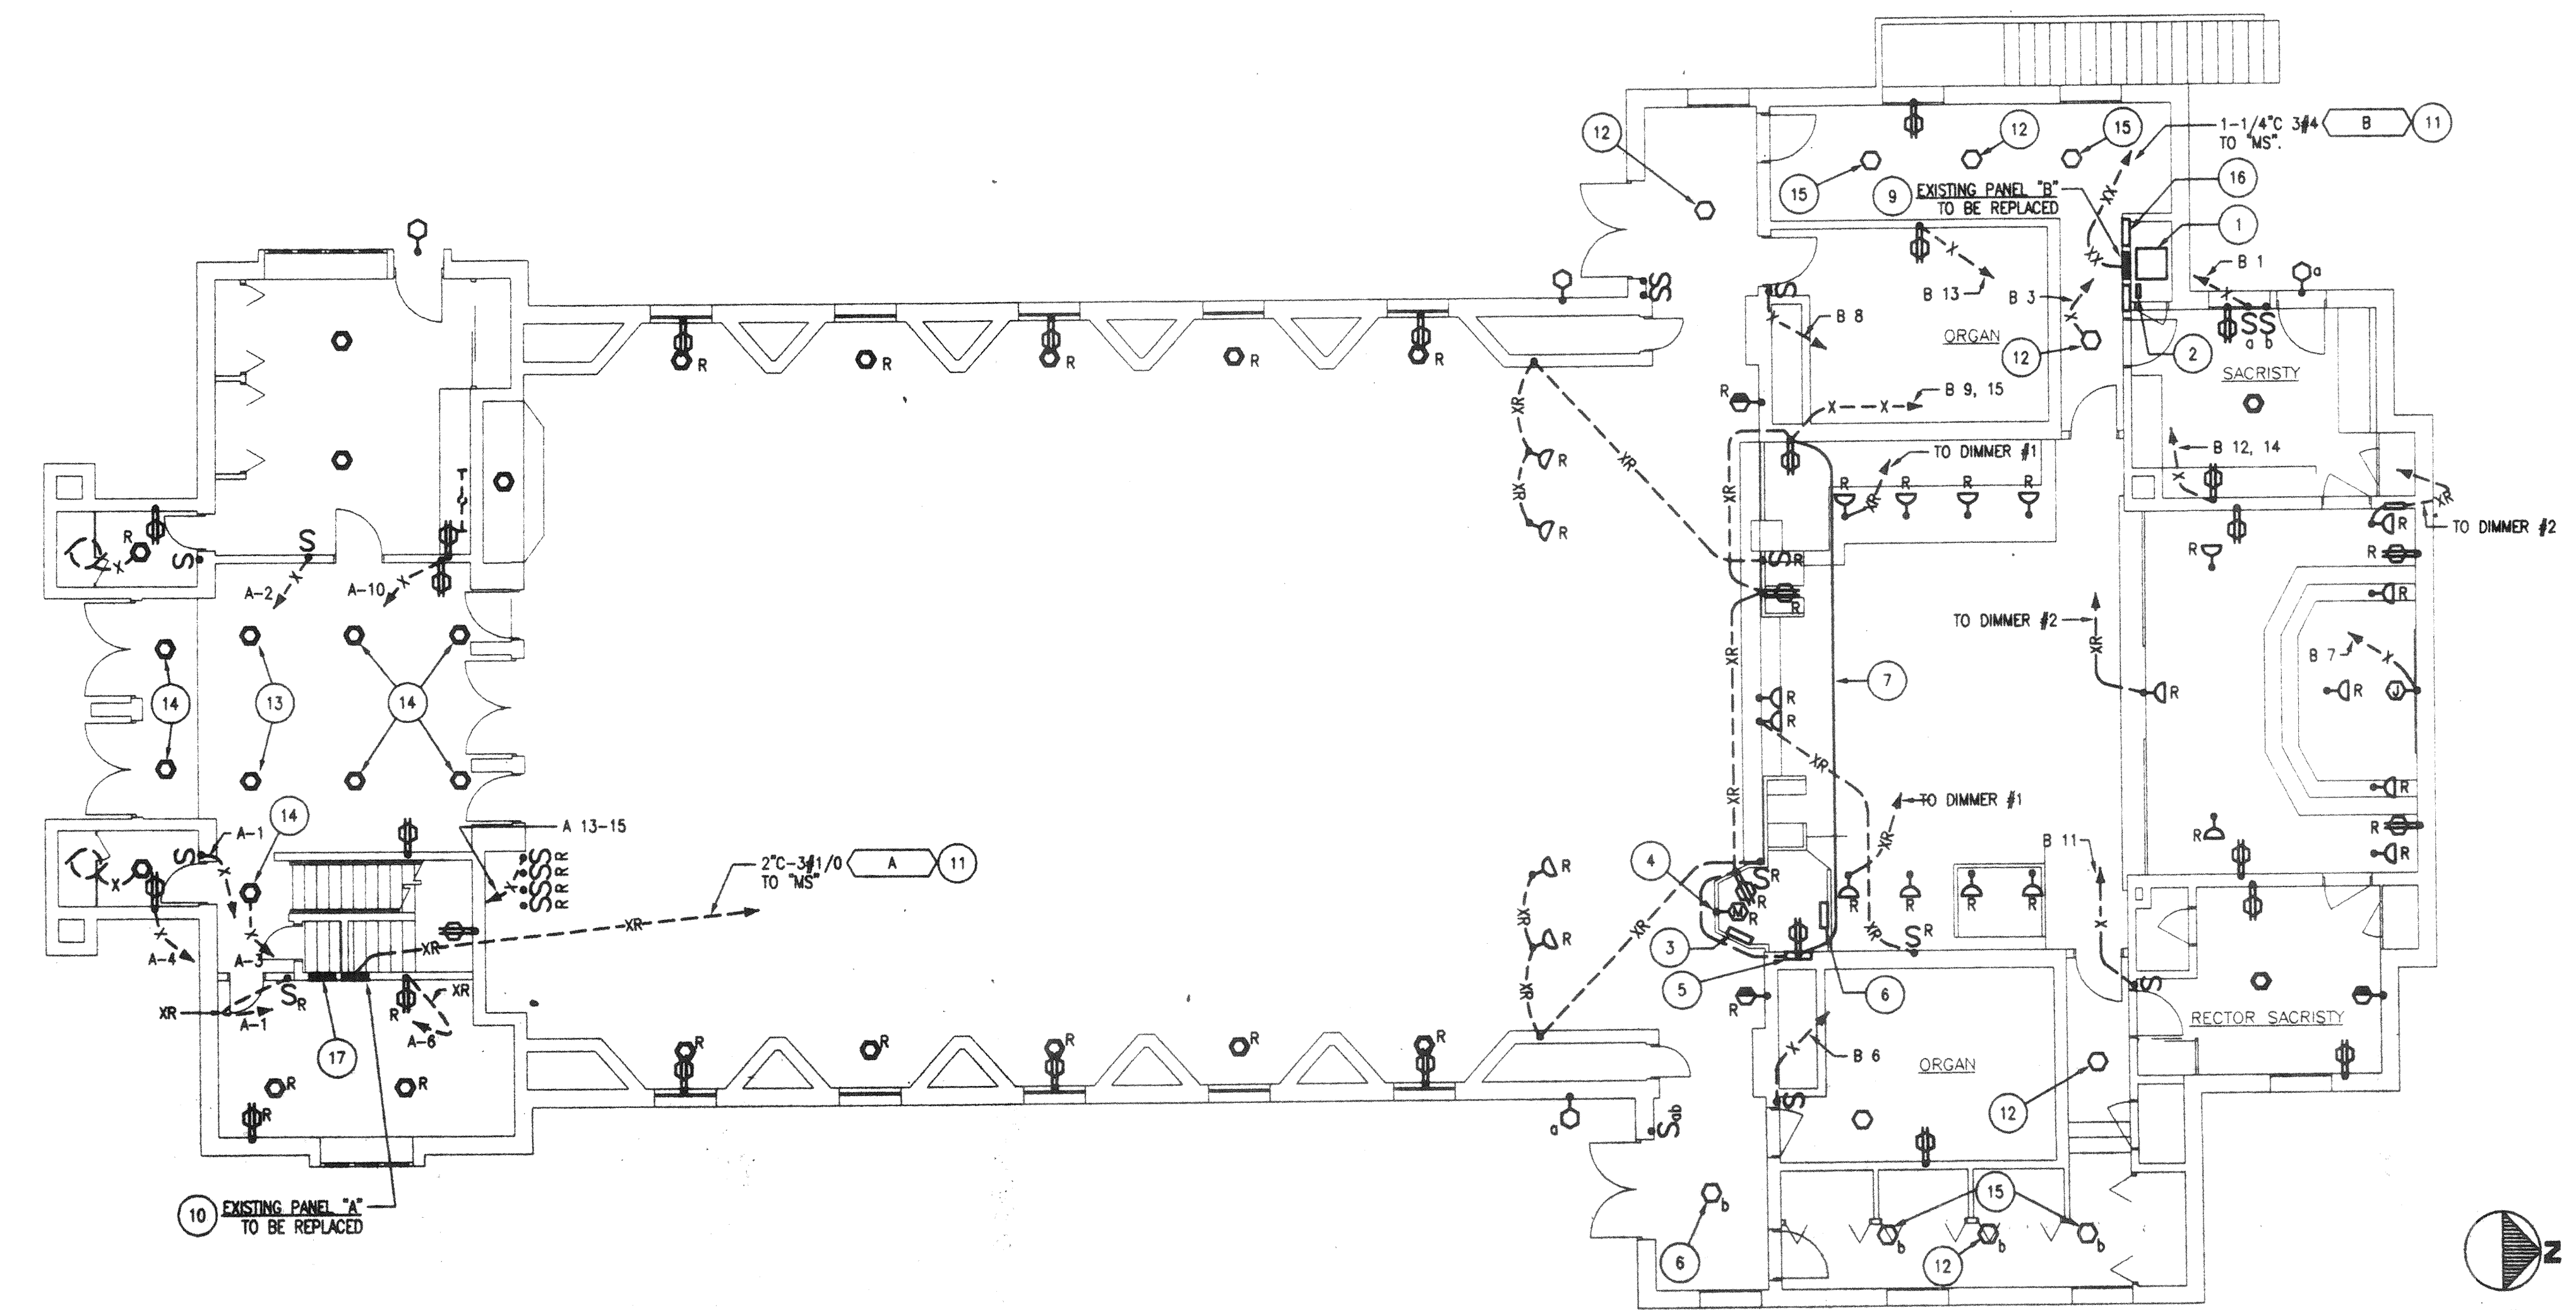

2 DEMOLITION FLOOR PLAN 1/8" = 1'-0"

REFERENCE NOTES:

- 1 REMOVE EXISTING DIMMER RACK AND ALL ASSOCIATED POWER AND CONDUIT AND CONDUCTORS.
- 2 REMOVE EXISTING LOAD CENTER AND ALL ASSOCIATED CONDUIT AND CONDUCTORS.
- 3 REMOVE EXISTING TAPE DECK AND ALL ASSOCIATED CONDUIT AND CONDUCTORS.
- 4 REMOVE EXISTING MICROPHONE OUTLET AND ALL ASSOCIATED CONDUIT AND CONDUCTORS.
- 5 REMOVE EXISTING P.A. AMPLIFIER AND ALL ASSOCIATED CONDUIT AND CONDUCTORS.
- 6 REMOVE EXISTING DIMMER CONTROL STATION AND ALL ASSOCIATED CONDUIT AND CONDUCTORS.
- 7 PROVIDE NEW CONDUIT AND CONDUCTORS TO MAINTAIN CIRCUIT CONTINUITY. ROUTE IN NEW CONCRETE.
- 8 REMOVE EXISTING FLUORESCENT FIXTURES AND ALL ASSOCIATED DIMMERS, TRANSFORMERS, CONDUIT AND CONDUCTORS.
- 9 DISCONNECT AND REMOVE EXISTING PANEL AND INSTALL NEW 120/208V, 3PH, 4W PANEL. RECONNECT EXISTING BRANCH CIRCUITS TO NEW CIRCUIT BREAKERS, SAME SIZE AS BEFORE.
- 10 DISCONNECT AND REMOVE EXISTING PANEL AND INSTALL NEW 120/208V, 3PH, 4W PANEL. RECONNECT EXISTING BRANCH CIRCUITS TO NEW CIRCUIT BREAKERS, SAME SIZE AS BEFORE. NEW PANEL IS TO BE INSTALLED 12" NORTH OF ITS PRESENT LOCATION TO ACCOMMODATE A NEW WALL. EXTEND ALL CONDUITS AND PROVIDE NEW CONDUCTORS AS REQUIRED.
- 11 REMOVE EXISTING CONDUCTORS AND INSTALL NEW CONDUCTORS AS INDICATED ON THE SINGLE LINE DIAGRAM.
- 12 REMOVE EXISTING SURFACE MOUNTED LIGHT FIXTURE AND INSTALL NEW SURFACE MOUNTED FLUORESCENT FIXTURE TYPE "HH-2/26" WITH EMERGENCY BATTERY PACK. PULL INTO THE EXISTING BRANCH CIRCUIT CONDUIT AN ADDITIONAL 1#12 UNSWITCHED HOT CIRCUIT FOR THE EMERGENCY BATTERY PACK.
- 13 REMOVE EXISTING RECESS LIGHT FIXTURE AND INSTALL NEW RECESS FLUORESCENT FIXTURE TYPE "DD-2/26" WITH EMERGENCY BATTERY PACK. PULL INTO THE EXISTING BRANCH CIRCUIT CONDUIT AN ADDITIONAL 1#12 UNSWITCHED HOT CIRCUIT FOR THE EMERGENCY BATTERY PACK.
- 14 REMOVE EXISTING RECESS LIGHT FIXTURE AND INSTALL NEW RECESS FLUORESCENT FIXTURE TYPE "D-2/26".
- 15 REMOVE EXISTING SURFACE MOUNTED LIGHT FIXTURE AND INSTALL NEW SURFACE MOUNTED FLUORESCENT LIGHT FIXTURE TYPE "H-2/26".
- 16 EXISTING TIME SWITCH CABINET, CONTROL TRANSFORMER AND FLUSH GUTTER ASSEMBLY TO REMAIN.
- 17 EXISTING TIME SWITCH CABINET. REMOVE AND RELOCATE TO ACCOMMODATE NEW WALL. INTERCEPT CONDUIT AND CONDUCTORS AND EXTEND AS REQUIRED.

AS-BUILT
MAMMOTH ELECTRIC, INC.

Onuma & Associates
Architecture, Planning, Consulting

511 Mission Street
South Pasadena, CA 91030
tel 626. 799. 9920
fax 626. 799. 8260
e-mail: info@onuma.com

Consultants

RANDALL ENGINEERING
CONSULTING ELECTRICAL ENGINEER
2208 ALISSANDRO STREET
LOS ANGELES, CA 90009
323-667-9061 • Fax: 323-667-9063

**REMODEL FOR
SAINT EDMUND'S
EPISCOPAL CHURCH**
1175 SAN GABRIEL BLVD., SAN MARINO, CA., 91108-8048

STAMPS



REVISIONS

DESCRIPTION	DATE	BY
PROJECT NUMBER	RE-123	
SCALE	AS NOTED	
PRINTED	12/27/00	
TITLE	DEMOLITION FLOOR PLAN AND DETAILS	
SHEET		

E-4

40 OF 44