

REFERENCE NOTES:

- 1 TO PUBLIC ADDRESS RACK IN MEZZANINE STORAGE ROOM.
- 2 OUTLET BOX FOR FUTURE SUSPENDED MICROPHONE. MOUNT OUTLET ON BACK (NORTH) SIDE OF BEAM.


Onuma & Associates
Architecture, Planning, Consulting
511 Mission Street
South Pasadena, CA 91030
tel 626. 799. 9920
fax 626. 799. 8260
e-mail: info@onuma.com

Consultants

RANDALL ENGINEERING
CONSULTING ELECTRICAL ENGINEER
1235 WILSON STREET
LOS ANGELES, CA 90009
323-667-9081 • Fax: 323-667-9083



AS-BUILT
MAMMOTH ELECTRIC, INC.
DATED:

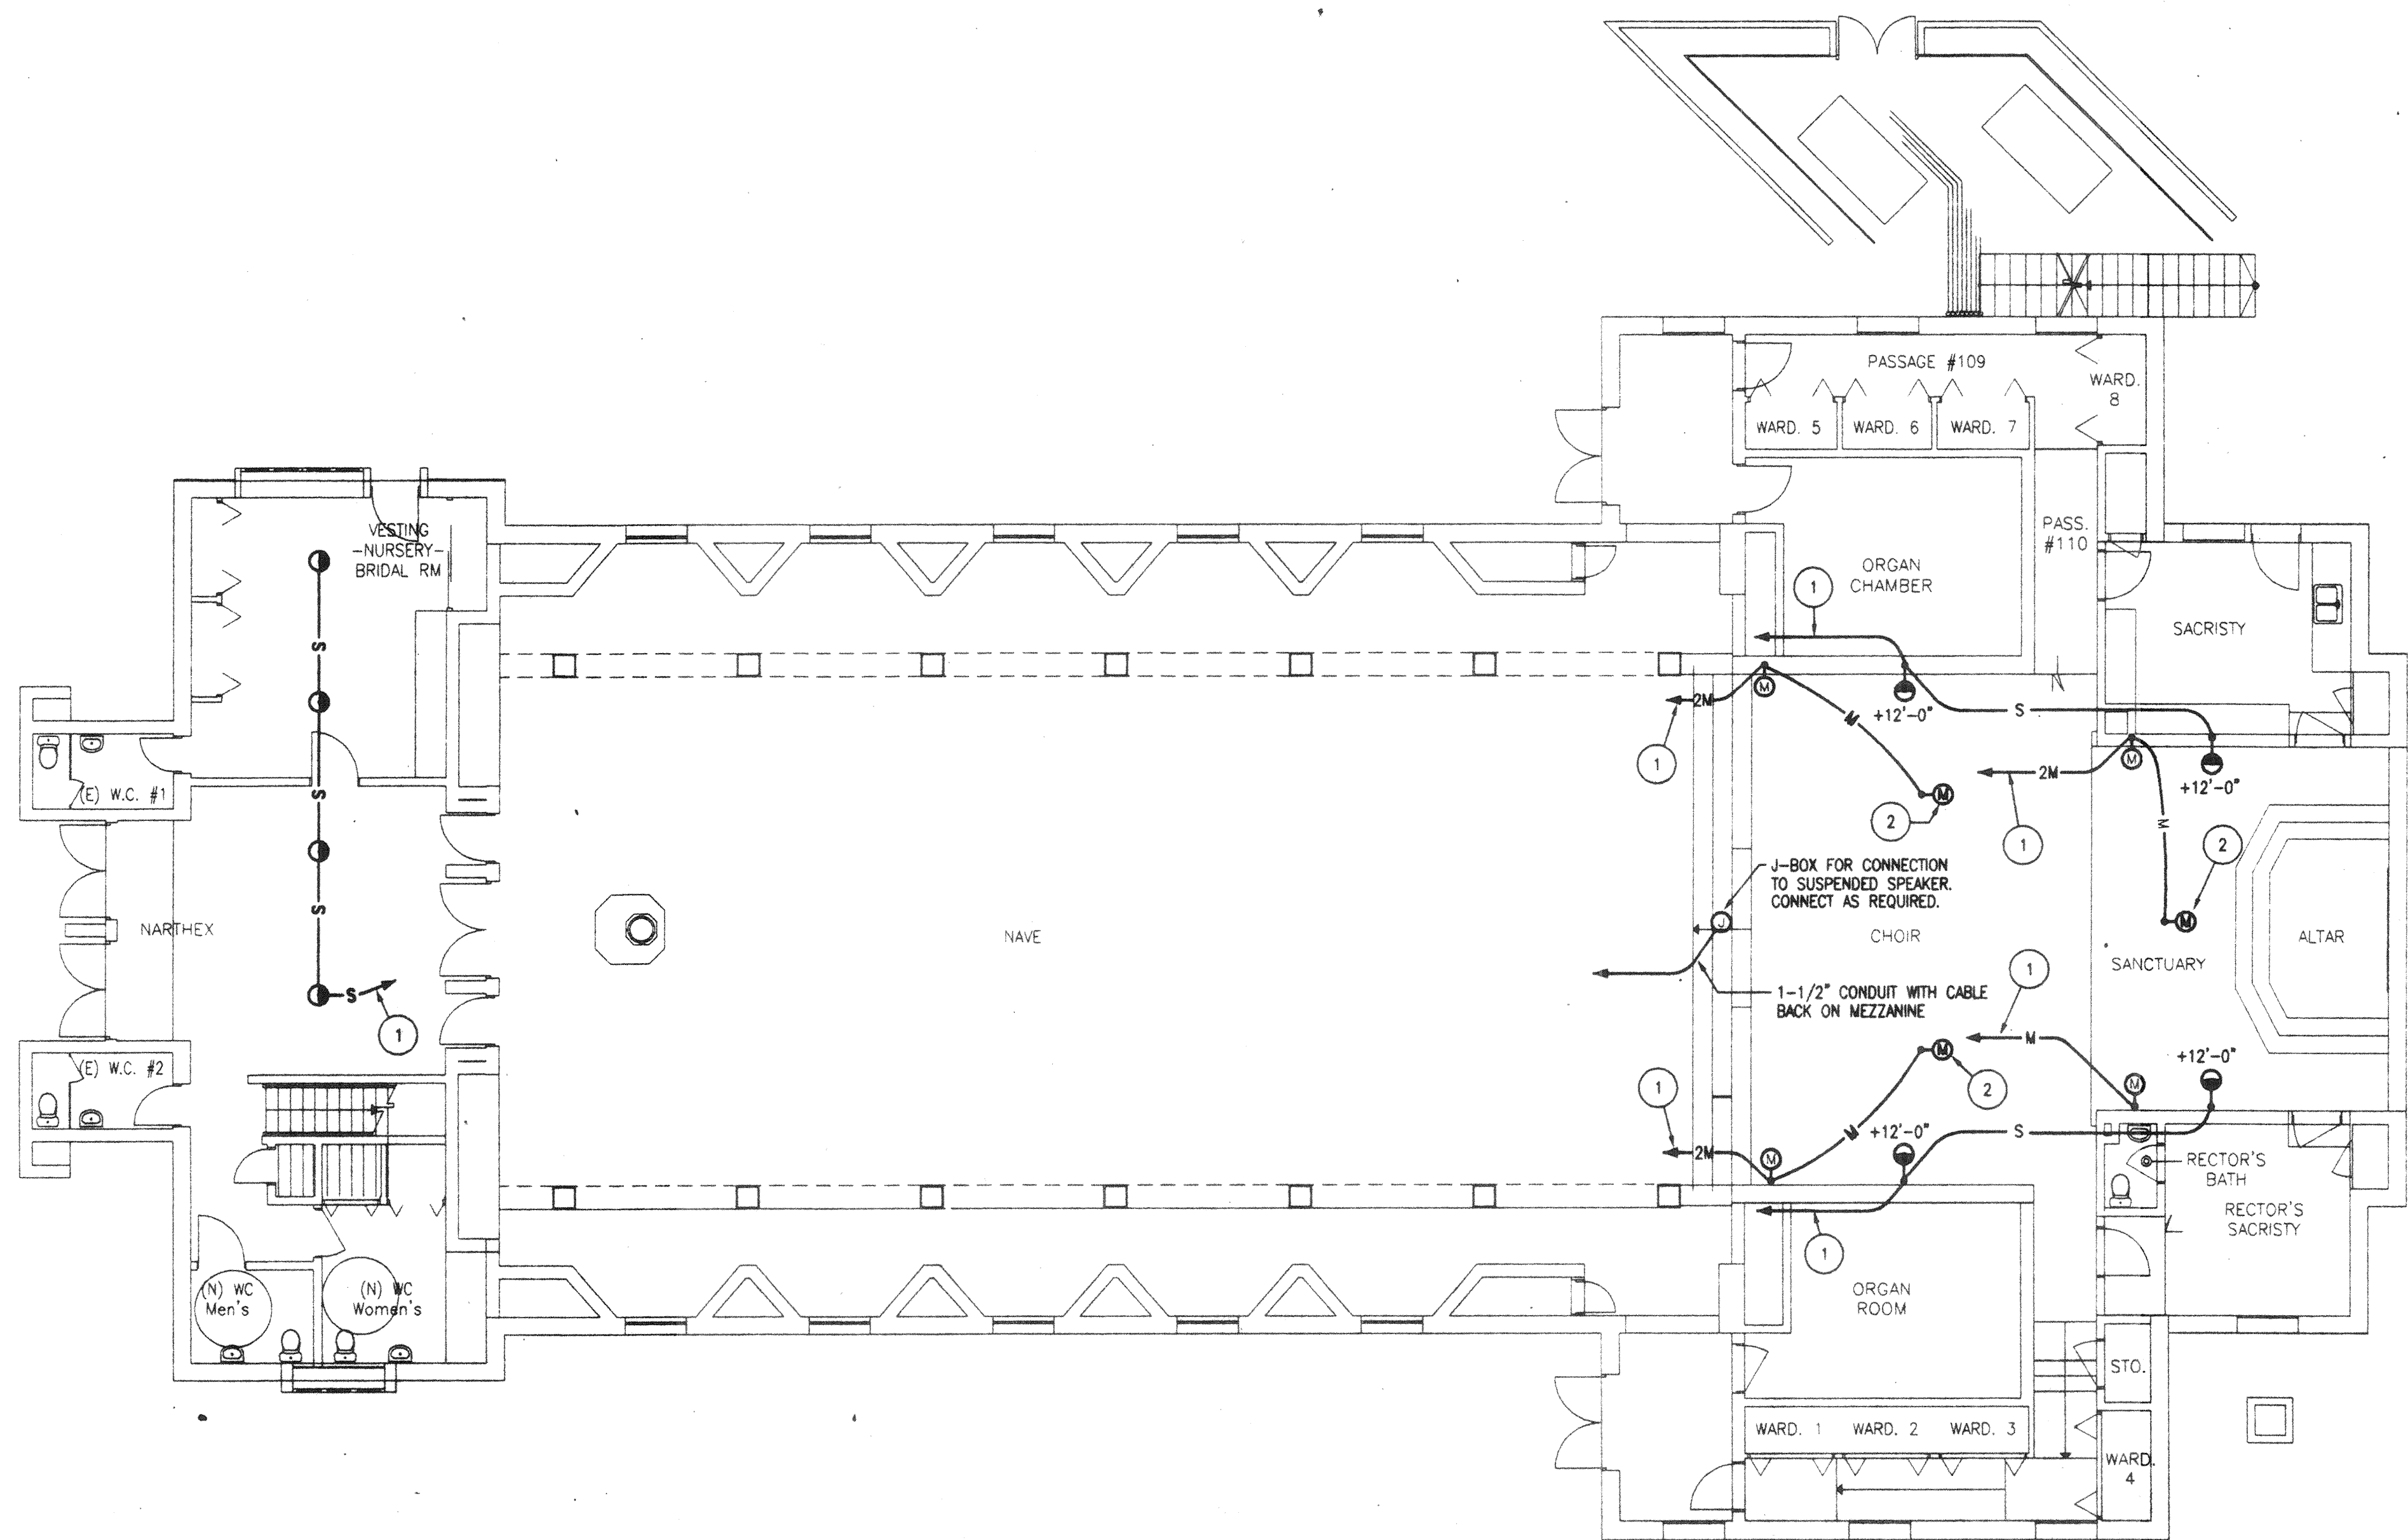

REMODEL
FOR
SAINT EDMUND'S
EPISCOPAL CHURCH
1175 SAN GABRIEL BLVD., SAN MARINO, CA., 91108-8048

STAMPS



REVISIONS

DESCRIPTION	DATE	BY
PROJECT NUMBER	RE-123	
SCALE	AS NOTED	
PRINTED	12/27/00	
TITLE	COMMUNICATION FLOOR PLAN	

SHEET

E-6

42 OF 44

1 COMMUNICATION FLOOR PLAN

1/8" = 1'-0"

K:\Drawings\99042 St. Edmunds Church\1-e-06.dwg.DWG 1=96