


REFERENCE NOTES:

- 1 HEARING ASSISTANCE SYSTEM TRANSMITTER. VERIFY EXACT LOCATION PRIOR TO INSTALLATION.
- 2 TO PA RACK.
- 3 3/4" CONDUIT WITH (2) SPEAKER CABLE TO THE SPEAKERS ON THE WEST SIDE OF THE BUILDING. SEE SHEET E-6 FOR CONTINUATION.
- 4 DIMMER CONTROL "DMX" OUTLET IN A FLOOR MONUMENT.
- 5 3/4" CONDUIT WITH BELDON #9729 TO DIMMER PANEL "DP" IN BASEMENT. SEE DETAIL "1/E-7".
- 6 3/4" CONDUIT WITH (2) SPEAKER CABLE TO THE SPEAKERS ON THE EAST SIDE OF THE BUILDING. SEE SHEET E-6 FOR CONTINUATION.
- 7 3/4" CONDUIT WITH (2) SPEAKER CABLE TO THE SPEAKERS ON THE EAST SIDE OF THE BUILDING. SEE SHEET E-6 FOR CONTINUATION.
- 8 (2) 3/4" CONDUITS WITH MICROPHONE CABLE TO THE MICROPHONE OUTLETS ON THE WEST SIDE OF THE BUILDING. SEE SHEET E-6 FOR CONTINUATION.
- 9 (2) 3/4" CONDUITS WITH MICROPHONE CABLE TO THE MICROPHONE OUTLETS ON THE EAST SIDE OF THE BUILDING. SEE SHEET E-6 FOR CONTINUATION.
- 10 1-1/2" CONDUIT WITH CABLE TO THE JUNCTION BOX FOR SUSPENDED SPEAKER ASSEMBLY. SEE SHEET E-6 FOR LOCATION.
- 11 GROMMETTED OPENING IN DESK TOP FOR POWER AND CONTROL CABLE.
- 12 RECONNECT EXISTING EQUIPMENT AND DEVICES AND LIGHTS TO NEW PANEL "C" AS REQUIRED.
- 13 CONNECT MOTOR FOR OPERATION AT 208V, 3PH, 3W OR REPLACE MOTOR TO MATCH THE NEW VOLTAGE.
- 14 COMBINATION STARTER/DISCONNECT SWITCH, SIZE 1 STARTER WITH CONTROL TRANSFORMER AND AUX CONTACTS, 30A-3P DISCONNECT SWITCH.
- 15 TO MECHANICAL A/C CONTROL PANEL.
- 16 MECHANICAL A/C CONTROL PANEL. VERIFY EXACT LOCATION PRIOR TO ROUGH-IN.
- 17 DUCT SMOKE DETECTOR WITH HOUSING, DETECTOR AND SAMPLING TUBES TO MATCH DUCT WIDTH PROVIDED BY ELECTRICAL CONTRACTOR, INSTALLED ON THE DUCT BY THE MECHANICAL CONTRACTOR AND CONNECTED BY THE ELECTRICAL CONTRACTOR. DUCT SMOKE DETECTOR SHALL BE NOTIFIER DHA00ACDP, 120V, ST-#.
- 18 UPS 1 & 2 EMERGENCY CIRCUITS TO DIMMER PANEL DP 1 & 2 OUTPUT CIRCUIT.
- 19 DIMMER PANEL "DP".
- 20 SOUND SYSTEM MIXING BOARD.
- 21 DIMMING SYSTEM CONTROL CONSOLE.
- 22 EXISTING SUMP PUMP TO REMAIN. CONNECT TO NEW PANEL "C" AS REQUIRED.
- 23 EXISTING ORGAN BLOWER AND ASSOCIATED CONTROL DEVICES TO REMAIN. RECONNECT BLOWER TO NEW PANEL "C" AND RE-WIRE MOTOR FOR OPERATION AT 208 VOLT OR REPLACE MOTOR.
- 24 DISCONNECT EXISTING A/C EQUIPMENT AND REMOVE ALL ASSOCIATED CONDUIT, CONDUCTORS AND CONTROL DEVICE.
- 25 DISCONNECT AND REMOVE EXISTING SERVICE SWITCHGEAR, METER, PULL BOXES, BACKBOARD DISCONNECT SWITCHES AND ALL USED CONDUIT AND CONDUCTORS. CONDUIT TO EXISTING PANEL "A" AND "B" TO BE RE-ROUTED TO NEW SWITCHBOARD "MSA". SEE SINGLE LINE DIAGRAM.
- 26 DISCONNECT AND REMOVE EXISTING DIMMERS AND ALL ASSOCIATED CONDUIT AND CONDUCTORS.
- 27 EXISTING LIGHTING AND RECEPTACLES IN BASEMENT TO BE CONNECTED TO NEW PANEL "C" AS REQUIRED.
- 28 EMERGENCY BATTERY UNIT "UPS", 3.7KW, 120/208V WITH TWO OUTPUT CIRCUITS 1 & 2.

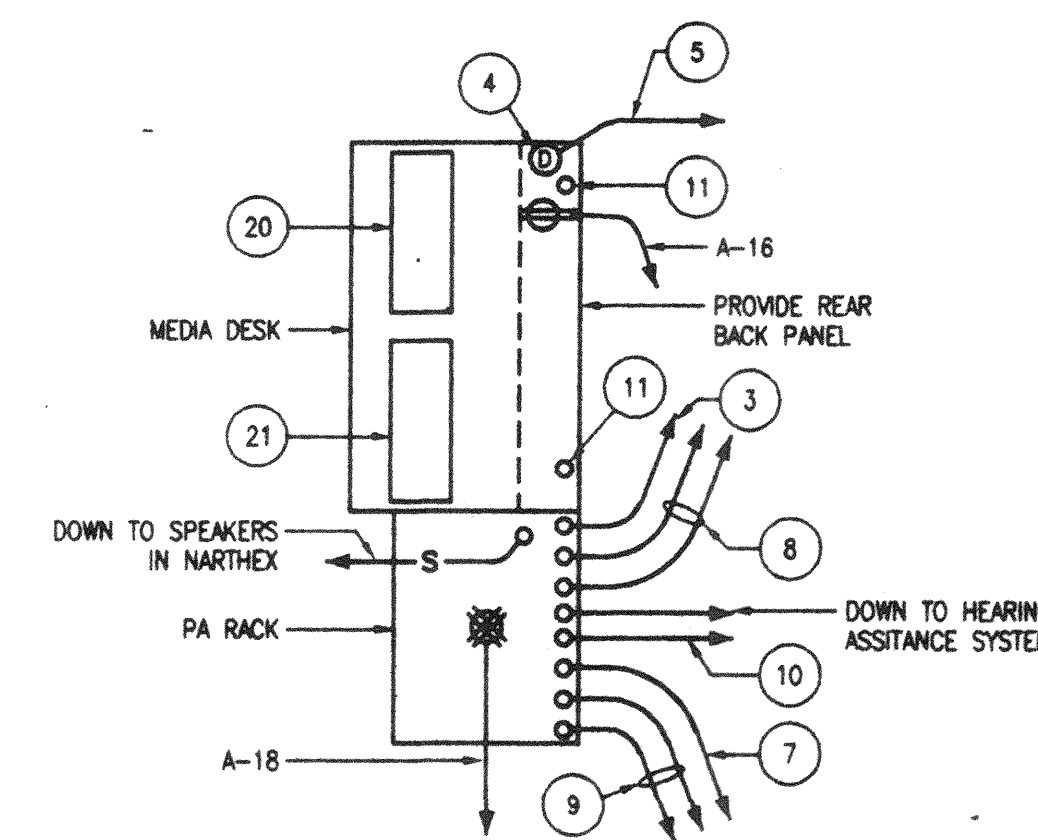

MEDIA DESK AND PA RACK DETAIL
SCALE: 1/2" = 1'-0"

4
E-7

Onuma & Associates


Architecture, Planning, Consulting
511 Mission Street
South Pasadena, CA 91030
tel 626.799.9920
fax 626.799.8260
e-mail: info@onuma.com

Consultants

RANDALL ENGINEERING
CONSULTING ELECTRICAL ENGINEER
2808 ALLESTREE STREET
PASADENA, CA 91107
323-687-9081 • FAX: 323-687-9083

REMODEL FOR
SAINT EDMUND'S
EPISCOPAL CHURCH
1175 SAN GABRIEL BLVD., SAN MARINO, CA., 91108-8048

STAMPS






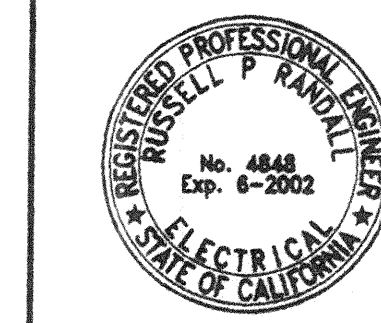


REVISIONS

DESCRIPTION	DATE	BY
PROJECT NUMBER	RE-123	
SCALE	1/8" = 1'-0"	
PRINTED	12/27/00	
TITLE	BASEMENT POWER PLAN, BASEMENT DEMOLITION PLAN AND MEZZANINE POWER PLAN	
SHEET		

E-7

43 OF 44

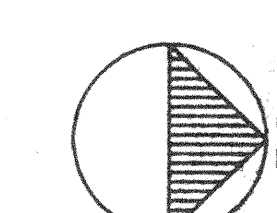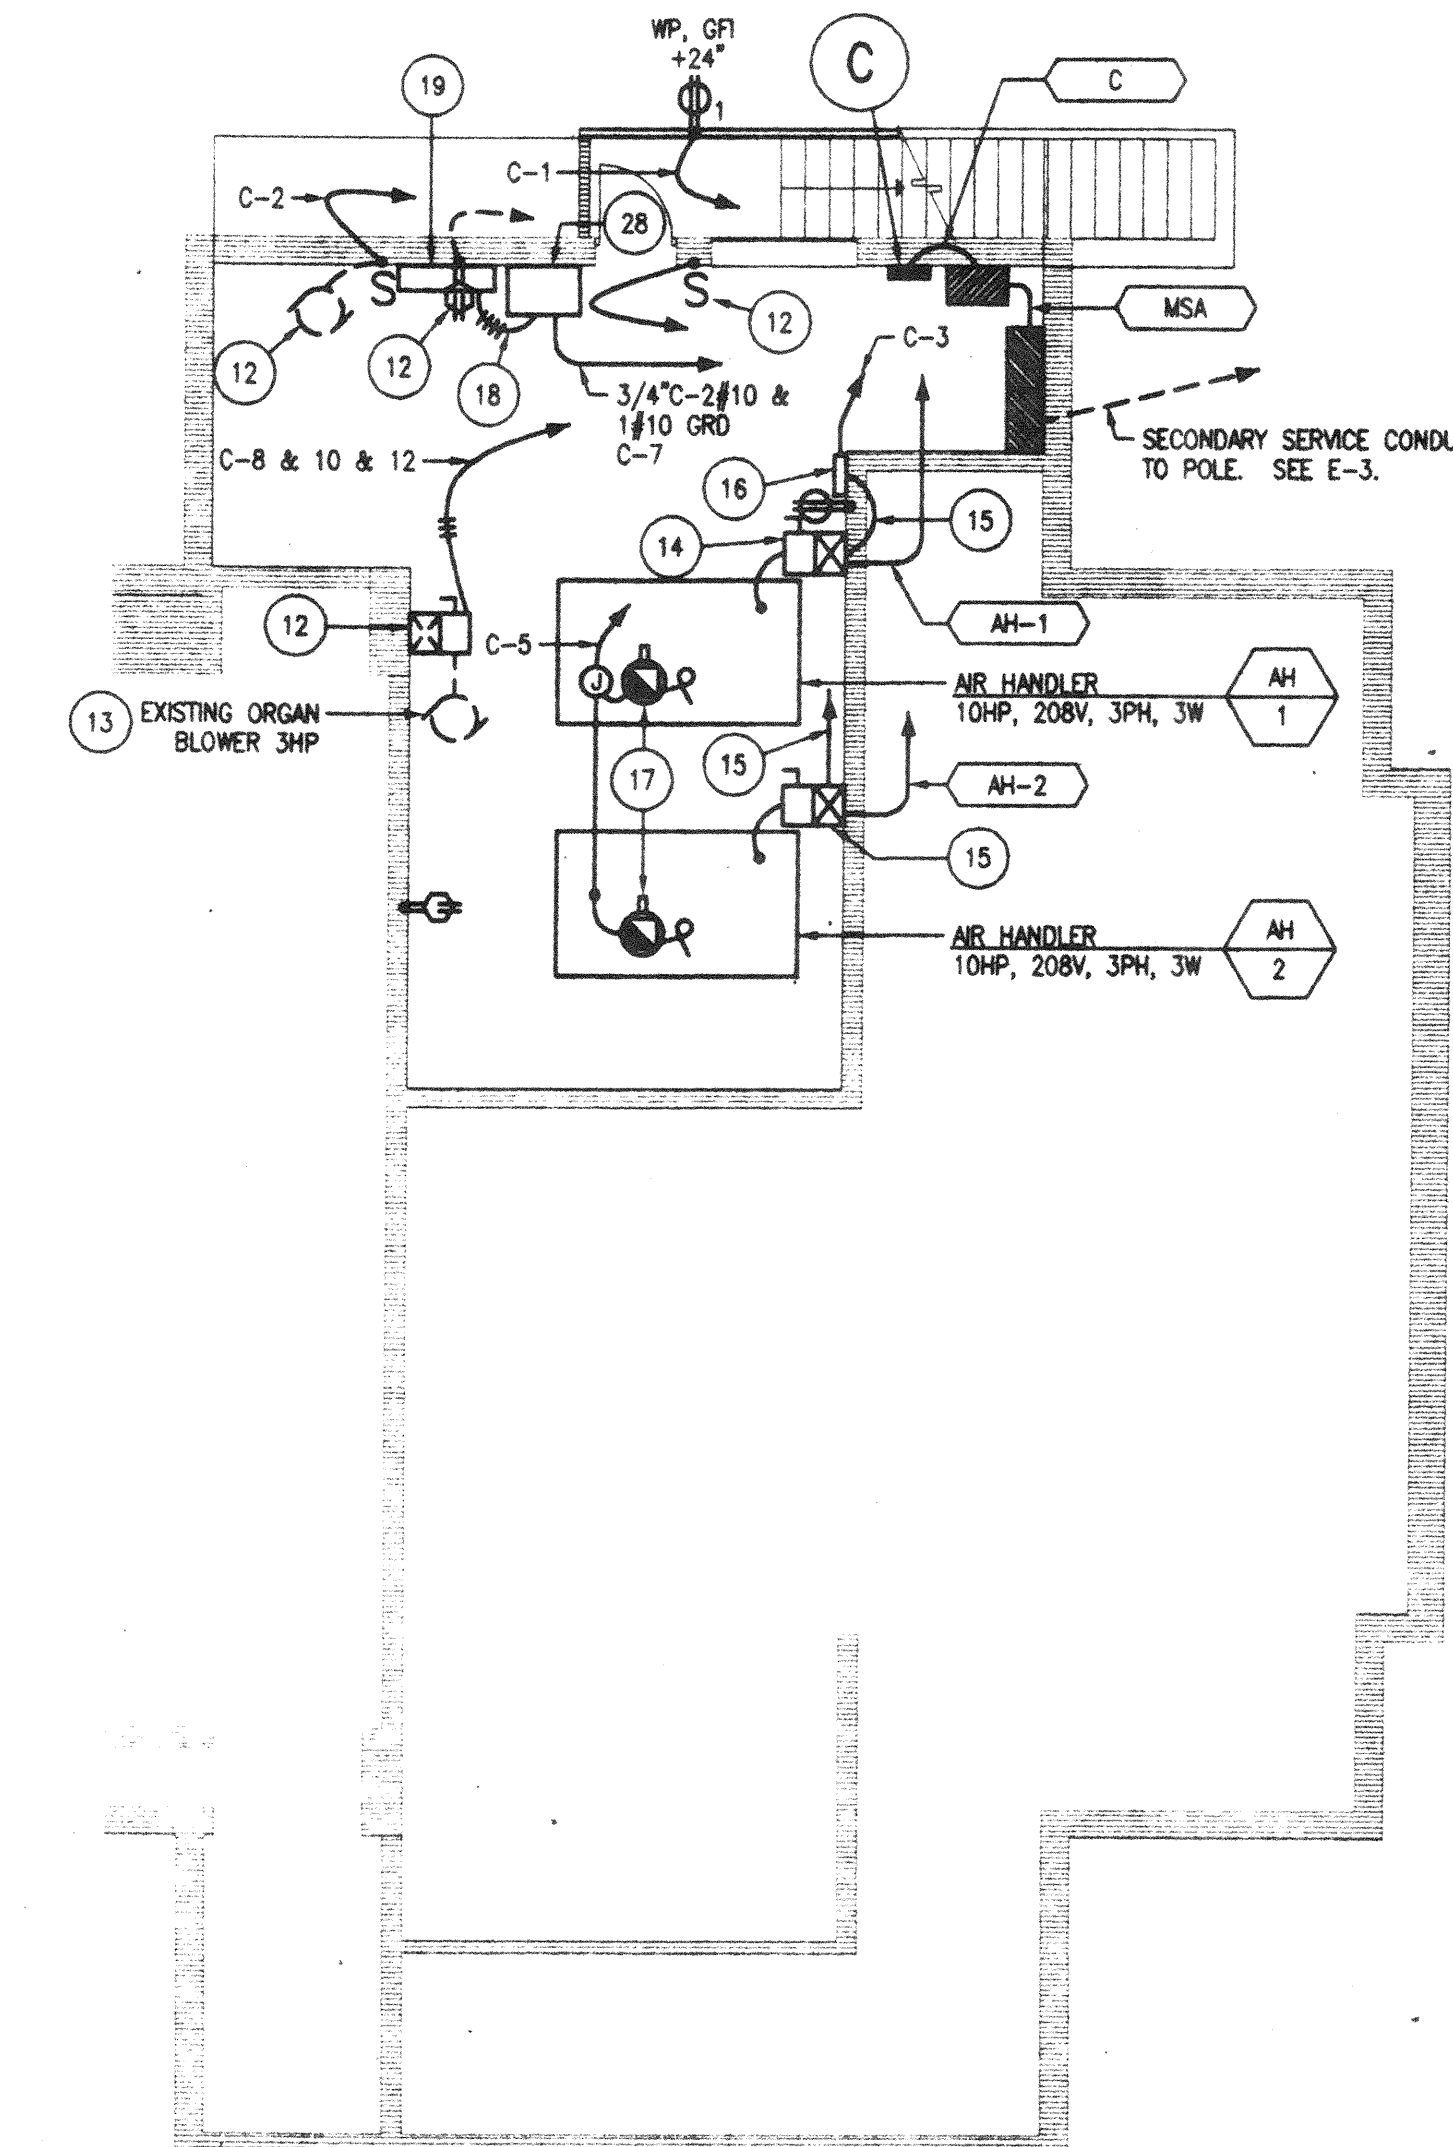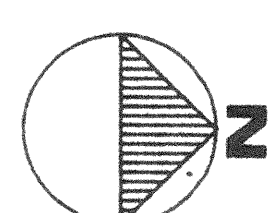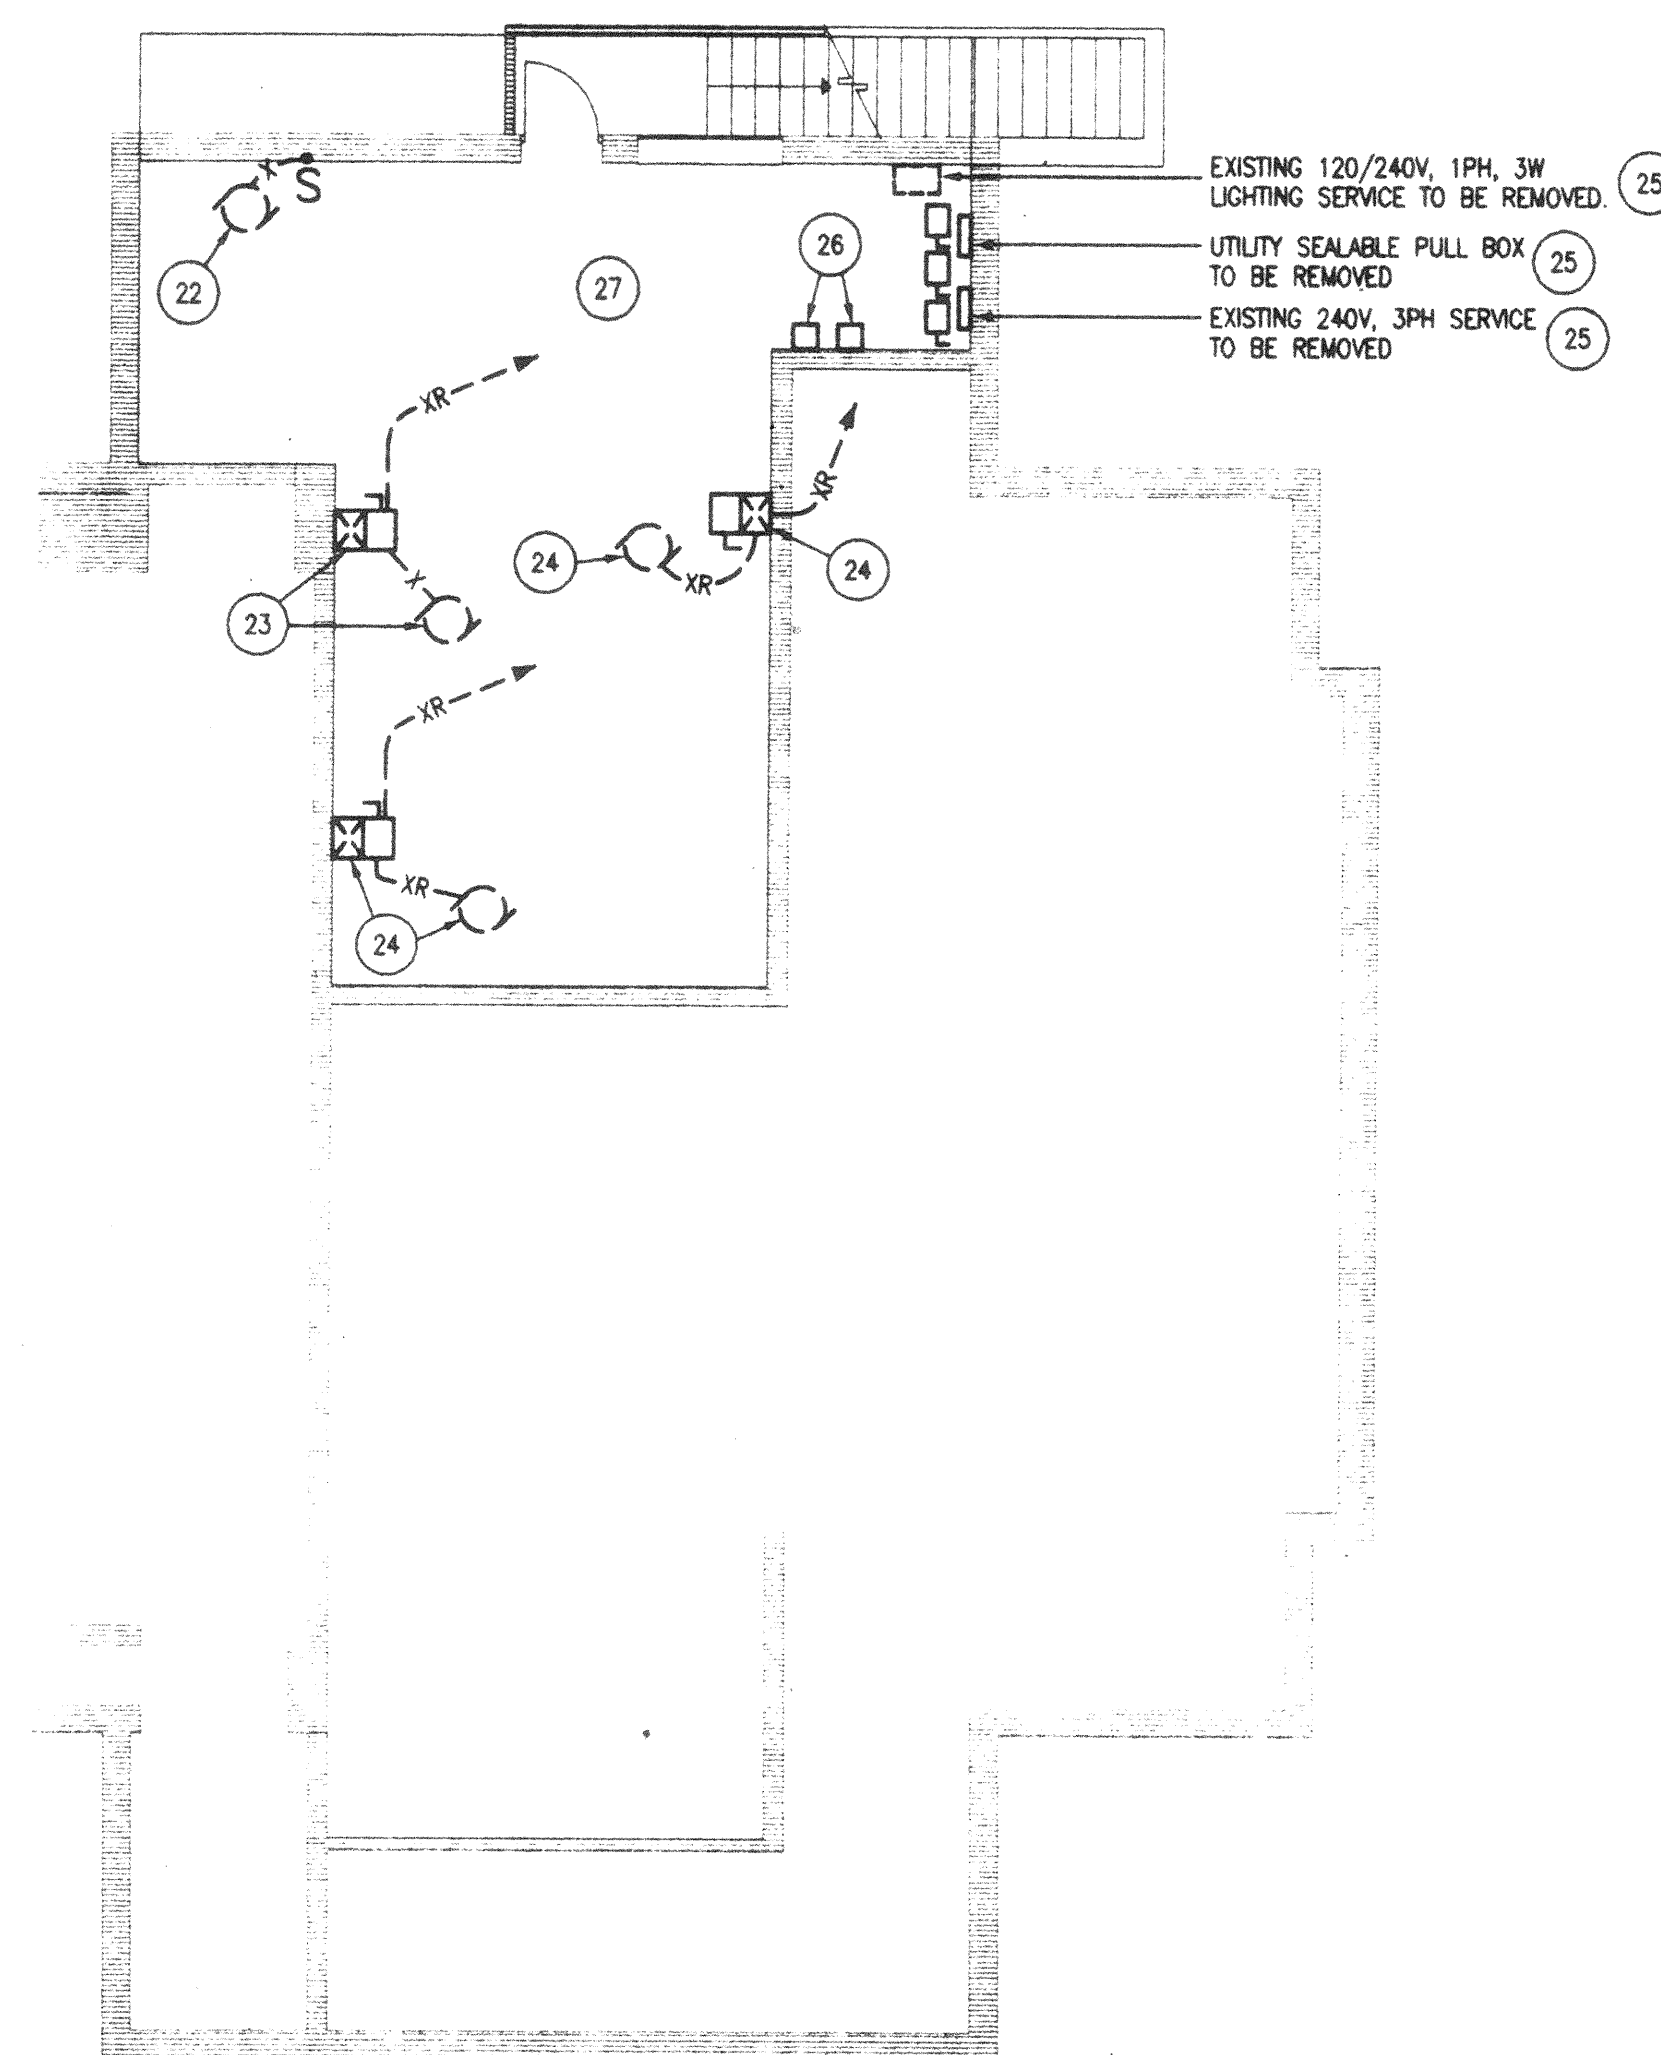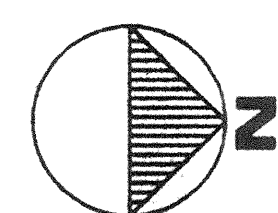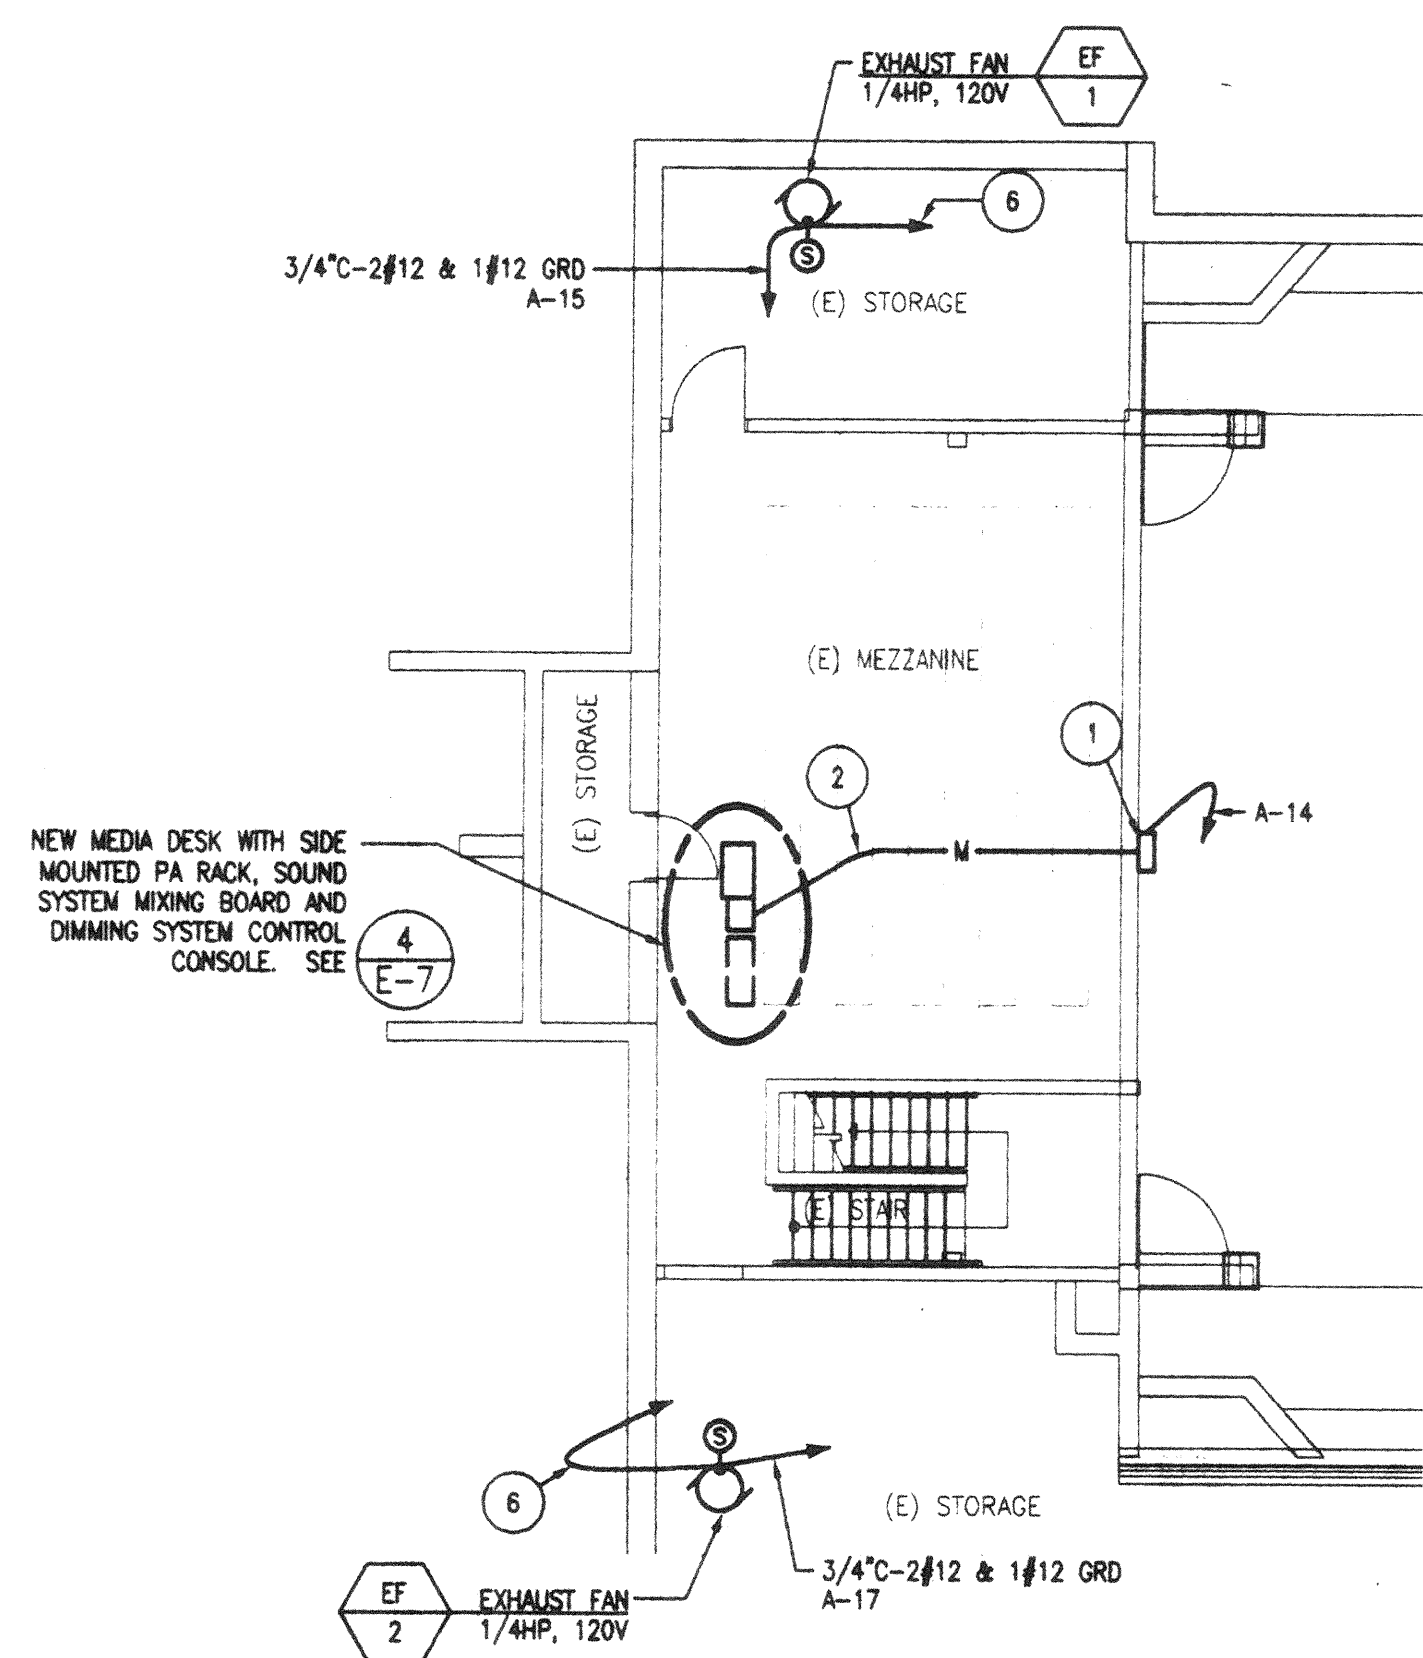

3 MEZZANINE POWER PLAN

2 DEMOLITION BASEMENT PLAN

1 BASEMENT POWER PLAN