



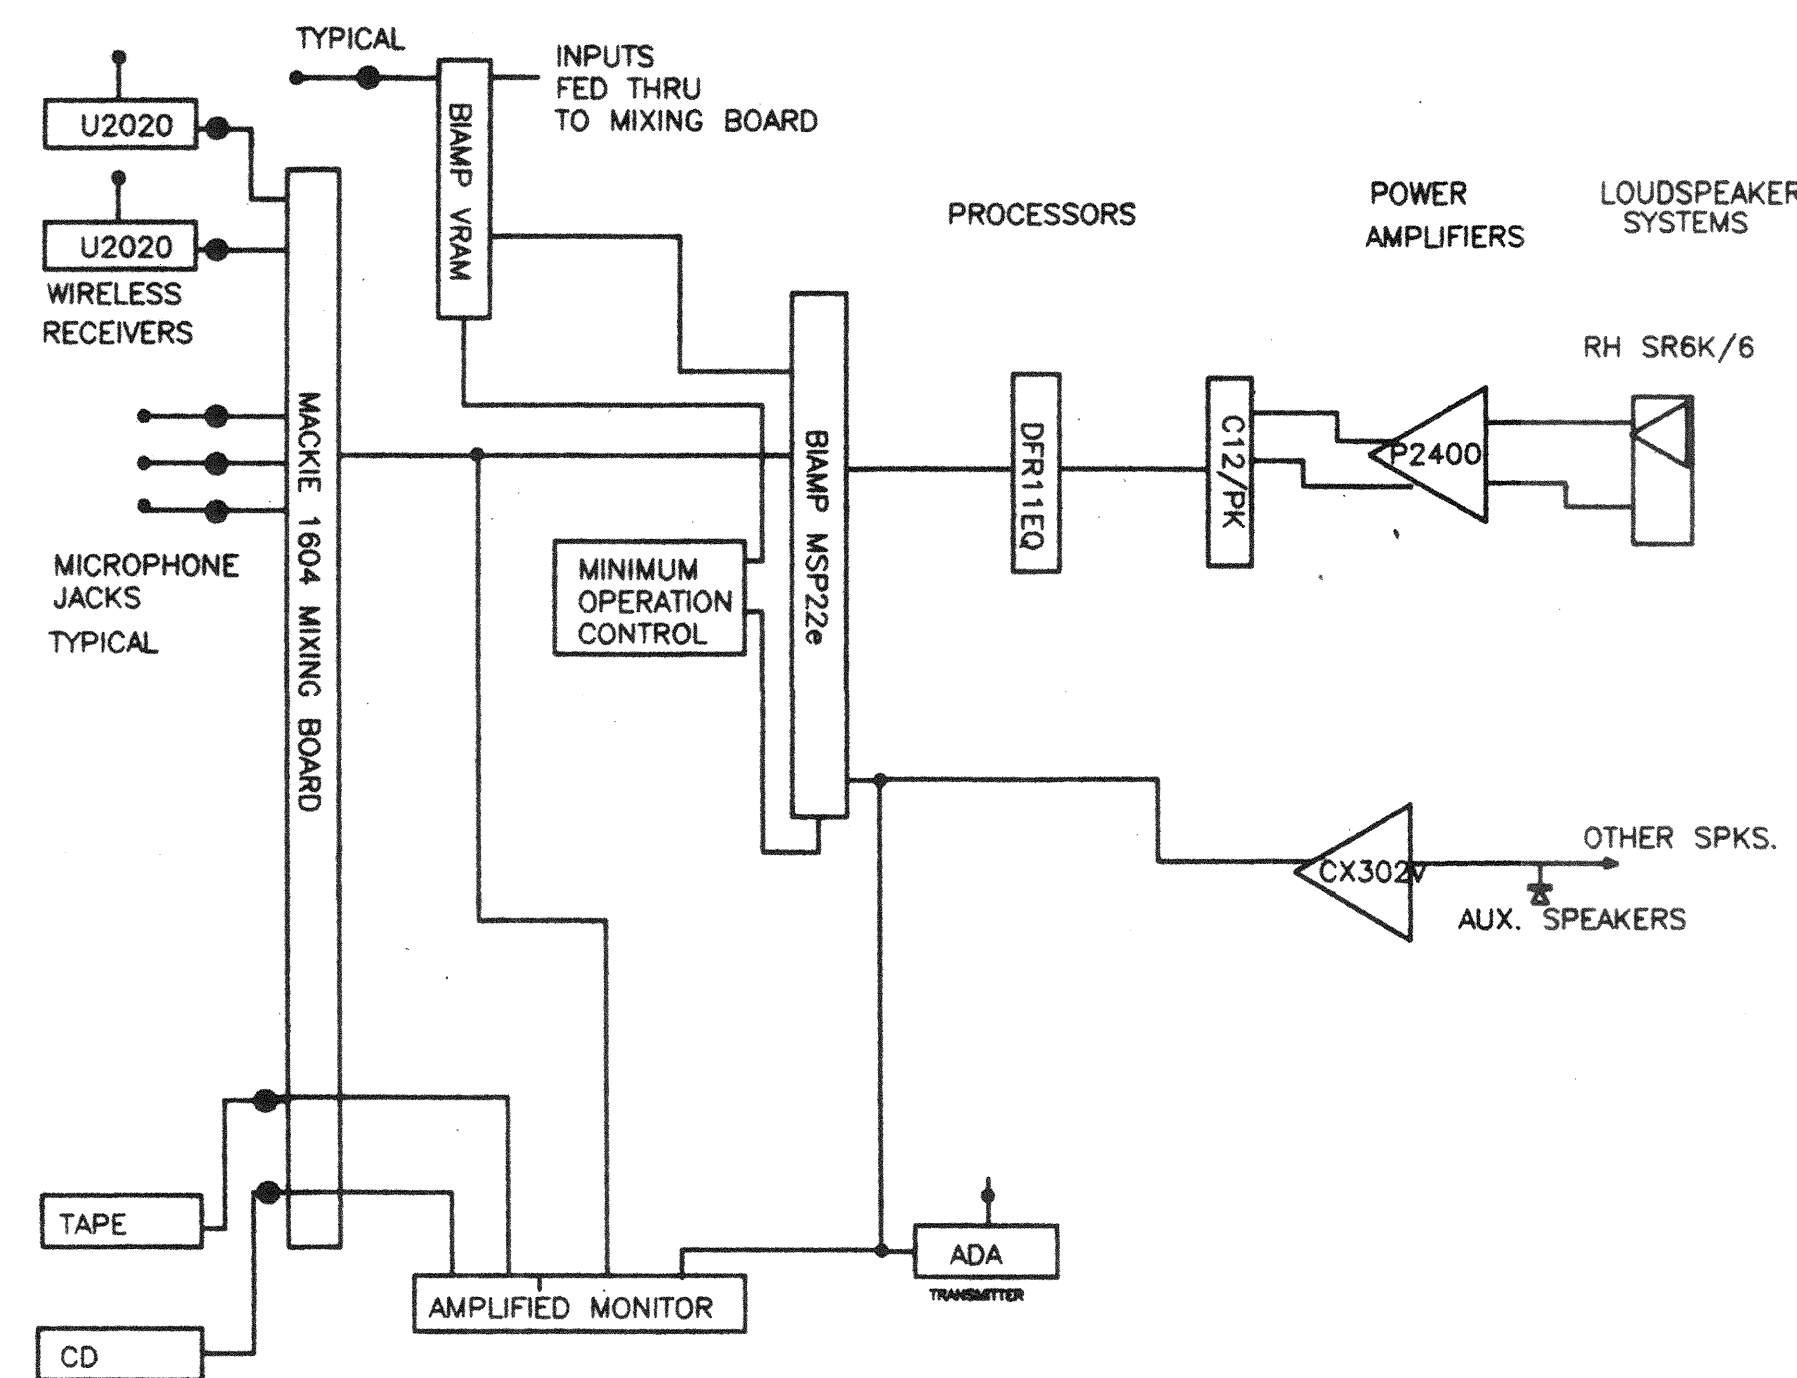


BLOCK DIAGRAM OF SOUND SYSTEM
NOT TO SCALE

D
E-9

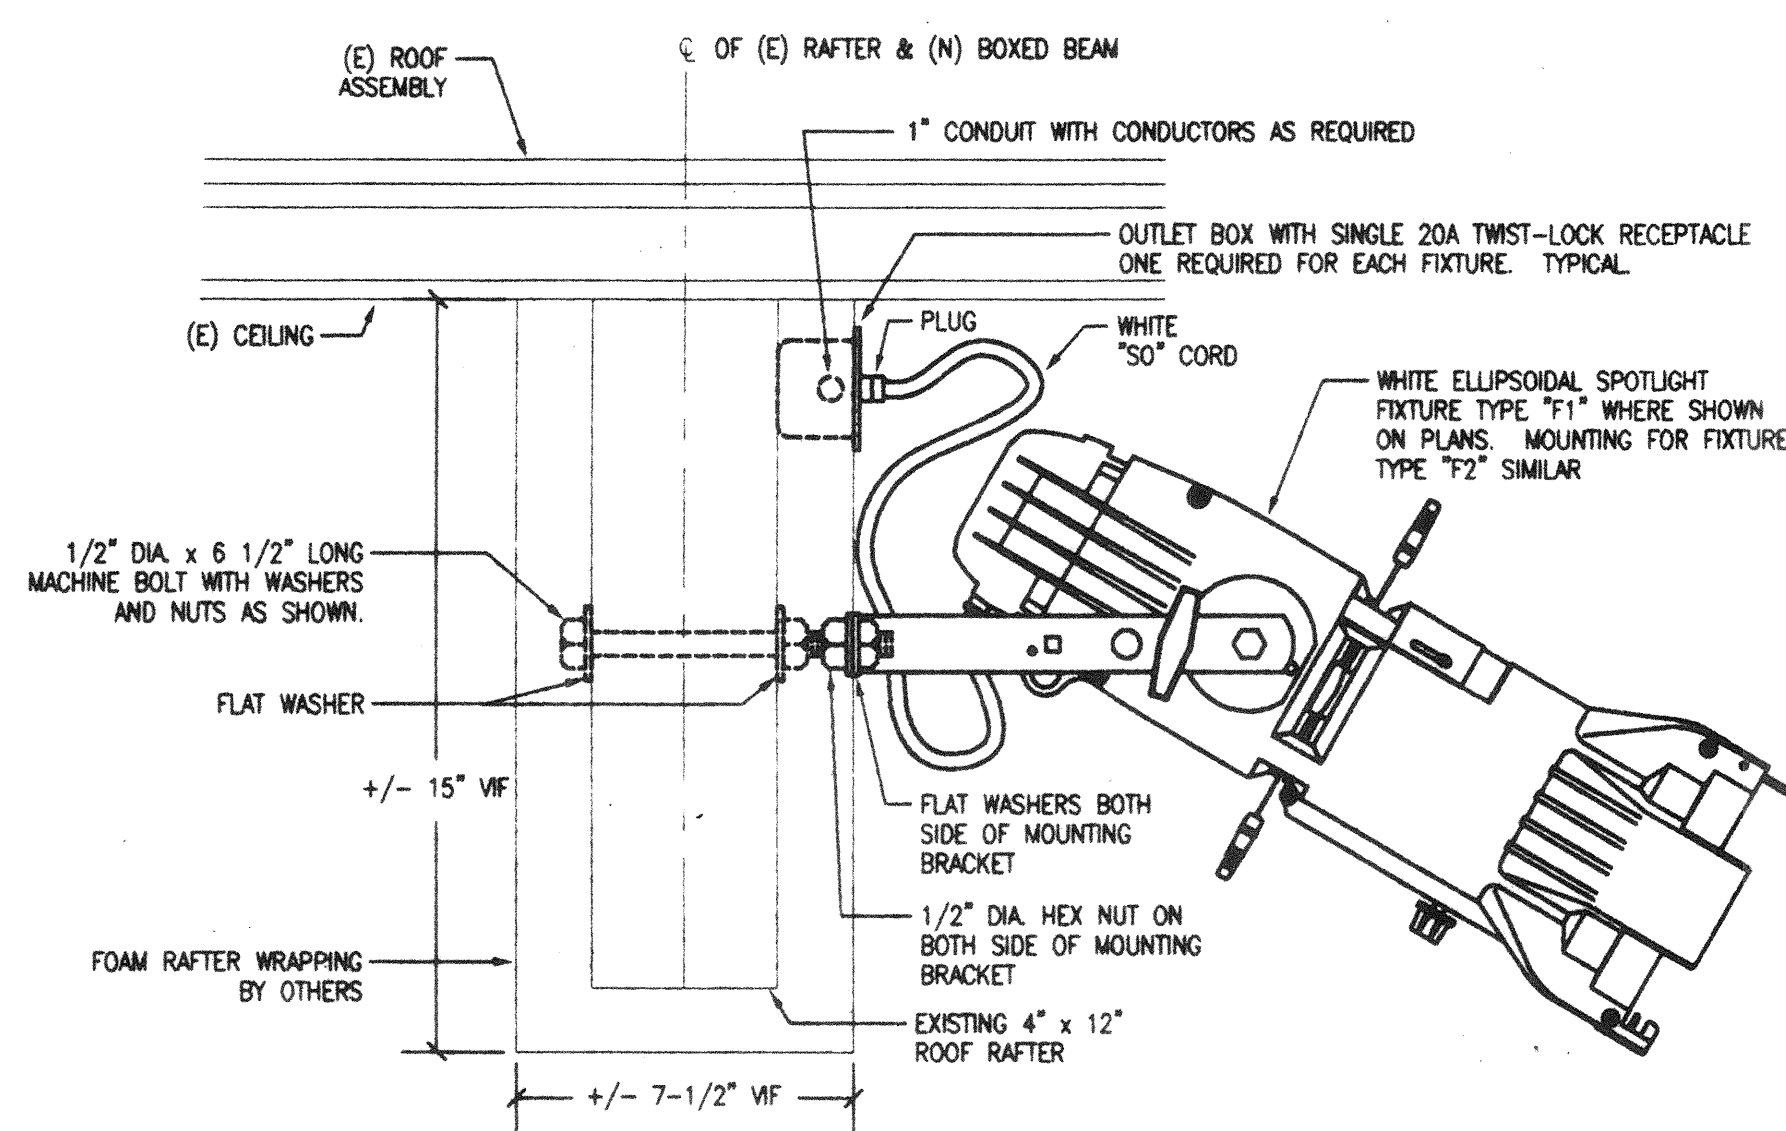

FIXTURE MOUNTING DETAIL
SCALE: 3" = 1'-0"

C
E-9

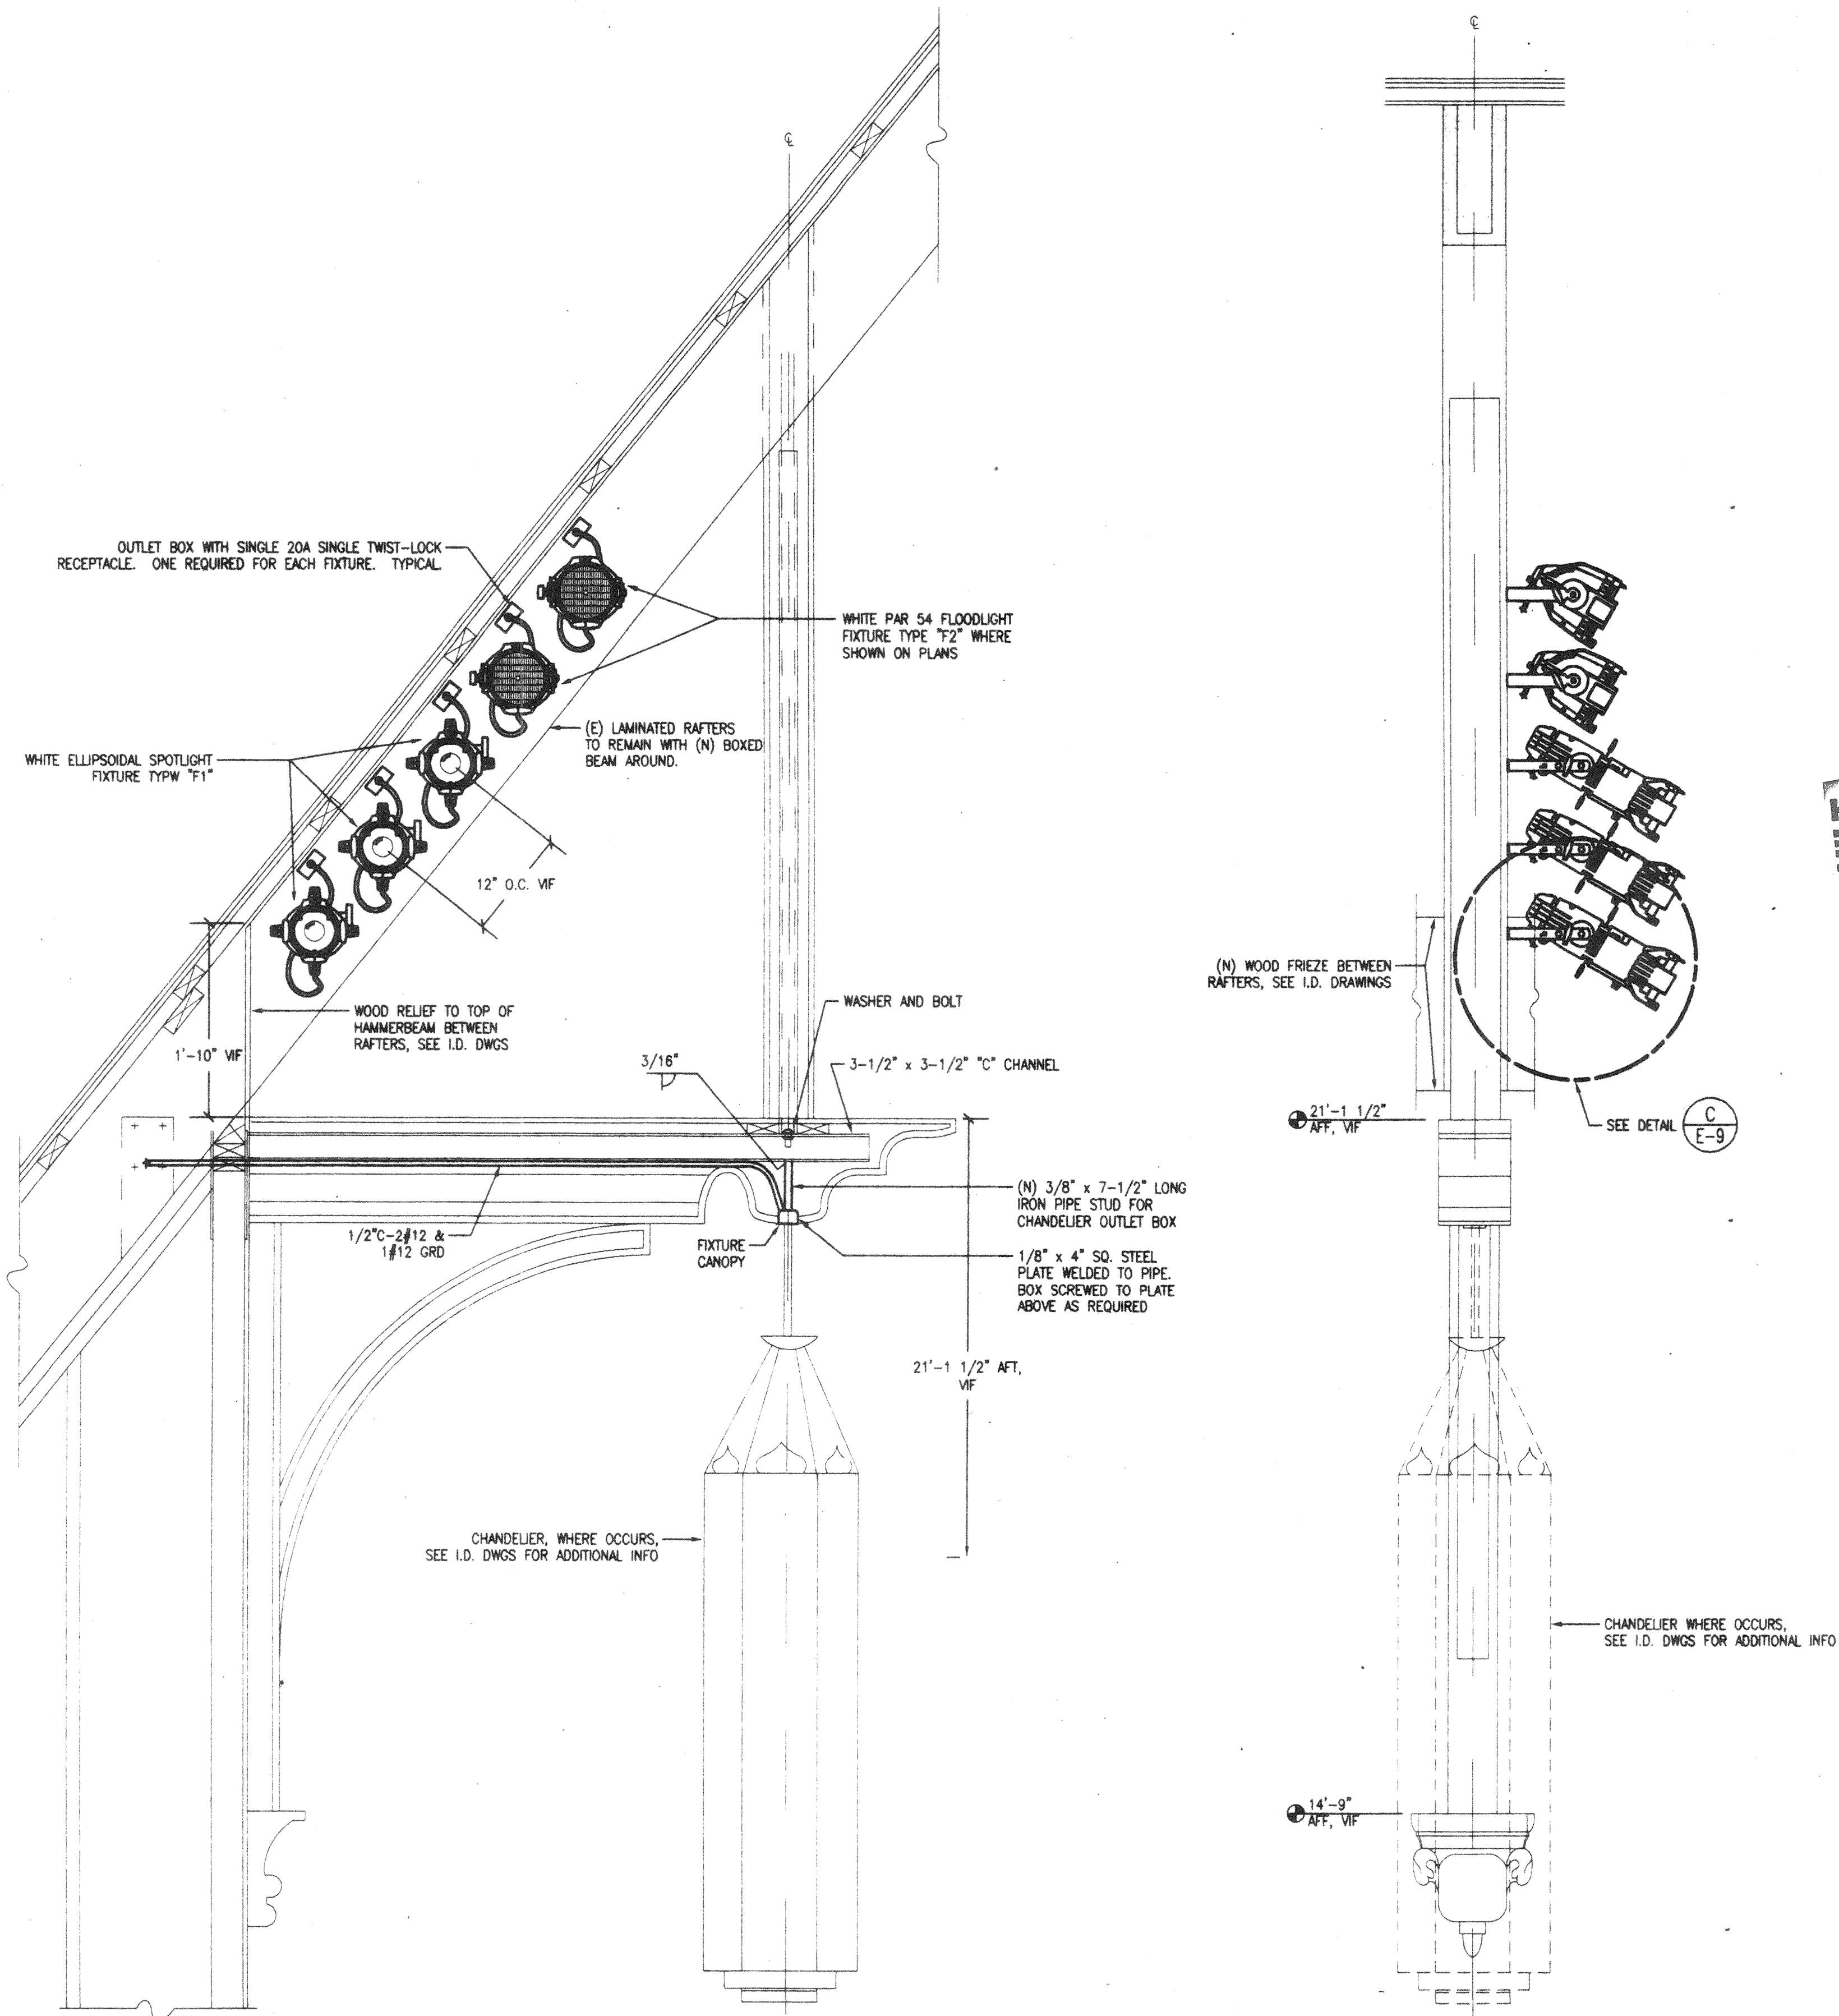

LIGHT FIXTURE INSTALLATION
SCALE: 1" = 1'-0"

B
E-9

LIGHT FIXTURE INSTALLATION ELEVATION
SCALE: 1" = 1'-0"

AS-BUILT
MAMMOTH ELECTRIC, INC.
DATED:

Onuma & Associates
Architecture, Planning, Consulting
511 Mission Street
South Pasadena, CA 91030
tel 626. 799. 9920
fax 626. 799. 8260
e-mail: info@onuma.com

Consultants

RANDALL ENGINEERING
ARCHITECTURAL ENGINEER
2008 ALEXANDER STREET
LOS ANGELES, CA 90039
323-667-9081 • Fax: 323-667-9083

**REMODEL FOR
SAINT EDMUND'S
EPISCOPAL CHURCH**
1175 SAN GABRIEL BLVD., SAN MARINO, CA. 91108-8048

STAMPS



REVISIONS

DESCRIPTION	DATE	BY

PROJECT NUMBER
RE-123

SCALE
AS NOTED

PRINTED
12/27/00

TITLE
SOUND SYSTEM
AND MOUNTING DETAILS

SHEET
E-9

45 OF 45