


NOTE:
REFER TO "AC" SHEETS FOR ALL MECHANICAL EQUIPMENT. CONTACT WITH MECHANICAL ENGINEER FOR LOCATION AND SIZE OF DUCT SYSTEMS.

18" x 2 1/4" RISERS
TYPICAL
SEE DETAIL
W/EXTRACTOR
IN BRANCH


20" x 6" W. RELIEF BR.
IN EACH CLASSROOM
(TYPICAL) W/ FIRE
DAMPERS
SEE DETAIL

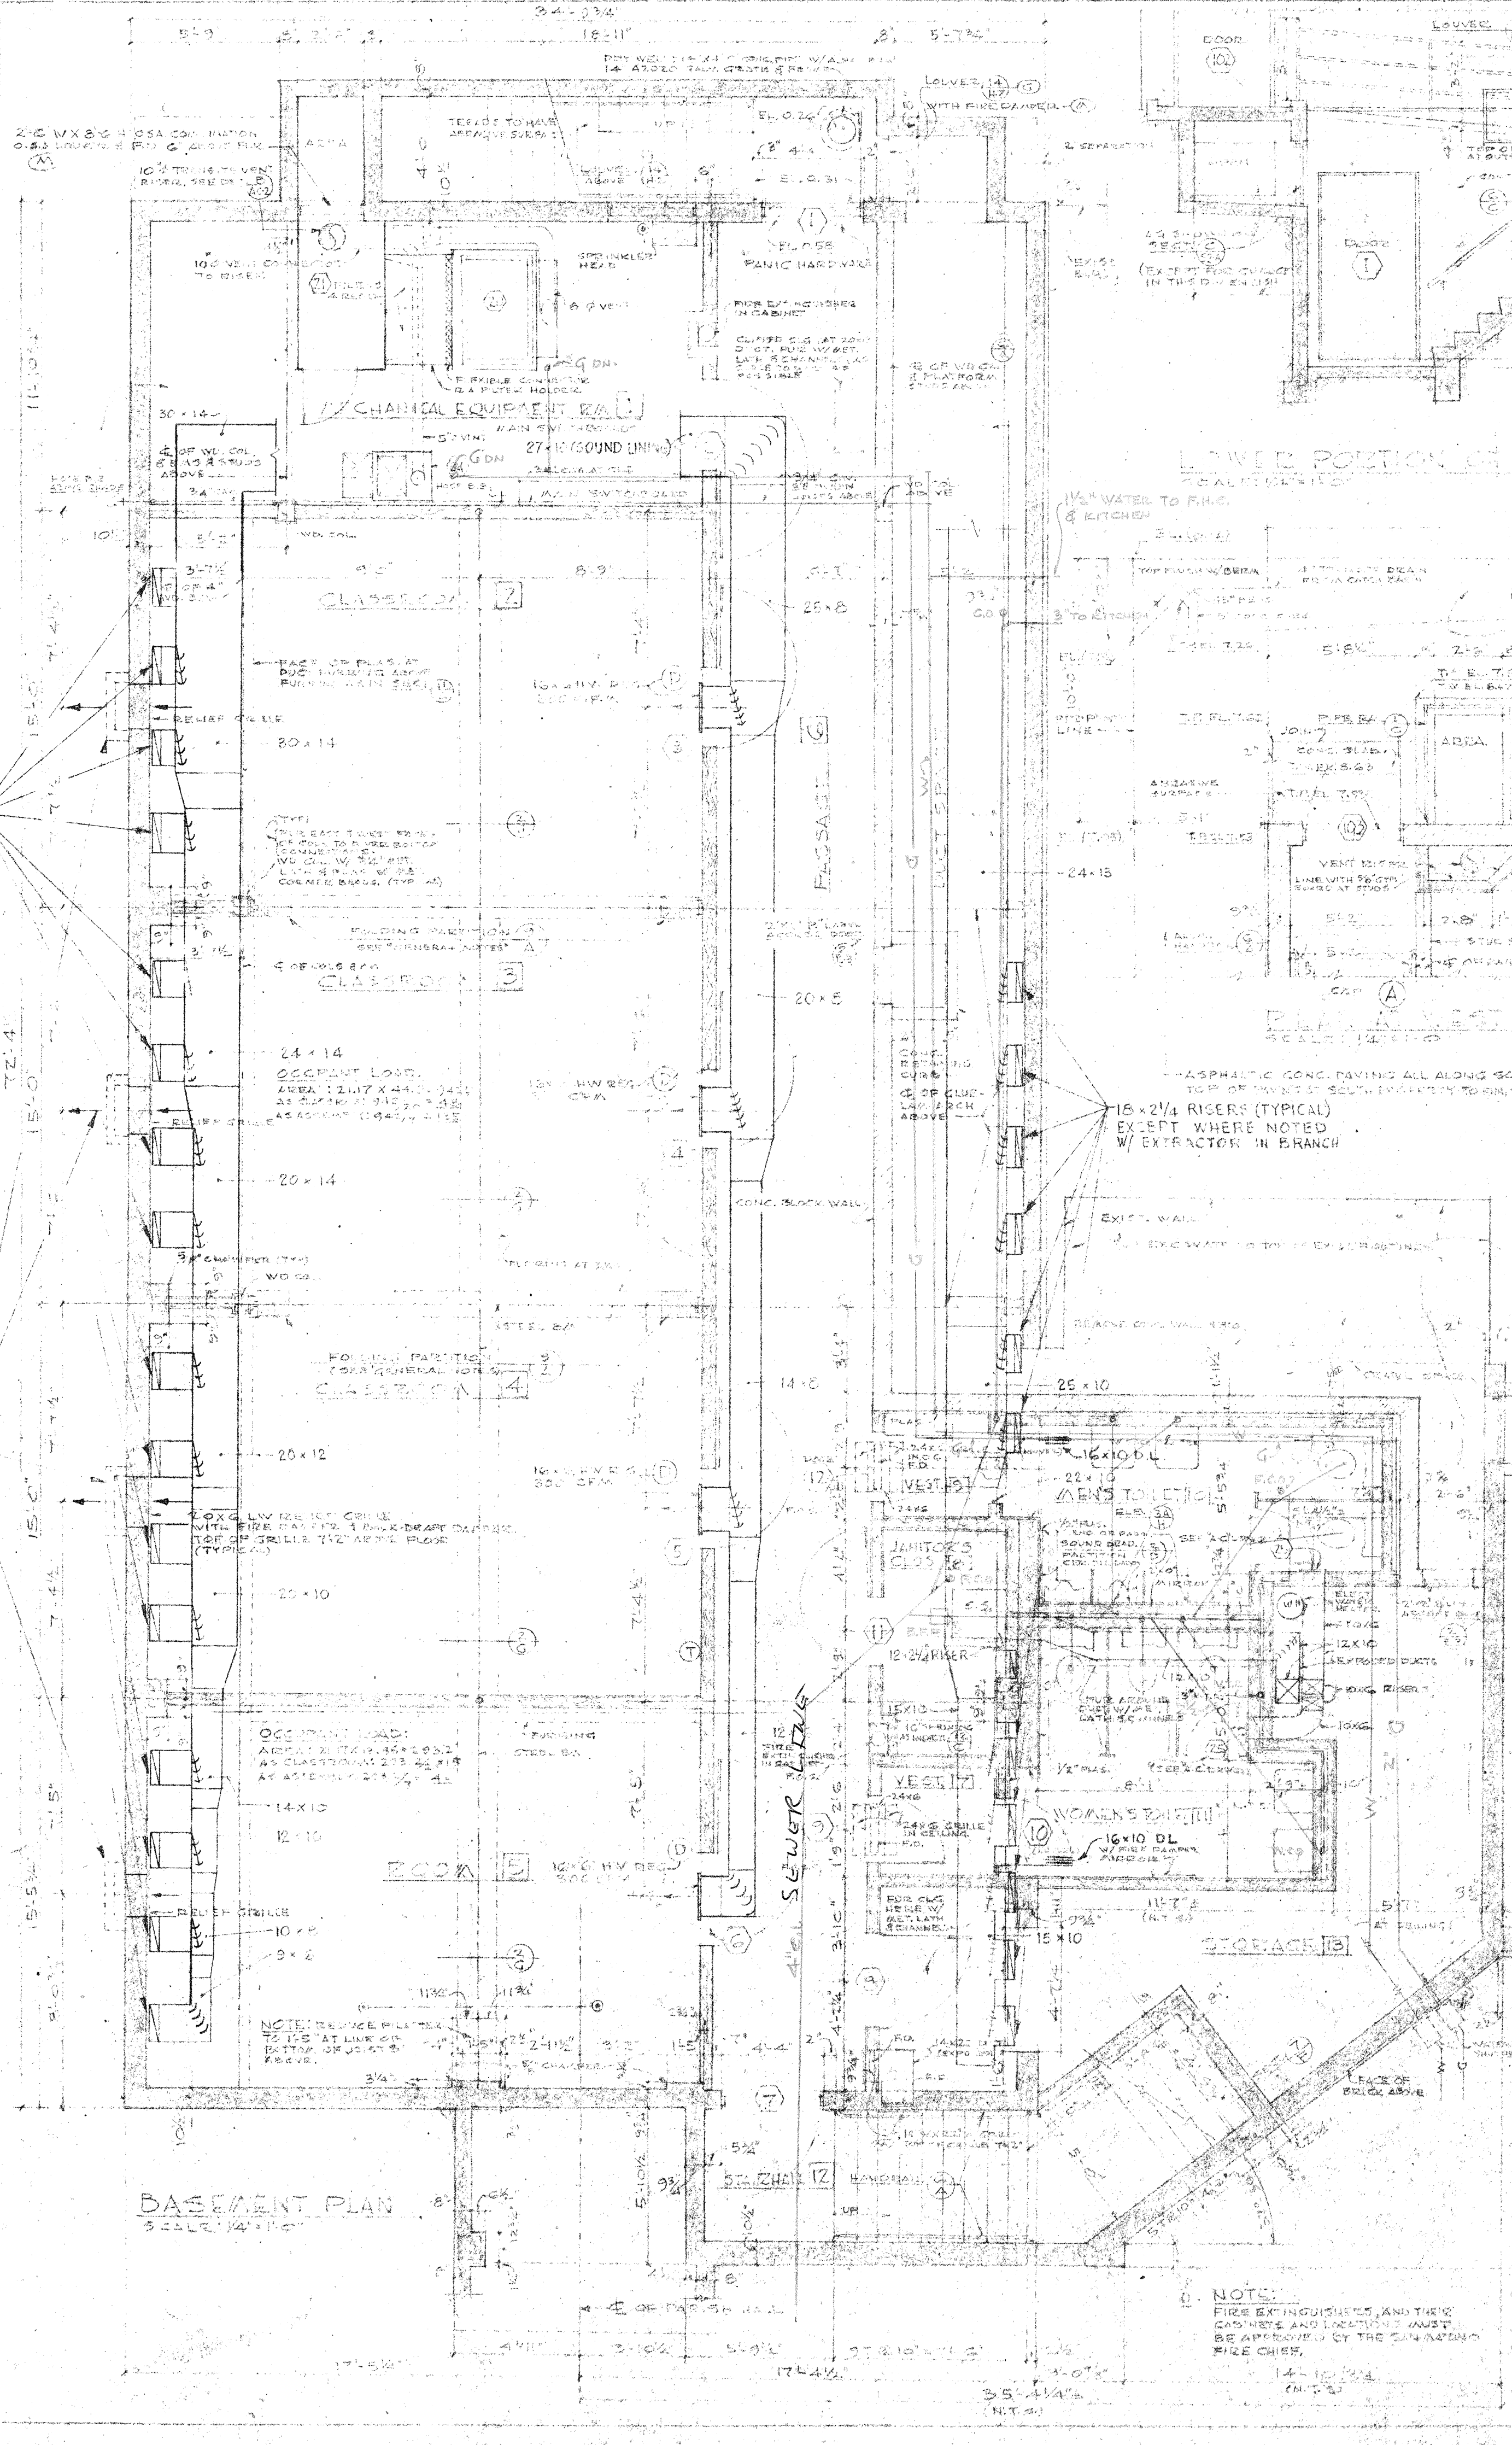


BASEMENT PLAN
SCALE: 1/4" = 1'-0"

NOTE:
FIRE EXTINGUISHERS AND THEIR
LOCATIONS AND IDENTIFY MUST
BE APPROVED BY THE CALIFORNIA
FIRE CHIEF.


PLUMBING NOTES:
1) ADJUST PLUMBING TO ACCOMMODATE REVISIONS.
2) IN BASEMENT CORRIDORS, WHERE NECESSARY, PROVIDE
IN THE DOUBLE-SHOTTED VALVE AT THE TOILET, EXCEPT
IN THE TOILET IN THE TOILET.
3) CHECK PLUMBING THROUGH PLUMBING CRANES TO BEAR
POINT ON BLUE-GRADE WAS SHOWN ON THE ORIGINAL
PLAN.

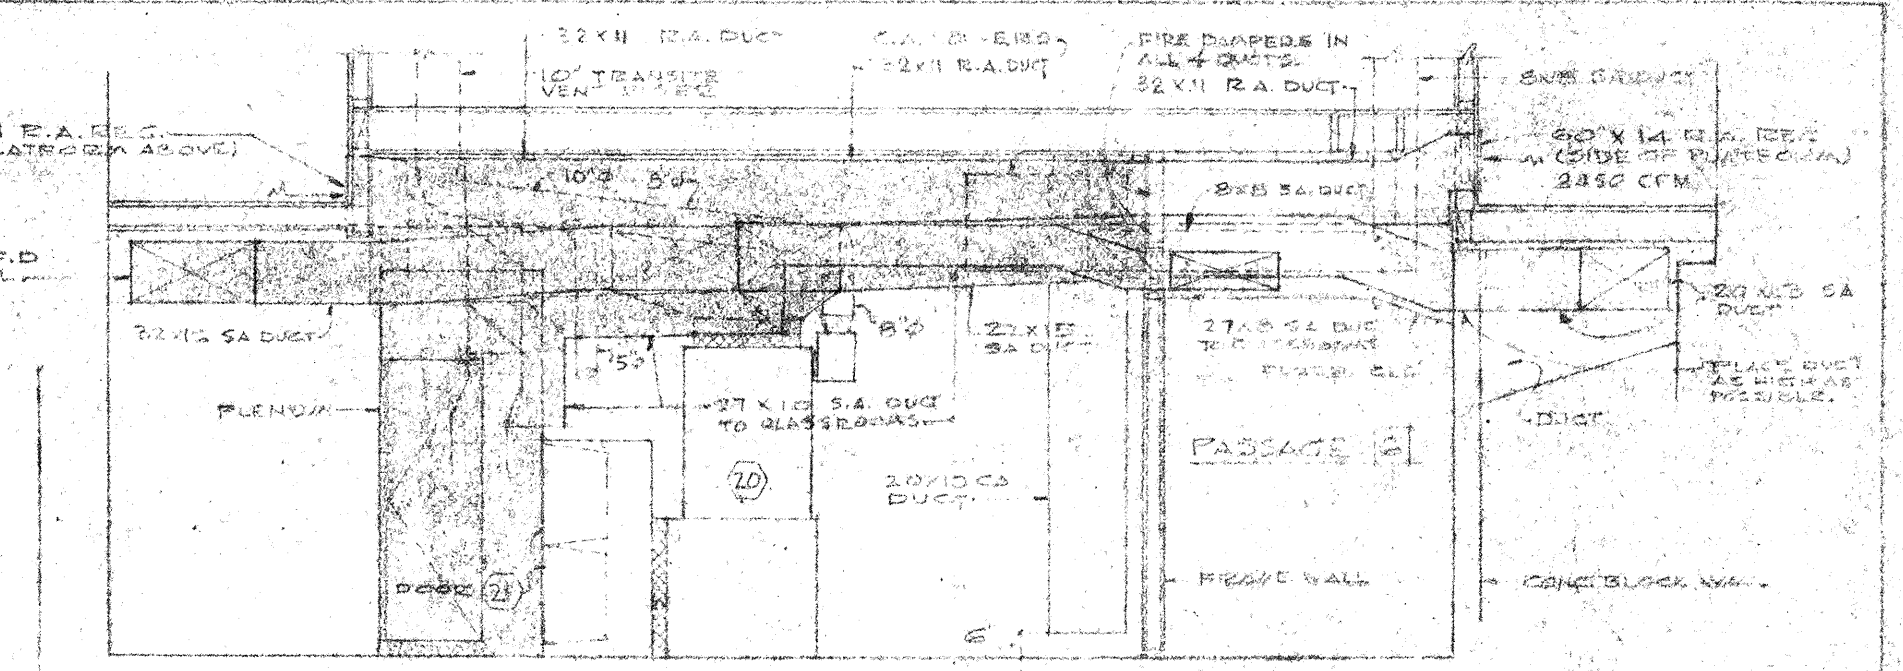


SECTION THRU MECHANICAL EQUIPMENT ROOM (LOOKING WEST)
SCALE: 1/4" = 1'-0"

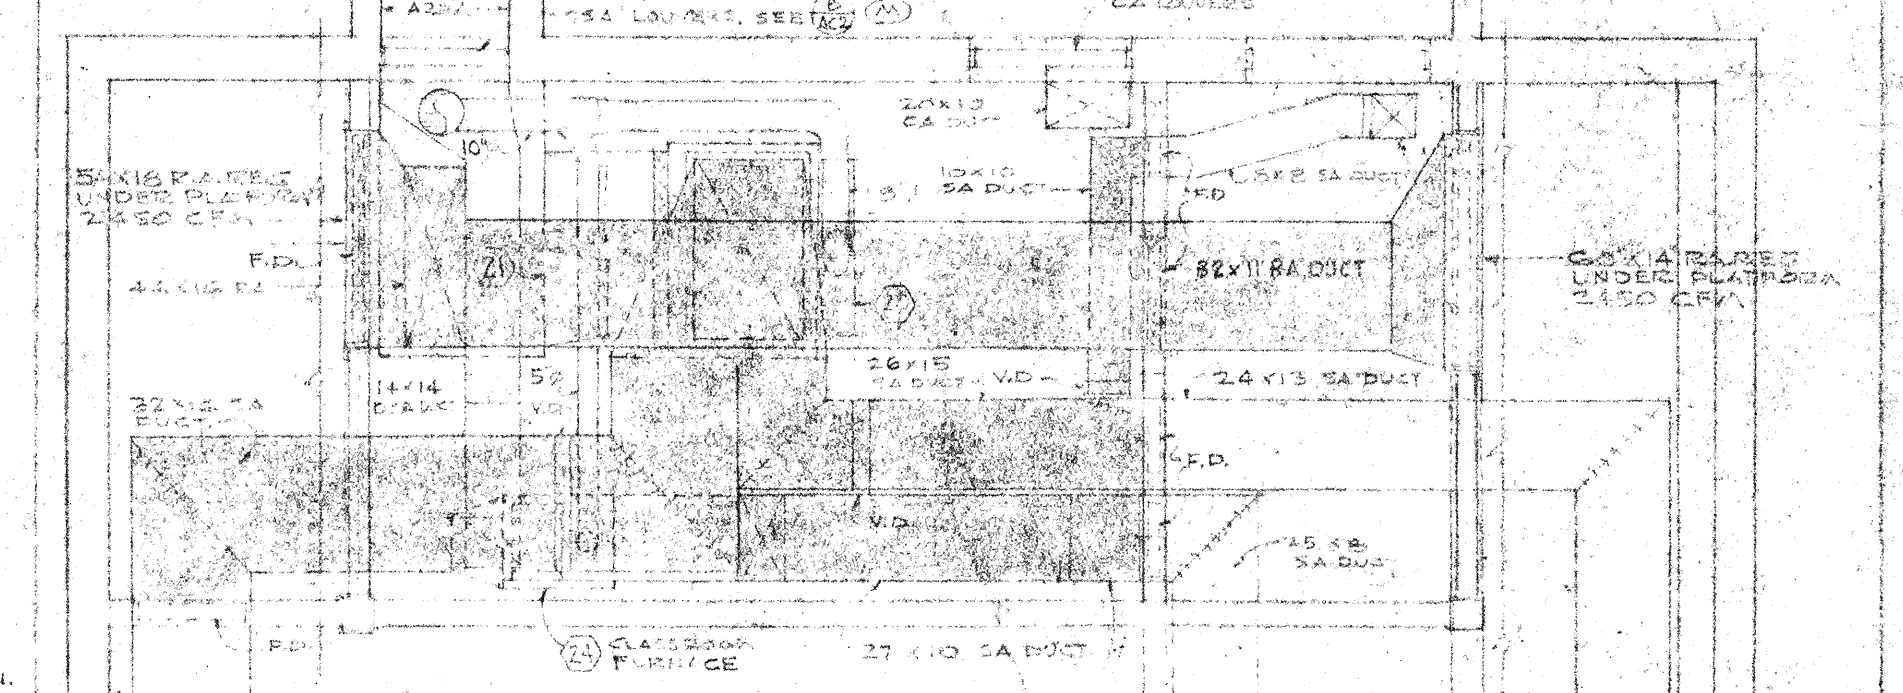


FLOOR PLAN OF MECHANICAL EQUIPMENT ROOM (UPPER LEVEL)
SCALE: 1/4" = 1'-0"

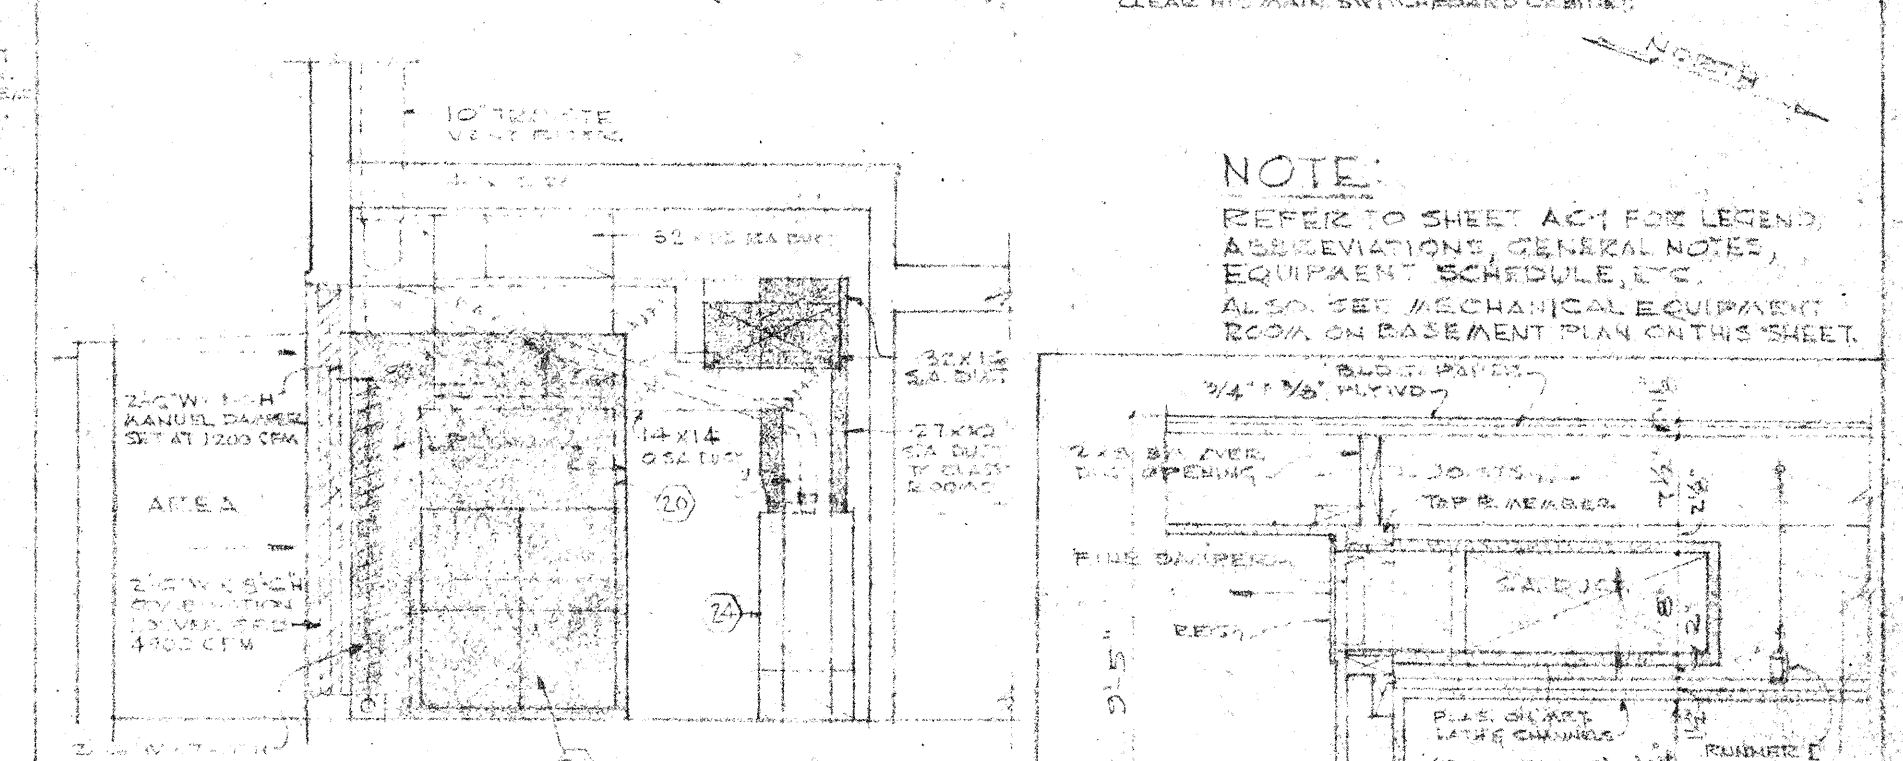


SECTION THRU MECHANICAL EQUIPMENT ROOM (LOOKING NORTH)
SCALE: 1/4" = 1'-0"

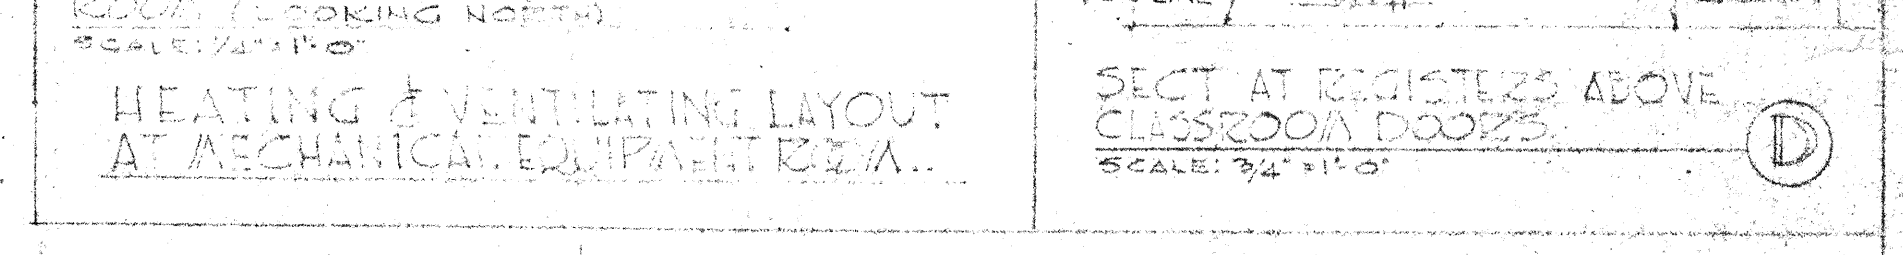

HEATING & VENTILATING LAYOUT AT MECHANICAL EQUIPMENT ROOM
SCALE: 1/4" = 1'-0"

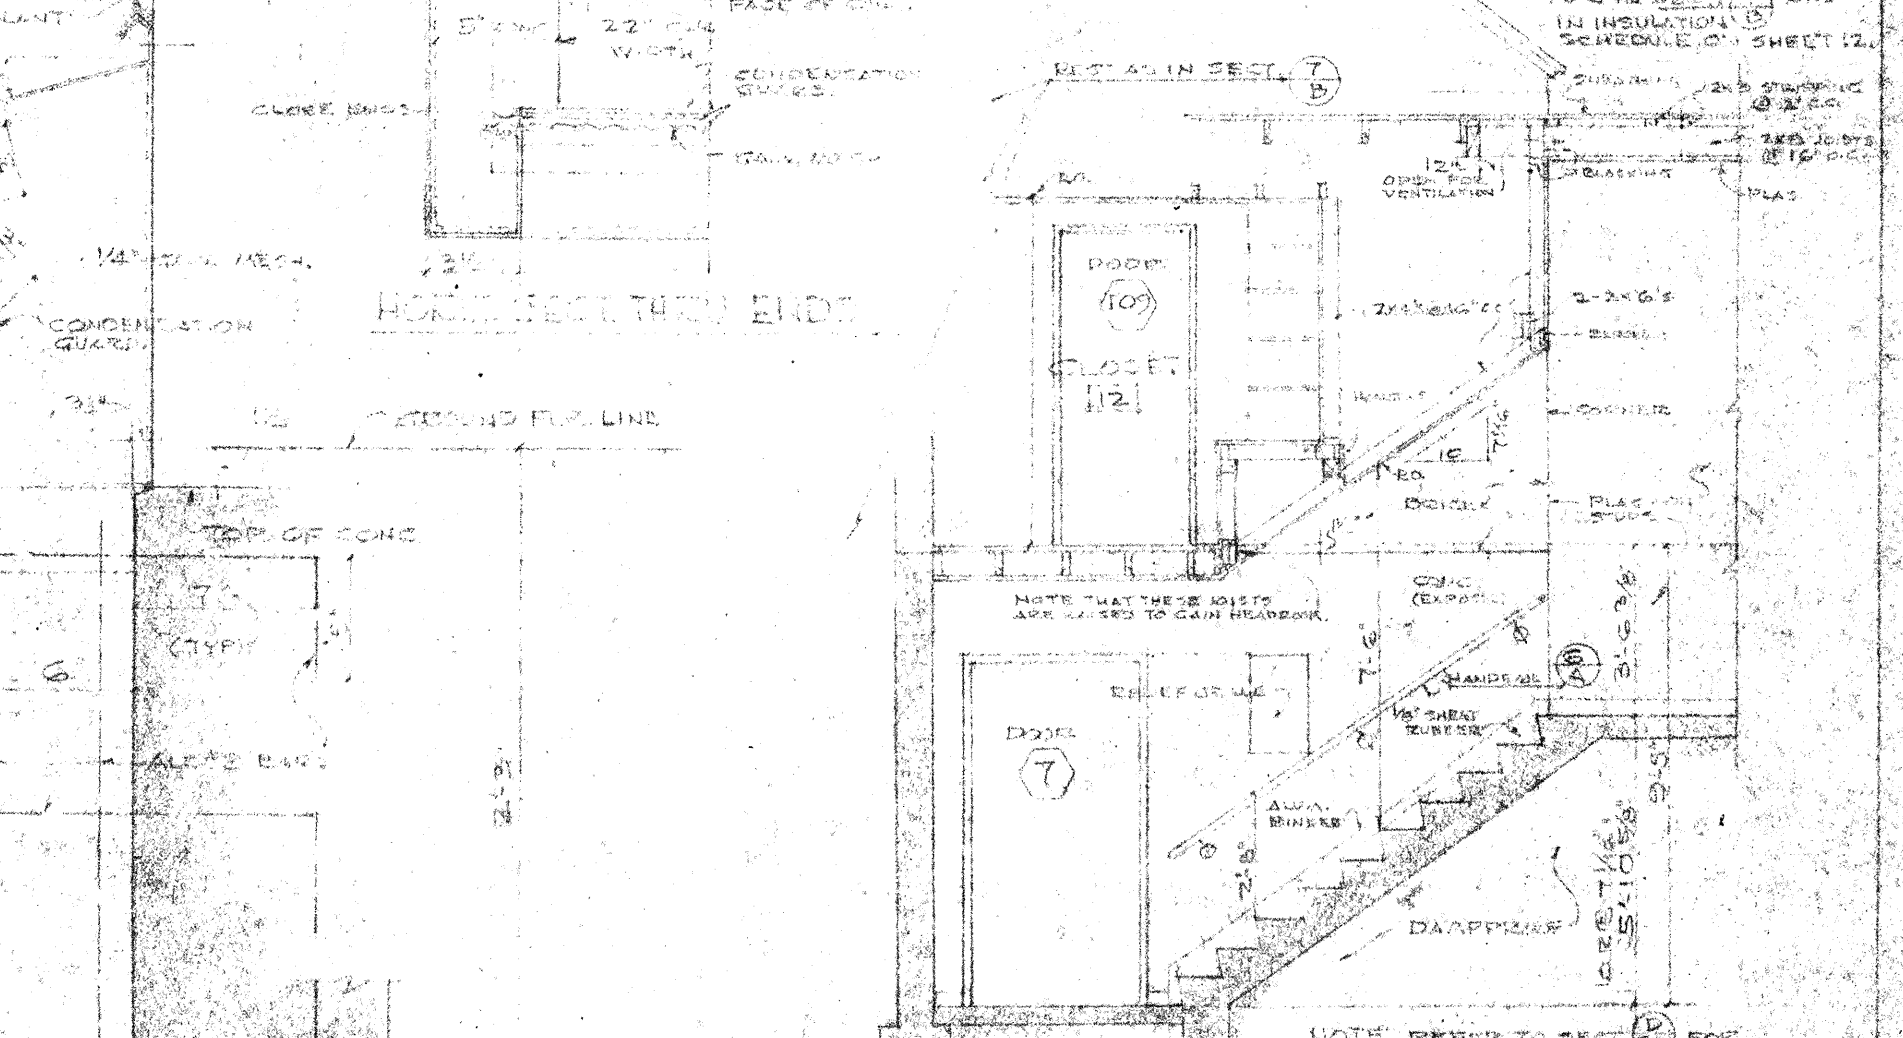

PARTIAL PLAN AT SOUTH-EAST CORNER OF PARISH HALL
SCALE: 1/4" = 1'-0"

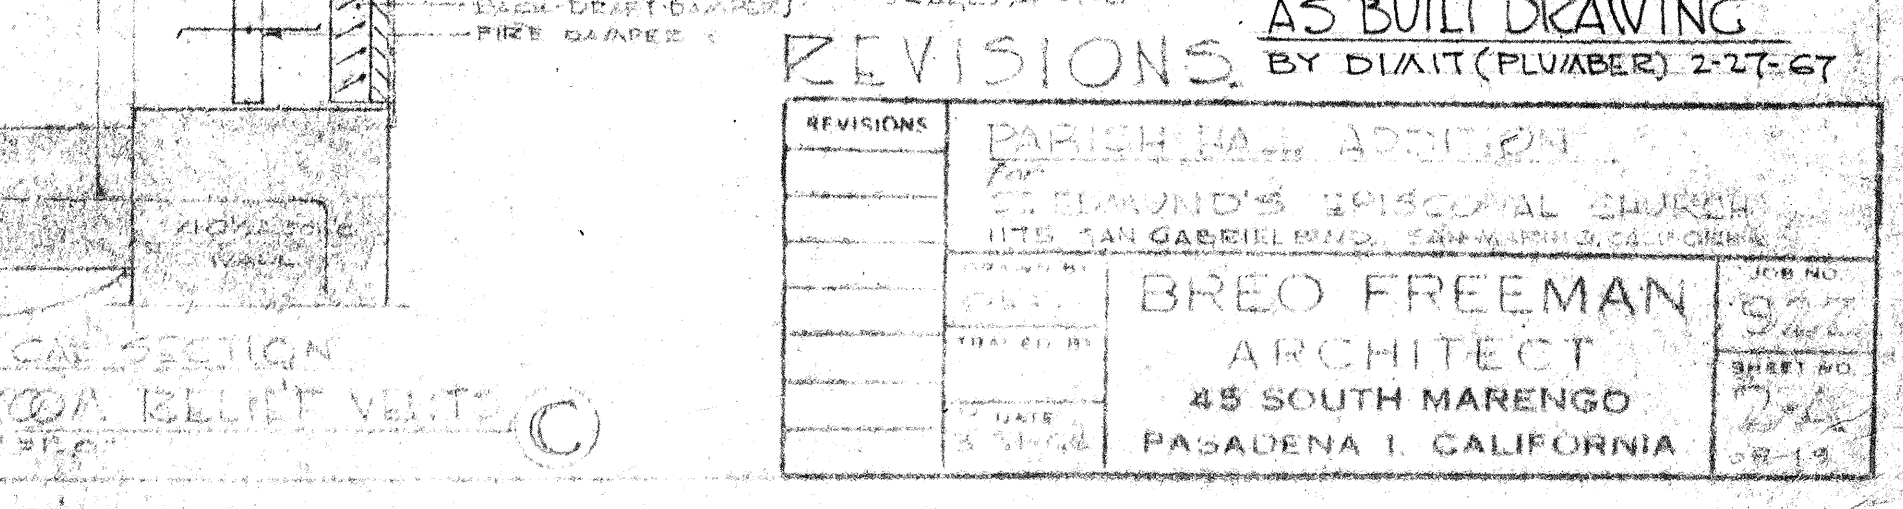

SECTION THRU FRONT OF PLATFORM
SCALE: 1/4" = 1'-0"

REVISIONS

NO.	DESCRIPTION	DATE
1	PARISH HALL ADDITION	2-27-67
2	ST. MARY'S EPISCOPAL CHURCH	2-27-67
3	ST. MARY'S EPISCOPAL CHURCH	2-27-67
4	ST. MARY'S EPISCOPAL CHURCH	2-27-67
5	ST. MARY'S EPISCOPAL CHURCH	2-27-67
6	ST. MARY'S EPISCOPAL CHURCH	2-27-67
7	ST. MARY'S EPISCOPAL CHURCH	2-27-67
8	ST. MARY'S EPISCOPAL CHURCH	2-27-67
9	ST. MARY'S EPISCOPAL CHURCH	2-27-67
10	ST. MARY'S EPISCOPAL CHURCH	2-27-67

AS BUILT DRAWING
BY DIAIT (PLUMBER) 2-27-67

BREO FREEMAN
ARCHITECT
45 SOUTH MARENGO
PASADENA 1, CALIFORNIA