


ELECTRIC SYMBOLS

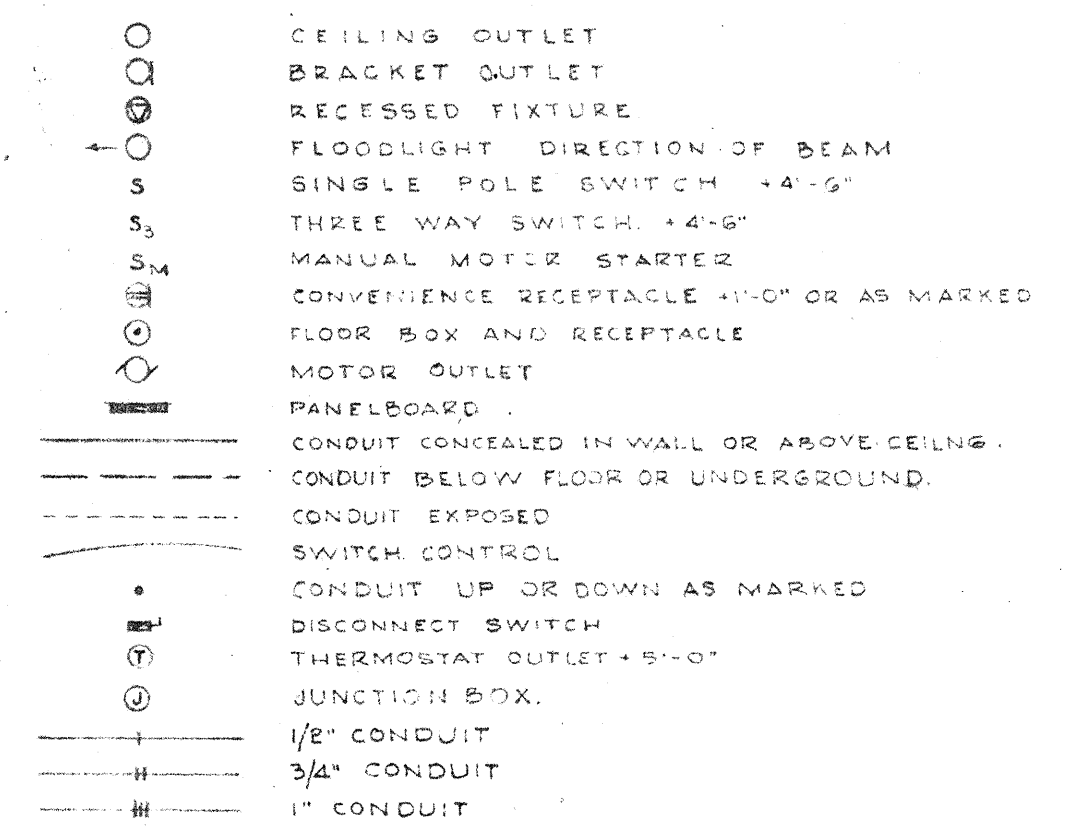

FEEDER SCHEDULE									
FEEDER	CONNECTION			FEEDER DATA		FEEDER SIZE		PROTECTION	
	FROM	TO	H. P.	AMPS	LENGTH	NO. & SIZE	SIZE	POLES	AMPS
LA	MAIN W.B.	PANEL "A"	17.4	40	120/240-14	3-#4/0	2 1/2"	2	225
LB	"	PANEL "B"	9.8	50	120/240-14	3-#4	1 1/4"	2	100
LC	"	PANEL "C"	4.8	30	120/240-14	3-#4	1 1/4"	2	70

1. FEEDER LENGTH IN SCHEDULE ARE APPROXIMATE FOR VOLTAGE DROP CALCULATION ONLY AND ARE NOT FOR MATERIAL TAKEOFF.

PANEL "C" SCHEDULE									
LOCATION - ROOM #102A					SURFACE MOUNTED				
FEEDER ENTRY - BOTTOM					120/240 V 14 3W 5/N				
CIR.	BREAKER	OUTLETS			WATTAGE				
NO.	POLES	AMPS	LTS	REC.	MISC.	BUSS A	BUSS B		
1		20	6			1080		ENTRANCE, 12, 104, & 106	
2			3			540		107	
3			7			1260		105, 103A, 103, 106 & ENTRANCE	
4					ELEC. HTR.	1500		107	
5				6		1080		102, 106, 106A & 107	
6				3		1110		102	
7					HEATERS	1500		107	
8		1	6			360		102	
9					SPARE	1000			
10						1000			
11					"	1000			
12		1	20		"	1000			
WATTS/BUSS						5310	5870		
TOTAL WATTAGE = 11,680						= 48 AMPS AT 240V.			

ABBREVIATIONS

C-2 CONDUIT ONLY
 MH MOUNTING HEIGHT TO BOTTOM OF FIXTURE
 14'-6" HEIGHT ABOVE FLOOR TO 6" OF OUTLET

NOTES

WHERE CONDUIT RUNS ARE MARKED 2-12, 3-12 ETC.
 THE FIRST NUMBER INDICATES THE NUMBER OF WIRES
 AND THE SECOND NUMBER INDICATES THE SIZE OF
 THE WIRES.
 WHERE NO NUMBERS ARE SHOWN ON ONE HALF
 INCH CONDUIT PROVIDE TWO NO. 12 WIRES.
 ARROWS ON CONDUITS INDICATE RUNS TO PANELS
 AND TERMINALS.
 OUTLETS MARKED AS FOLLOWS INDICATE:
 A TYPE OF LIGHTING FIXTURE
 B-20, 150 ETC. WATTAGE OF LAMPS.
 B-2 CIRCUIT NUMBER

PANEL "A" SCHEDULE									
LOCATION- ROOM #102					SURFACE MOUNTED				
FEEDER ENTRY - BOTTOM					120/240V 14 3W 5/N				
CIR.	BREAKER	OUTLETS	WATTAGE		BUSS A		DESTINATION		
NO.	POLES	AMPS	LTS	MISC.	BUSS A	BUSS B	ROOM NUMBERS		
1		20	2		1800		102		
2			2		1800		103		
3			2			1800	102		
4			2			1800	102		
5			5		700		102 & EXTERIOR LITES		
6			10		1800		101 & 102		
7		20	6			1080	E-101		
8		30		1 H.P.		1420	E-101 DISHWASHER		
9		20	6		1080		E-101		
10		20		1/3 H.P.	850		E-101 REFRIGERATOR		
11		30		3/4 H.P.		1660	E-101 DISPOSAL		
12		20		1/2 H.P.		1175	KITCHEN EXH. FAN ON ROOF		
13			4		720		101 & 102		
14			1		1000		E-101		
15			2			1670	E-99 & E-103		
16			1			1000	E-101		
17			1		1000		E-101		
18			1		1000		E-101		
19			1			1000	E-101		
20			1			1000	E-101		
21			1		1000		E-101		
22			1		1000		E-101		
23				SPARE		1000			
24						1000			
25				SPARE	1000				
26	1	20			1000				
27	1	20				970			
28	2	50			4500	4500	E-101 H.W. HEATER		
29									
30									
WATTS/BUSS					21430	2125			
TOTAL WATTAGE = 41,700 = 174 AMPS AT 240V.									

AS BUILT DRAWING BY J. HUGHES
 1011 E. BLUE DRIVE
 WEST COVINA
 3-1-67

REVISIONS	DATE	BY	DESCRIPTION
1	2/24/67	JH	PARISH HALL ADDITION
2			
3			
REVISED MARCH 25, 1966

JOHN H. CANT
 CONSULTING ENGINEER
 407 COMMERCIAL CENTER STREET
 BEVERLY HILLS, CALIFORNIA

BREO FREEMAN
 ARCHITECT
 45 SOUTH MARENGO
 PASADENA 1, CALIFORNIA

W.B. TERMINATING PULL BOX
 SIZED AS REQUIRED BY S.C.
 E.C.

NOTE:
 IT IS INTENDED THAT ALL CONDUIT IN THE
 KITCHEN BE CONCEALED. EXPOSED CONDUIT
 OR WIREMOLD SHALL ONLY BE RUN WITH
 SPECIFIC APPROVAL OF THE ARCHITECT.

SEE REVISED PART OF GROUND FLOOR PLAN DATED 2-25-66, SHEET C-3

GROUND FLOOR

S.C.A.L.E.: 1/4" = 1'-0"

CONTINUED ON SHEET C-2