


APPROX. LOCATION OF S.C. EDISON CO. POLE, SEE
SPEC'S FOR TERMINATION OF CONDUIT ON POLE.


M.L. 2-500 MCM 3/C

TERMINATING PULL BOX

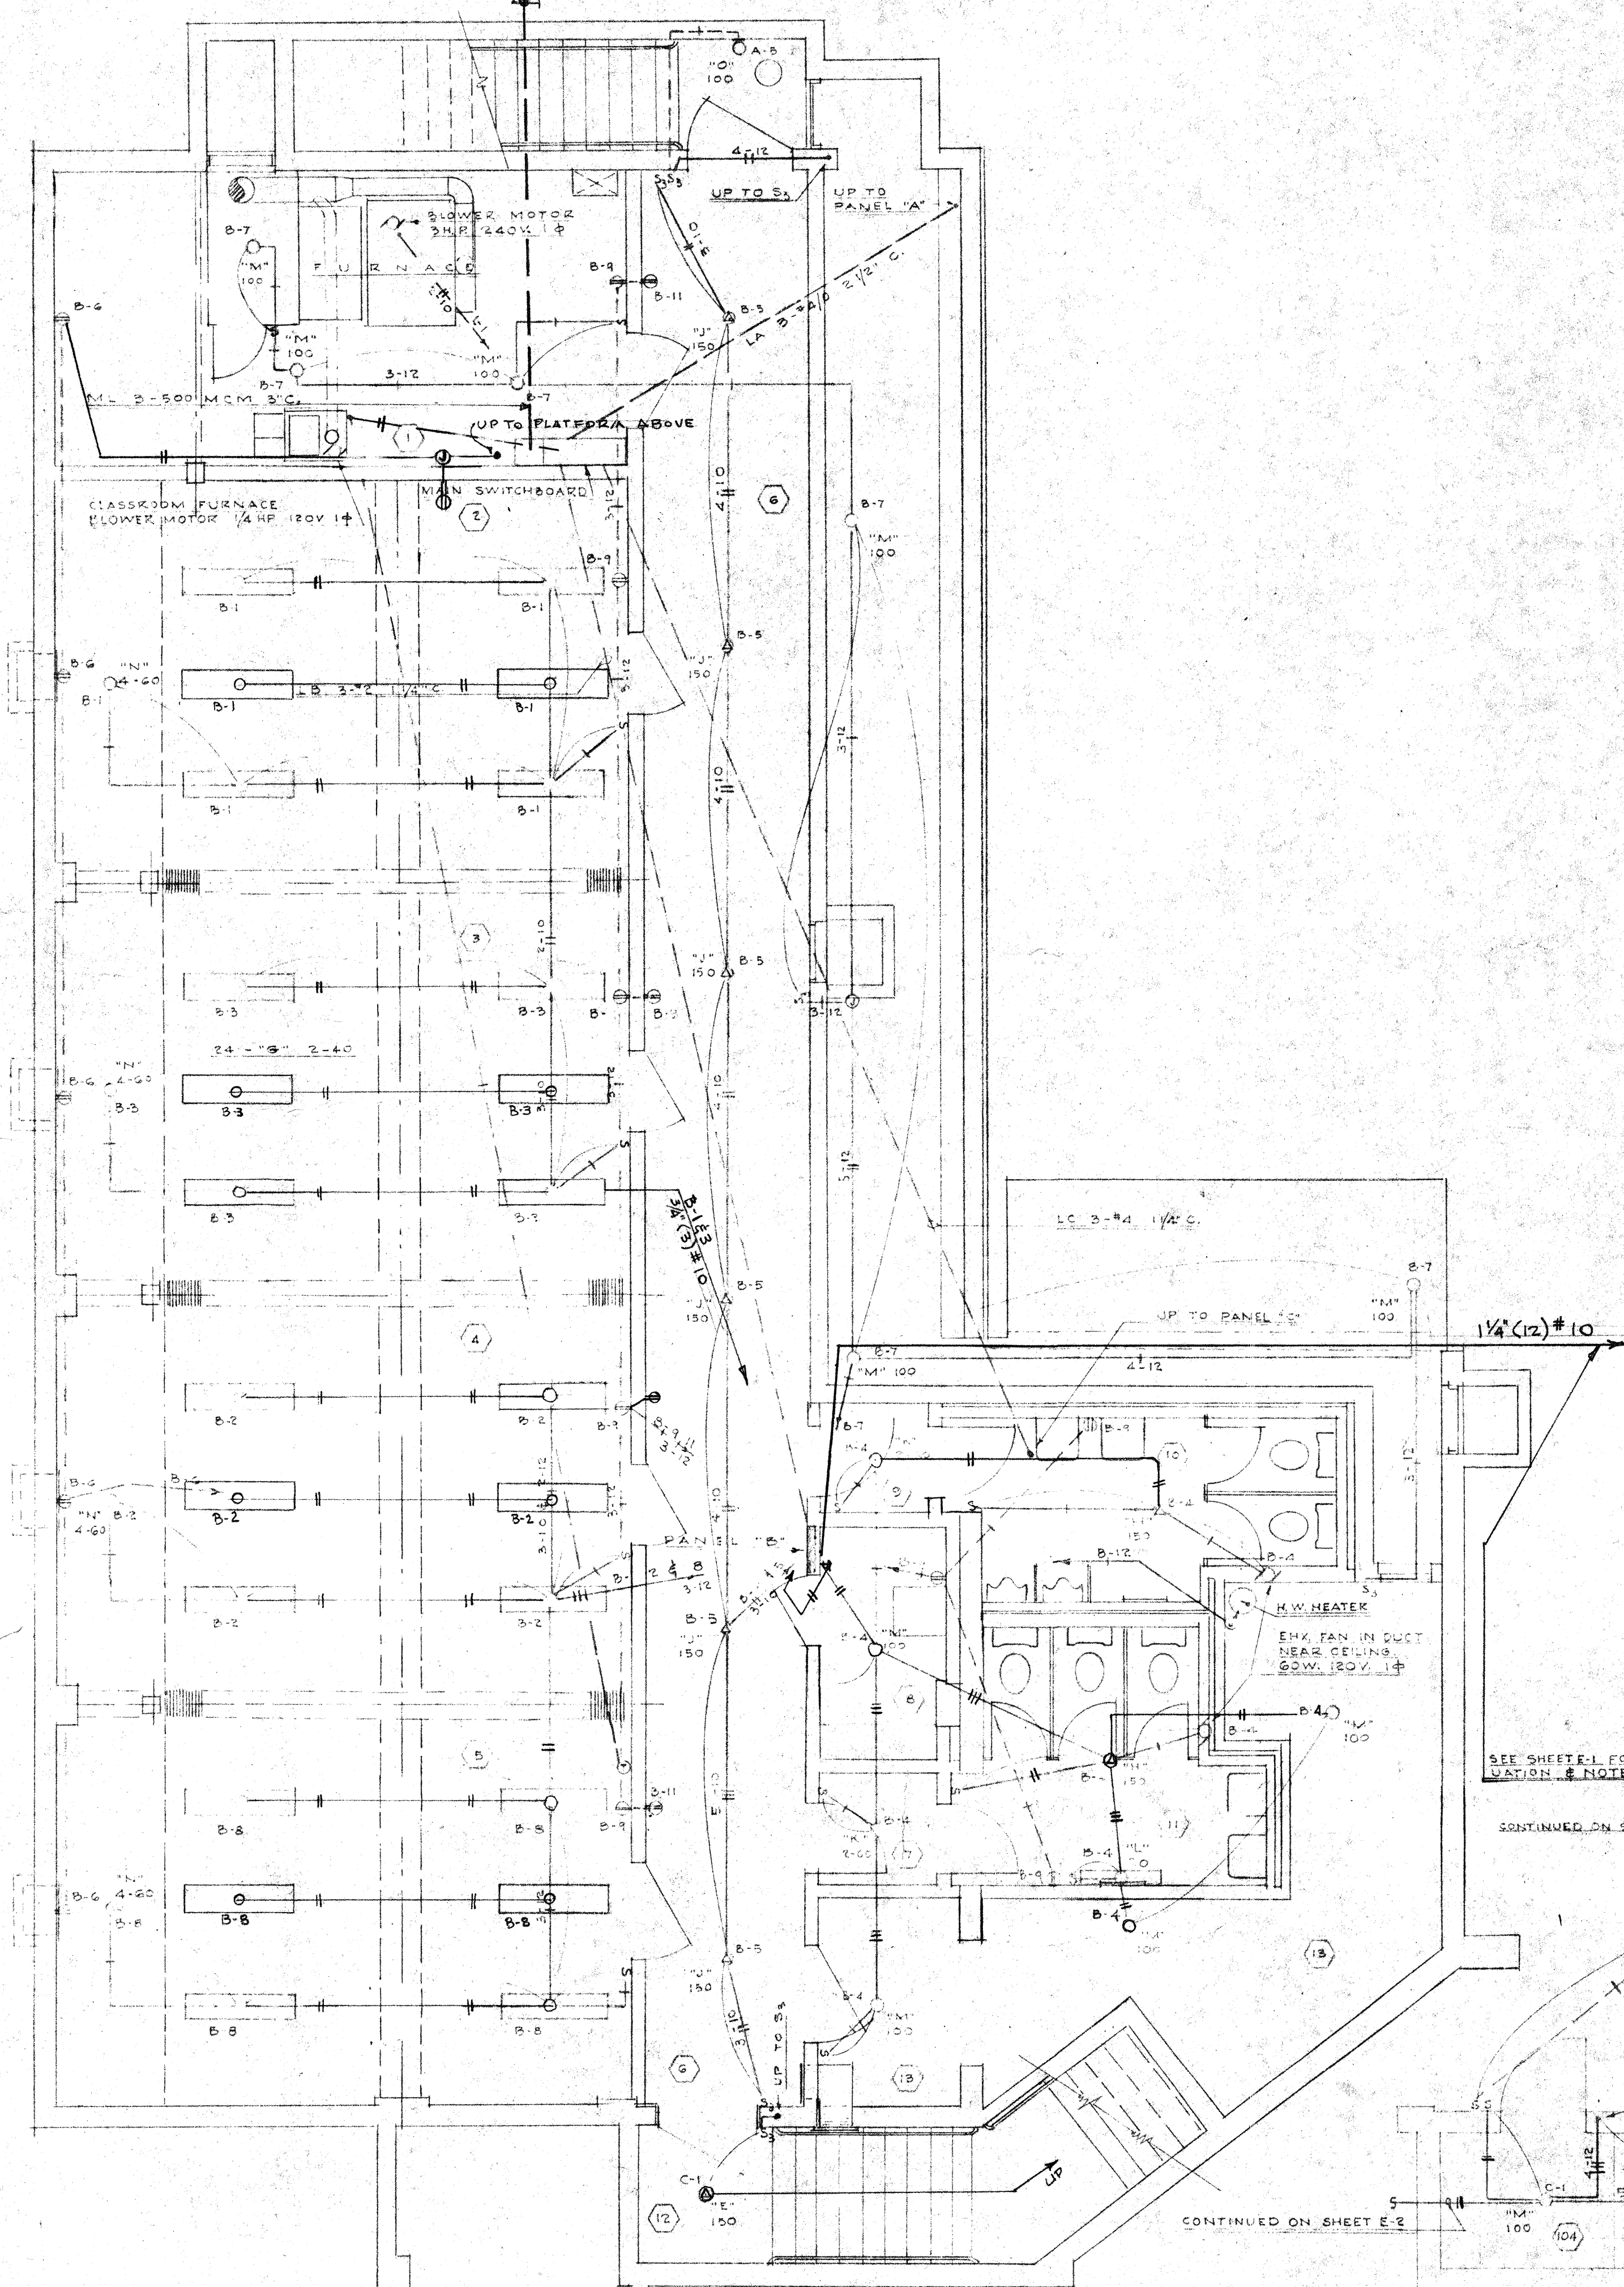

BASEMENT PLAN

S.C.A.L.E 1/4" = 1'-0"

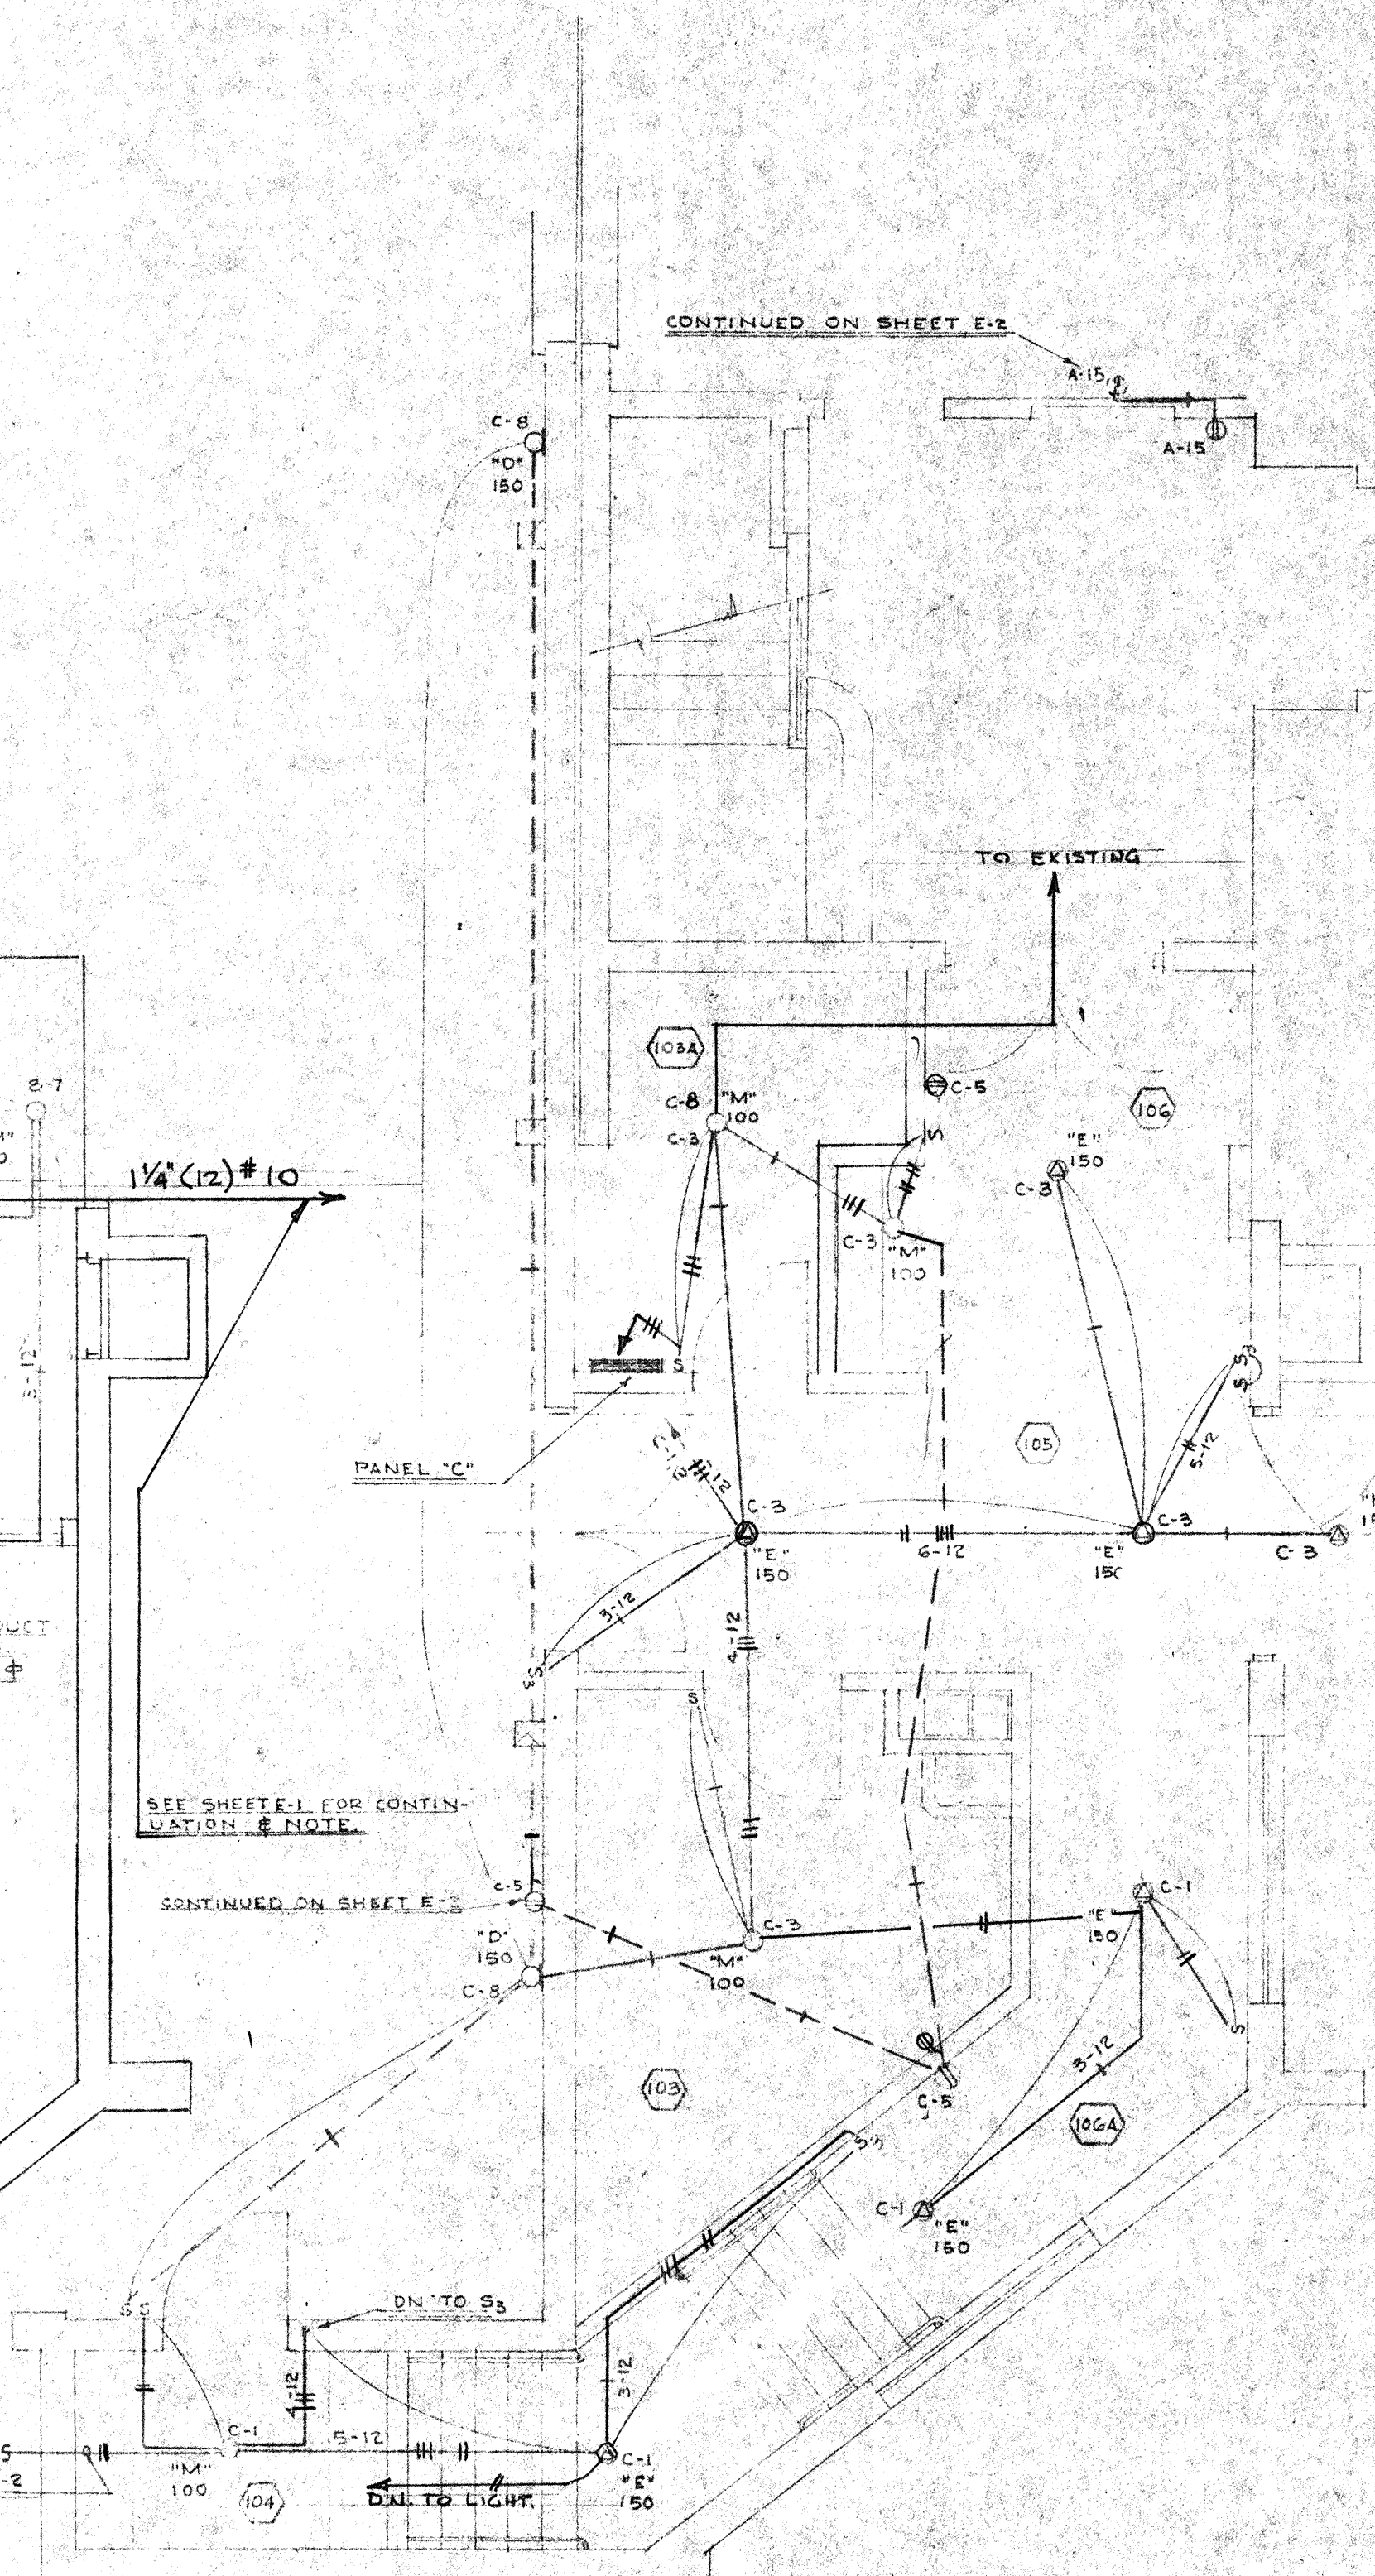

GROUND FLOOR

S.C.A.L.E 1/4" = 1'-0"

AS BUILT DRAWING BY J. HUGHES
1011 BLUE DRIVE
WEST COVINA
3-1-67

REVISED BASEMENT & PORTION OF GROUND FLOOR

REVISIONS	DATE	BY	FOR
1	2-24-67	J. HUGHES	PARISH HALL ADDITION
2			
3			
JOHN H. CARY
CONSULTING ENGINEER
407 COMMERCIAL CENTER STREET
BEVERLY HILLS, CALIFORNIA

BREO FREEMAN
ARCHITECT
45 SOUTH MARENGO
PASADENA 1, CALIFORNIA