

Onuma & Associates


Architecture, Planning, Consulting
511 Mission Street
South Pasadena, CA 91030
tel 626.799.9920
fax 626.799.8260
e-mail: info@onuma.com

Consultants

RENOVATION PROJECT FOR SAINT EDMUND'S EPISCOPAL CHURCH

1175 SAN GABRIEL BLVD., SAN MARINO, CA. 91108-8048

STAMPS

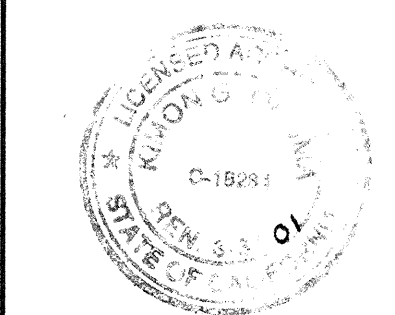

REVISIONS


DESCRIPTION	DATE	BY
PLAN CHECK		
PROJECT NUMBER	2000	
SCALE	AS NOTED	
PRINTED	11/16/00	
TITLE	RCP	
SHEET	A-3	

RCP

SHEET

A-3

6 OF 44

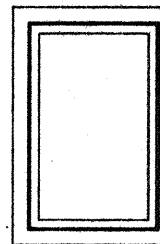

WINDOW SCHEDULE

ID	TYPE	WTH	HT	THK.	GLAZ'G	MAT'L	FINISH	JAMB	HEAD	SILL	REMARKS
1	MATCH EXIST.	4'-0"			SGL GLAZ'G WHITE TRANSLUCENT	WOOD	PAINT	8/A-8 SIM	8/A-8	7/A-8	

- CONTRACTOR TO VERIFY ALL EXISTING DIMENSIONS PRIOR TO COMMENCEMENT OF WORK
- CONTRACTOR TO SUBMIT SHOP DRAWINGS TO ARCHITECT FOR REVIEW
- CONTRACTOR TO SUBMIT GLASS SAMPLE TO ARCHITECT FOR REVIEW


DOOR NOTES:

- VERIFY ALL HEADER HEIGHTS PRIOR TO COMMENCEMENT OF WORK
- ALL SIZES ARE SASH TO SASH, ADD FRAME THICKNESS FOR FRAMING
- VERIFY ALL FLOOR THICKNESSES BEFORE FRAMING
- ALL DOOR STOPS TO BE WALL MOUNTED, APPROVED BY OWNER
- ALL GLASS TO BE TEMPERED
- ALL DOUBLE DOORS TO HAVE RIGHT LEAF ACTIVE FROM NARTHEX SIDE
- CONTRACTOR TO SUBMIT SHOP DRAWINGS FOR ALL CUSTOM DOORS TO ARCHITECT FOR REVIEW & INSTALL PER MANUFACTURER'S SPECIFICATIONS
- SUBMIT GLASS TO ARCHITECT FOR APPROVAL
- ALL RATED DOORS AND FRAMES TO BE LABELED IN ACCORDANCE WITH CBC 1004.2.4.3.2.1
- ALL GLAZING IN RATED DOORS TO COMPLY W/ CBC 719.7.4, 719.9.

HARDWARE LEGEND & NOTES:

- ALL PRIVACY LATCHES, LEVER STYLE, W/SELF-CLOSER, MATCH EXISTING
- LATCHES, LEVER STYLE, MATCH EXISTING
- (E) HARDWARE TO BE REMOVED AND REINSTALLED BY CONTRACTOR ON (N) DOOR
- INSTALL PANIC HARDWARE PER INTERIOR DESIGNER'S SPEC'S IF NOT NO PANIC HARDWARE EXISTS

- ALL HARDWARE FINISHES TO BE BRUSHED STAINLESS STEEL OR SATIN BRUSHED NICKEL U.N.O. - SEE OWNER
- HARDWARE TO BE "SLAVE" OR MATCH EXISTING, OR APPROVED EQUAL U.N.O. - SEE OWNER
- EXISTING DOORS AT NARTHEX, VESTIBULES 108 AND 110 TO BE EQUIPPED WITH PANIC HARDWARE PER CBC 1007.2.5, SEE INTERIOR DESIGNER FOR SPECIFICATIONS

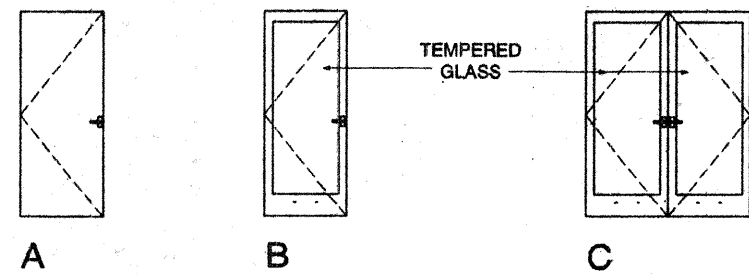

DOOR SCHEDULE


ID	W.	HT.	TK.	TYPE	MAT.	FIN.	GLAZ.	HW.	JAMB	HEAD	SILL	FIRE RATING	PANIC	REMARKS
A	3'-0"	6'-8"	1 3/4"	A	WOOD	PAINT	---	A	MATCH EXISTING	MATCH EXISTING	MATCH EXISTING	20 MIN.		
B	3'-0"	6'-8"	1 3/4"	A	WOOD	PAINT	---	A	MATCH EXISTING	MATCH EXISTING	MATCH EXISTING	20 MIN.		
C	2'-0"	5'-0"	1 3/4"	A	WOOD	PAINT	---	B	MATCH EXISTING	MATCH EXISTING	MATCH EXISTING	20 MIN.		
D	3'-0"	8'-0"	1 3/4"	B	WOOD	STAIN	FIRE GLAZ'G	C				20 MIN.	YES	
E	6'-0"pr	8'-0"	1 3/4"	C	WOOD	STAIN	FIRE GLAZ'G	C				20 MIN.	YES	
F	3'-0"	6'-8"	1 3/4"	A	WOOD	STAIN	---	C				20 MIN.		
G	6'-0"pr	7'-0"	2 1/2"	AA	WOOD	STAIN	---	C					YES	
H	EXIST'G	EXIST'G	EXIST'G	A	EXIST'G	EXIST'G	---	D	MATCH EXISTING	MATCH EXISTING	MATCH EXISTING		YES	(E) SOLID CORE DOOR TO BE REHANGED (D) REPAIR FRAME TO REMAIN.
I	2'-3"	6'-8"	1 3/4"	A	WOOD	PAINT	---	B	MATCH EXISTING	MATCH EXISTING	MATCH EXISTING			
J	2'-0"	6'-0"	1 3/4"	A	WOOD	STAIN	---	B	MATCH EXISTING	MATCH EXISTING	MATCH EXISTING			

FIRE GLAZING TO BE 45 MIN. RATED W/ MAX. AREA OF 1,390 SQ. FT.
CONTRACTOR TO SUBMIT SHOP DRAWINGS OF DOOR TH-1 & HARDWARE.



3M CP-25 CAULK NOTE:
USE CP-25 M. SELF-LEVELING CAULK ON HORIZONTAL SURFACES WHEN FILLING GAPS FROM ABOVE THE PENETRATION.

CONCRETE FLOOR SECTION VIEW

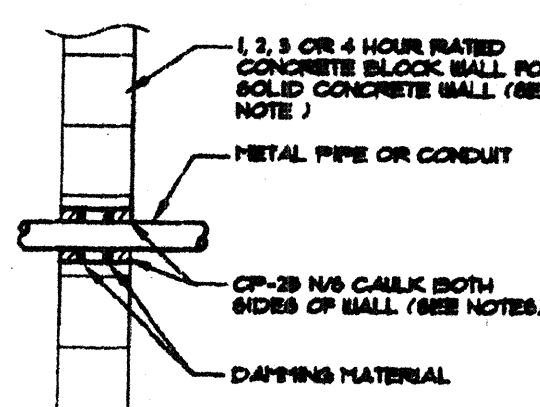


CONCRETE WALL SECTION VIEW

1/2, 3, OR 4 HOUR FIRES 3M FIRE BARRIER CP-25 N/8 AND S/L CAULK

PIPE PENETRATION DETAIL

3

N.T.S.

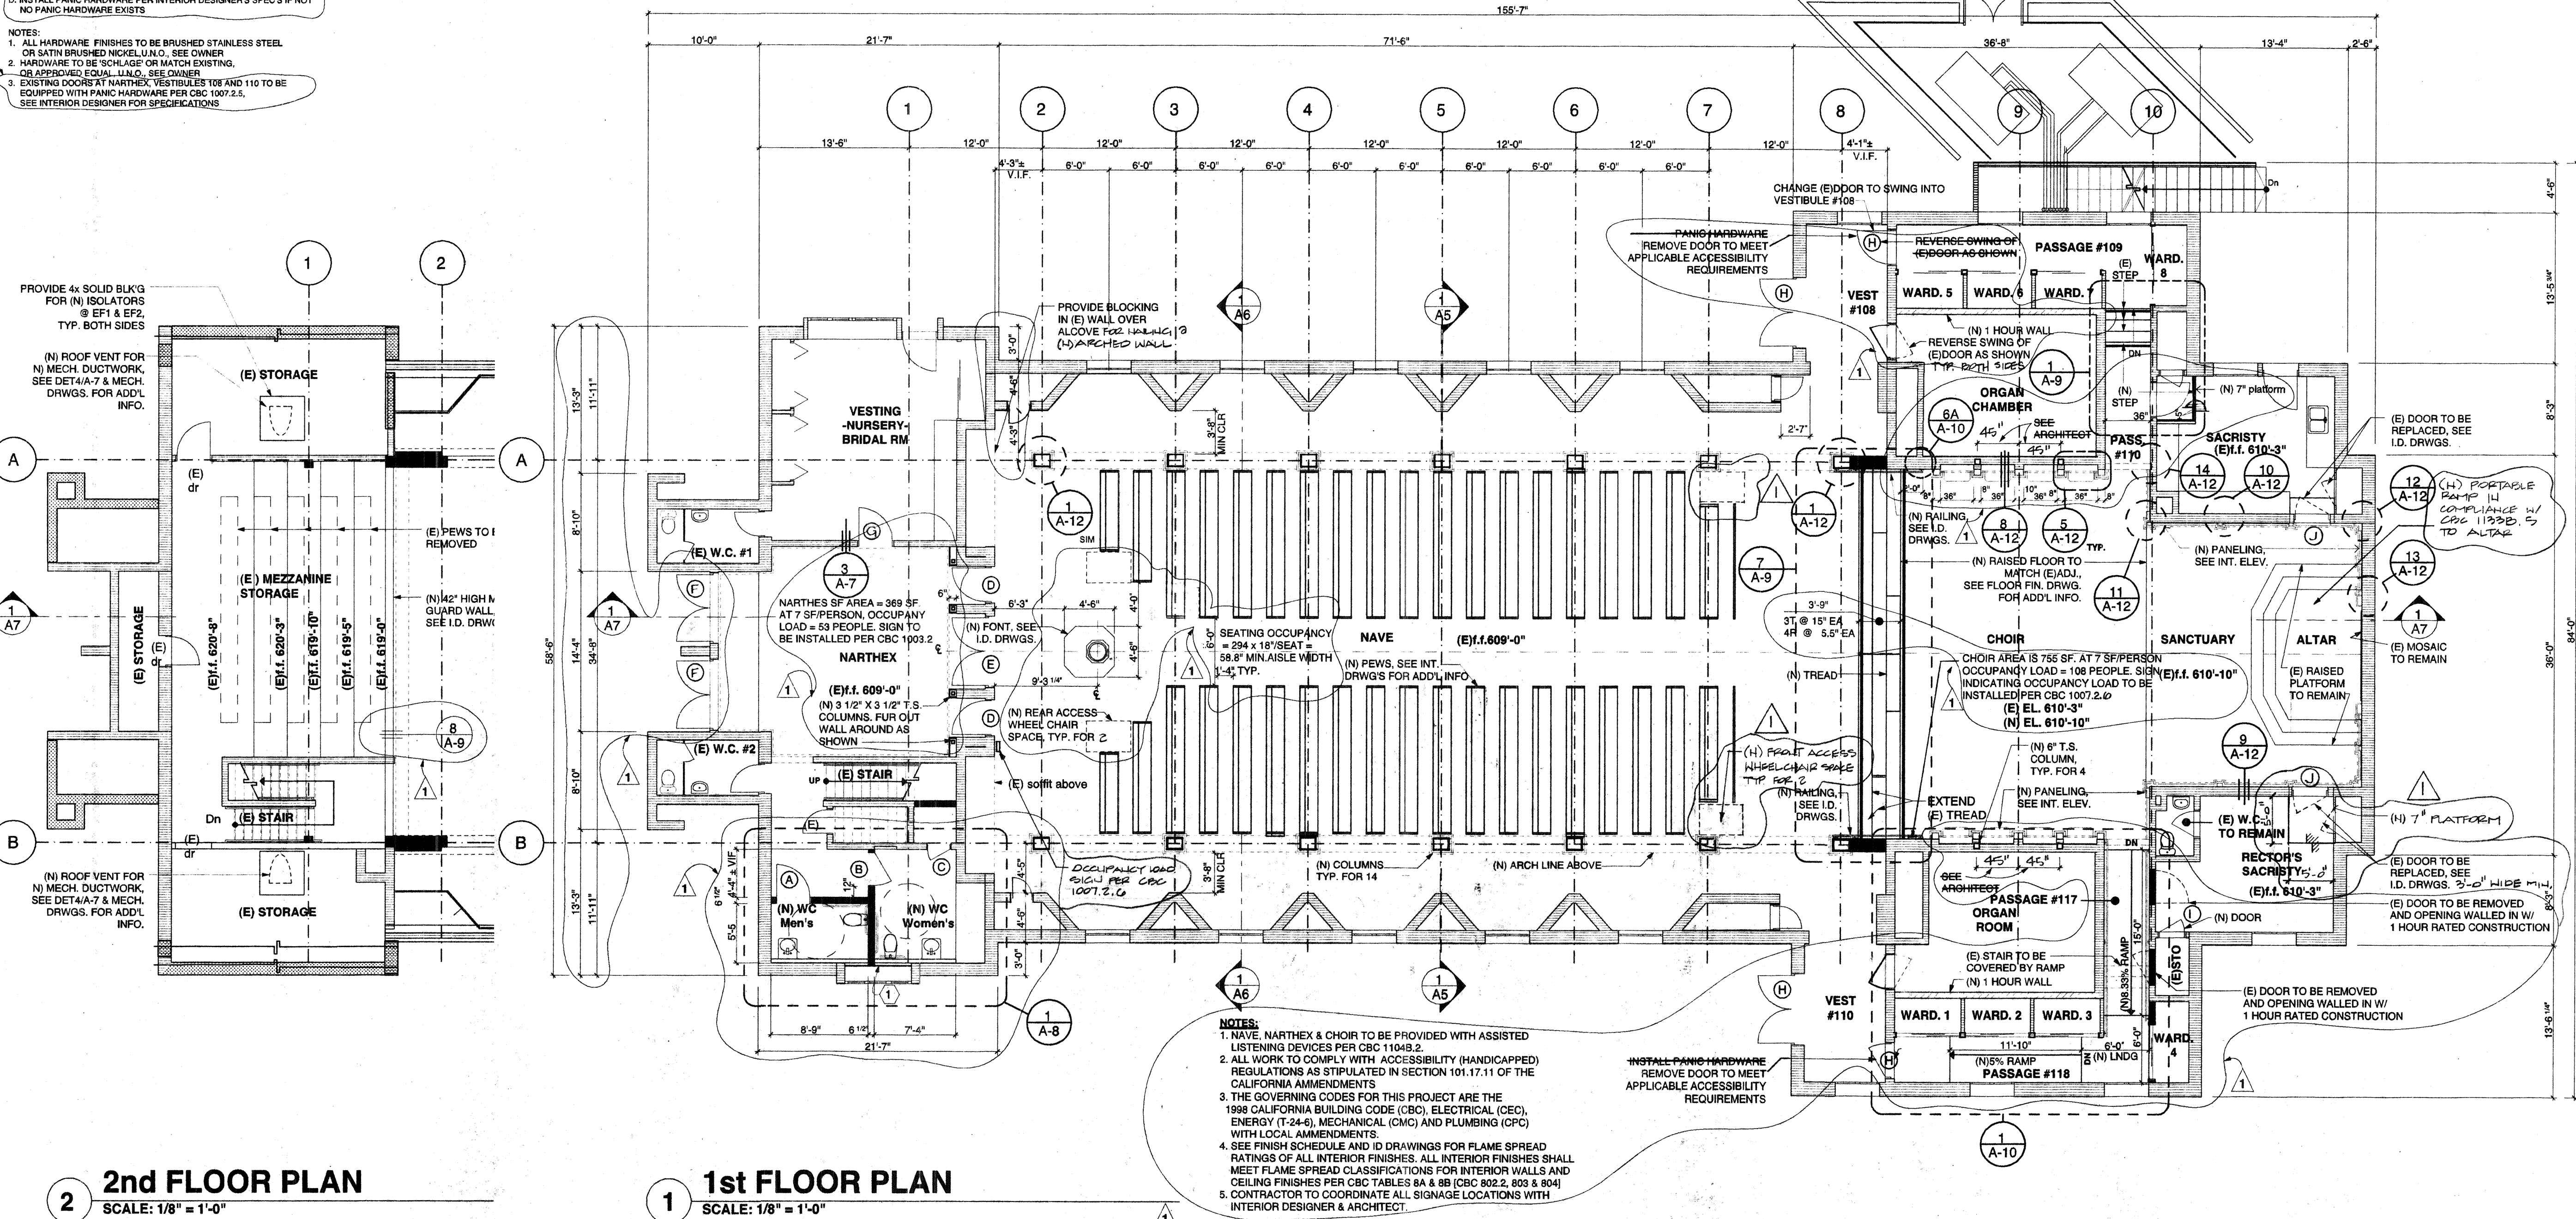

2 2nd FLOOR PLAN
SCALE: 1/8" = 1'-0"

1 1st FLOOR PLAN
SCALE: 1/8" = 1'-0"