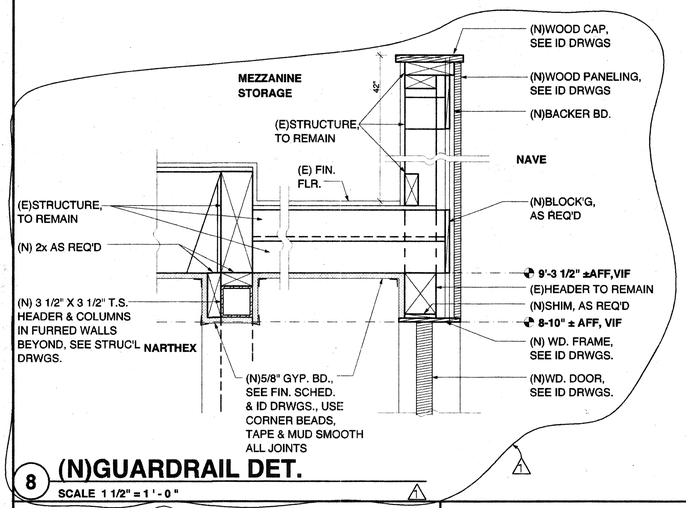

8 (N)GUARDRAIL DET.

SCALE 1 1/2" = 1 ' - 0 "

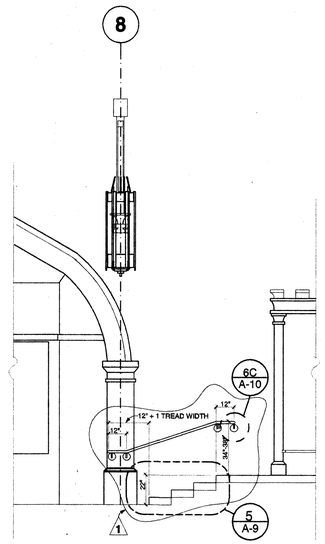

NAVE/CHOIR STAIR SECTION/ELEVATION

6 SCALE 1/4 " = 1 ' - 0 "

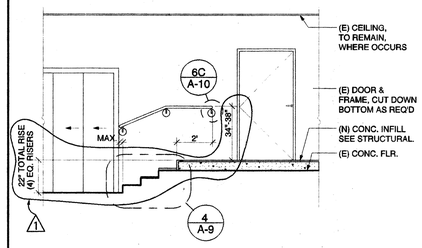

3 PASSAGE #110: STAIR ELEV.

SCALE 1/4 " = 1 ' - 0 "

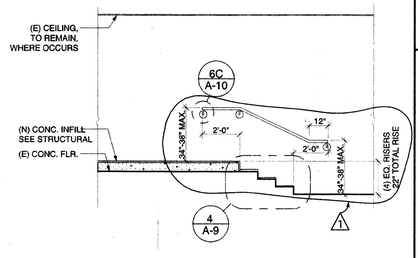

2 PASSAGE #110: STAIR ELEV.

SCALE 1/4 " = 1 ' - 0 "

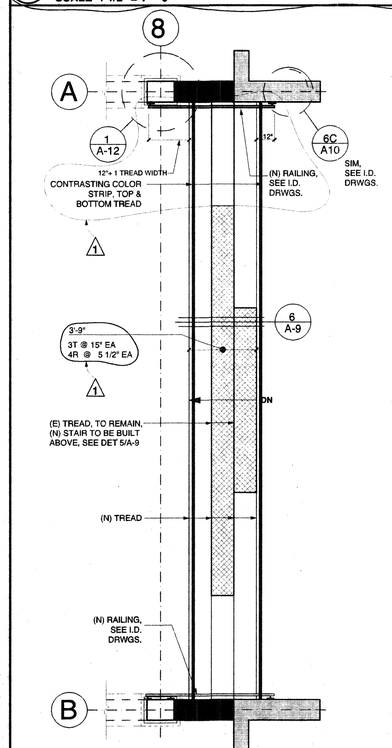

7 NAVE/CHOIR STAIR ENL. PLAN

SCALE 1/4 " = 1 ' - 0 "

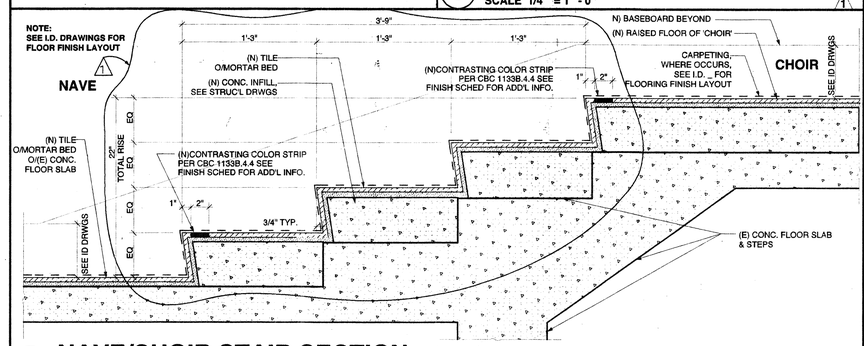

5 NAVE/CHOIR STAIR SECTION

SCALE 1 1/2" = 1 ' - 0 "

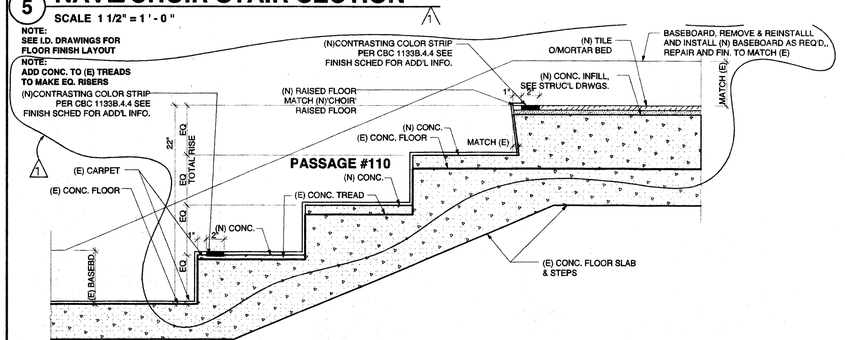

4 PASSAGE #110 STAIR SECT.

SCALE 1 1/2" = 1 ' - 0 "

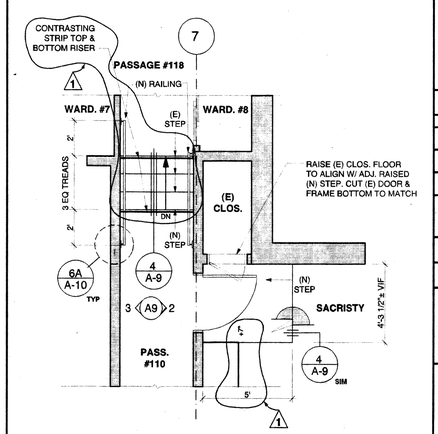

1 PASSAGE #110: ENLARGED STAIR PLAN

SCALE 1/4 " = 1 ' - 0 "

Onuma & Associates
Architecture, Planning, Consulting
511 Mission Street
South Pasadena, CA 91030
tel 626. 799. 9920
fax 626. 799. 8260
e-mail: info@onuma.com

Consultants

RENOVATION PROJECT FOR SAINT EDMUND'S EPISCOPAL CHURCH

1175 SAN GABRIEL BLVD., SAN MARINO, CA., 91108-8048

STAMPS

LICENSED ARCHITECT RAMON G. ONUMA C-18284 REN 3-31-01 STATE OF CALIFORNIA

REVISIONS

DESCRIPTION	DATE	BY
PLAN CHECK		

PROJECT NUMBER 2000

SCALE AS NOTED

PRINTED 11/16/00

TITLE STAIRS ENLARGED PLANS, ELEVATIONS & DETAILS

SHEET **A-9**