

CERTIFICATE OF COMPLIANCE		(Part 1 of 2)	LTG-1
PROJECT NAME REMODEL OF SAINT EDMUND'S EPISCOPAL CHURCH		DATE 11/13/00	
PROJECT ADDRESS 1715 SAN GABRIEL BLVD, SAN MARINO, CA		TELEPHONE 323-667-9082	Building Permit #
PRINCIPAL DESIGNER-LIGHTING JOSEPH McDOWELL		TELEPHONE 323-667-9082	Checked by/Date Enforcement Agency Use
GENERAL INFORMATION			
DATE OF PLANS 11/13/00	BUILDING CONDITIONED FLOOR AREA 5295	CLIMATE ZONE 1	
BUILDING TYPE	☒ NONRESIDENTIAL	☐ HIGH RISE RESIDENTIAL	☐ HOTEL/MOTEL GUEST ROOM
PHASE OF CONSTRUCTION	☐ NEW CONSTRUCTION	☐ ADDITION	☒ ALTERATION
METHOD OF LIGHTING COMPLIANCE	☐ COMPLETE BLDG.	☒ AREA CATEGORY	☐ TAILORED
			☐ PERFORMANCE
STATEMENT OF COMPLIANCE			

This Certificate of Compliance lists the building features and performance specifications needed to comply with Title 24, Parts 1 and 6 of the California Code of Regulations. This certificate applies only to building lighting requirements.

The documentation preparer hereby certifies that the documentation is accurate and complete.

DOCUMENTATION AUTHOR JOSEPH McDOWELL	SIGNATURE	DATE 11/13/00
---	-----------	------------------

The Principal Lighting Designer hereby certifies that the proposed building design represented in this set of construction documents is consistent with the other compliance forms and worksheets, with the specifications, and with any other calculations submitted with this permit application. The proposed building has been designed to meet the envelope requirements contained in the applicable parts of Sections 110, 119, 130 through 132, 146 and 149 of Title 24, Part 6.

Please check one:

☒ I hereby affirm that I am eligible under the provisions of Division 3 of the Business and Professions Code to sign this document as the person responsible for its preparation; and that I am licensed in the State of California as a civil engineer or electrical engineer, or I am a licensed architect.

☐ I affirm that I am eligible under the provisions of Division 3 of the Business and Professions Code by section 5537.2 or 6737.3 to sign this document as the person responsible for its preparation; and that I am a licensed contractor performing this work.

☐ I affirm that I am eligible under Division 3 of the Business and Professions Code to sign this document because it pertains to a structure or type of work described as exempt pursuant to Business and Professions Code Sections 5537, 5538 and 6737.1.

(These sections of the Business and Professions Code are printed in full in the Nonresidential Manual.)

PRINCIPAL LIGHTING DESIGNER-NAME RUSSEL P. RANDALL	SIGNATURE	DATE 11/13/00	LIC. # E-4848
---	-----------	------------------	------------------

LIGHTING MANDATORY MEASURES

Indicate location on plans of Note Block for Mandatory Measures

E-1

INSTRUCTIONS TO APPLICANT

For detailed instructions on the use of this and all Energy Efficiency Standards compliance forms, please refer to the Nonresidential Manual published by the California Energy Commission.

LTG-1: Required on plans for all submittals. Part 2 may be incorporated in schedules on plans.

LTG-2: Required for all submittals.

LTG-3: Optional. Use only if lighting control credits are taken.

LTG-4: Optional. Use only if Tailored Method is used. Parts 2 and 3 used only if applicable.

Nonresidential Compliance Form

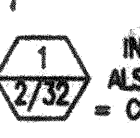
November 1998

MANDATORY MEASURES CHECKLIST

PROJECT NAME REMODEL OF SAINT EDMUND'S EPISCOPAL CHURCH	DATE 11/13/00
--	------------------

☐ Certified luminaires/ballasts per 2-5314(b).	E-1
☐ Independent control with enclosed areas per 2-5319(a).	E-5
☐ Manual switching readily accessible per 2-5319(b).	E-5
☐ Reduction of lighting load to at least one half per 2-5319(c). Occupancy sensors or programmable timers meeting CEC criteria may substitute.	E-5
☐ Separate switching of daylight areas per 2-5319(d).	N/A
☐ Override for building lighting shut-off. The automatic building shut-off system is provided with a manual, accessible override switch in sight of the lights. The area of override is not to exceed 5,000 SF.	N/A
☐ All three lamp fluorescent fixtures are specified with electronic high-frequency ballasts and are exempt from two-lamp tandem wiring requirements.	N/A
☐ Uniform Reduction for Individual Rooms. All rooms and areas greater than 100 square feet and more than 1.2 watts per square foot of lighting load shall be controlled with bi-level switching for uniform reduction of lighting within the room.	E-5

GENERAL NOTES

- MINIMUM WIRE SIZE FOR LINE VOLTAGE WIRING SHALL BE #12.
- ALL CONDUIT SIZES SHALL CONFORM TO THE BASIC ELECTRICAL REGULATIONS OF THE CALIFORNIA ADMINISTRATIVE CODE, UNLESS NOTED AS LARGER.
- SUBSCRIPTS, a,b,c ETC., AT SWITCH SYMBOLS, ARE TO DISTINGUISH BETWEEN SWITCHES.
- +4'-6" INDICATES A MOUNTING HEIGHT FROM FINISHED FLOOR TO CENTER OF EQUIPMENT OR OUTLET.
-  INDICATES: 1 = FIXTURE TYPE; 2/32 = NUMBER OF LAMPS AND WATTAGE PER LAMP. ALSO NUMBER ADJACENT TO FIXTURE = CIRCUIT NUMBER, AND LOWER CASE LETTER = CONTROLLING SWITCH.
- N.H. INDICATES HEIGHT FROM FINISHED FLOOR TO BOTTOM OF FIXTURE.
- ALL OUTLETS SHALL BE INSTALLED AT THE HEIGHTS INDICATED IN THE SYMBOLS, UNLESS NOTED OTHERWISE ON THE DRAWINGS.
- REFER TO WIRING DIAGRAMS ON MECHANICAL DRAWINGS.
- ALL SYMBOLS SHOWN IN SYMBOL LIST ARE NOT NECESSARILY USED ON THIS PROJECT.
- EVERY OUTLET HEIGHT SHALL BE VERIFIED ON EACH WALL WITH THE ARCHITECTURAL DRAWINGS AND CABINET SHOP DRAWINGS TO INSURE THE PROPER HEIGHT AND LOCATION WITH RESPECT TO CABINETS, EQUIPMENT, CHALKBOARDS, TACKBOARDS, ETC.
- COORDINATE WITH THE OTHER TRADES, IN ADVANCE OF CONSTRUCTION, THE CEILING AREAS IN WHICH RECESSED LIGHTING FIXTURES OCCUR. THIS SHALL INCLUDE PLUMBING, HEATING, AND VENTILATING, AIR CONDITIONING AND CARPENTRY. IN THE EVENT OF ANY CONFLICT, THE ARCHITECT SHALL BE NOTIFIED IMMEDIATELY.
- GREEN INSULATED COPPER GROUNDING CONDUCTOR SHALL BE INSTALLED AND CONNECTED TO EACH OUTLET, ENCLOSURE, DEVICE, FIXTURE, ETC. THROUGHOUT THE ENTIRE PROJECT. THE RACEWAYS SHALL NOT BE RELIED UPON FOR "EQUIPMENT GROUNDING".
- SEE ARCHITECTURAL REFLECTED CEILING PLAN FOR EXACT LOCATION OF LIGHTING FIXTURES.
- PANEL HOMERUN DESIGNATIONS:**
BA-1&2&5 = ONE THREE PHASE CIRCUIT, NO NEUTRAL TO PANEL "BA".
BA-1&3 = ONE SINGLE PHASE CIRCUIT, NO NEUTRAL TO PANEL "BA".
BA 1-3-5 = THREE SINGLE PHASE CIRCUITS WITH COMMON NEUTRAL TO PANEL "BA".
BA 1,2,3 = THREE SINGLE PHASE CIRCUITS WITH A SEPARATE NEUTRAL FOR EACH CIRCUIT TO PANEL "BA".
- SEE NOTE 21 SHT M.O.I FOR OPERATING - SERVICE - MAINTENANCE PROCEDURE SUBMITTAL REQUIREMENTS. TYP. FOR ELECT. EQUIPMENT.

SPECIAL CONSTRUCTION NOTES

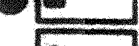
- THE CONTRACTOR SHALL THOROUGHLY FAMILIARIZE HIMSELF WITH THE EXISTING CONDITIONS AT THE JOB SITE. NEW WORK SHALL BE COORDINATED WITH ALL EXISTING MATERIALS, EQUIPMENT, SUPPORTS AND OBSTRUCTIONS. THE PLANS INDICATE DIAGRAMMATICALLY THE ROUTE REQUIRED FOR THE NEW CONDUIT INSTALLATION.
- MAKE ALL NECESSARY ALTERATIONS TO COORDINATE AND CONNECT THE EXISTING WITH THE NEW ELECTRICAL WORK SUCH THAT WHEN THE WORK IS COMPLETE, THE ENTIRE ELECTRICAL INSTALLATION, EXISTING AND NEW, IS IN A SATISFACTORY OPERATING CONDITION.
- PERFORM ELECTRICAL WORK IN SUCH A MANNER AS NOT TO INTERFERE IN ANY WAY WITH THE SATISFACTORY PERFORMANCE OF ELECTRICAL SYSTEMS IN THE BUILDING. NONE OF THE SYSTEMS SHALL BE DISCONNECTED WHILE THE BUILDING IS IN USE, UNLESS SCHEDULED WITH AND AGREED TO BY THE OWNER IN WRITING.
IF OVERTIME IS REQUIRED TO COMPLY WITH NOTE ABOVE, IT SHALL BE INCLUDED AS PART OF THE BID.
- ALL DRILLING, PATCHING, CUTTING, CHANNELING OF MASONRY, PLASTER OR DRYWALL WHICH IS REQUIRED TO INSTALL THE ELECTRICAL WORK SHALL BE DONE BY THIS CONTRACTOR.
- ALL NEW CONDUIT INSTALLED SHALL BE RIGID OR EMT. ALL CONDUCTORS SHALL BE COPPER.
- NOT ALL EXISTING ELECTRICAL SYSTEMS WITHIN THE REMODELED AREA THAT MUST BE DEMOLISHED AND/OR REMOVED ARE SHOWN ON THE ELECTRICAL DRAWINGS. THE CONTRACTOR SHALL MAKE ALLOWANCES IN HIS BID FOR THE REMOVAL OF ELECTRICAL SYSTEMS WITHIN THE AREA OF REMODEL. BRANCH CIRCUITS SERVING ELECTRICAL SYSTEMS OUTSIDE THE AREA OF REMODEL SHALL BE RECONNECTED AND CONTINUITY MAINTAINED. ELECTRICAL EQUIPMENT INDICATED AS EXISTING TO BE RELOCATED SHALL CAREFULLY BE REMOVED AND STORED FOR FUTURE RE-INSTALLATION. THE CONTRACTOR MAY RE-USE ABANDONED CONDUITS FOR HOMERUNS TO EXISTING PANELS.
-

LIGHTING MANDATORY MEASURES NOTES:

PROJECT NAME REMODEL OF SAINT EDMUND'S EPISCOPAL CHURCH	DATE 11/13/00
--	------------------

- ALL AUTOMATIC CONTROL DEVICES SHALL BE CERTIFIED, ALL ALTERNATE EQUIPMENT SHALL BE CERTIFIED AND INSTALLED AS DIRECTED BY THE MANUFACTURER.
- ALL FLUORESCENT FIXTURES SHALL BE CERTIFIED AND LISTED IN THE DIRECTORY. ALL INSTALLED FIXTURES SHALL BE CERTIFIED.
- ALL THREE LAMP FLUORESCENT FIXTURES ARE SPECIFIED WITH ELECTRONIC HIGH-FREQUENCY BALLASTS AND ARE EXEMPT FROM TWO-LAMP TANDEM WIRING REQUIREMENTS.
- EACH ROOM AND AREA IN THIS BUILDING IS EQUIPPED WITH A SEPARATE SWITCH AND OCCUPANCY SENSOR FOR EACH AREA WITH FLOOR-TO-CEILING WALLS.
- ALL LIGHT FIXTURES WITHIN DAYLIT AREAS ARE CONTROLLED SEPARATELY.
- EXTERIOR MOUNTED FIXTURE AND SERVED FROM THE ELECTRICAL PANEL INSIDE THE BUILDING ARE CONTROLLED WITH SEPARATE AUTOMATIC TIME SWITCHES.

ELECTRICAL SYMBOLS LIST

	LIGHTING FIXTURE WALL MOUNTED
	FLUORESCENT STRIP LIGHT FIXTURE, SURFACE MOUNTED ON CEILING
	FLUORESCENT LIGHT FIXTURE, RECESSED IN CEILING
	EMERGENCY FLUORESCENT LIGHT FIXTURE, RECESSED IN CEILING
	FLUORESCENT LIGHT FIXTURE, SURFACE MOUNTED ON CEILING
	ROUND LIGHTING FIXTURE, RECESSED IN CEILING
	LANDSCAPE BOLLARD LIGHT FIXTURE
	ROUND WALL WASHER LIGHTING FIXTURE, RECESSED IN CEILING
	ROUND LIGHTING FIXTURE, SURFACE MOUNTED ON CEILING
	SELF-LUMINOUS EXIT SIGN, CEILING MOUNTED
	SELF-LUMINOUS EXIT SIGN, WALL OR DOOR MOUNTED. "L" INDICATED EXIT SIGN LOCATED WITHIN 4 INCHES OF THE LATCH SIDE OF DOOR, BOTTOM OF SIGN, 6" ABOVE FINISHED FLOOR.
	GROUND FAULT INTERRUPTING DUPLEX CONVENIENCE OUTLET, +18", OR AS NOTED
	DOUBLE DUPLEX GROUNDING CONVENIENCE OUTLET. +18" OR AS NOTED.
	DUPLEX GROUNDING CONVENIENCE OUTLET, +18", OR AS NOTED
	JUNCTION BOX, ABOVE CEILING
	JUNCTION BOX, WALL MOUNTED, +18", OR AS NOTED
	DISCONNECT, SIZE AND NUMBER AS REQUIRED, 30A-3P MINIMUM, "F" = FUSE
	MANUAL MOTOR STARTER WITH THERMAL OVERLOADS
	BY-PASS TIMER, +48"
	MICROPHONE OUTLET FLUSH IN WALL +18" OR AS NOTED.
	TELEPHONE OUTLET, +18", OR AS NOTED
	PUBLIC ADDRESS SPEAKER FLUSH IN CEILING
	PUBLIC ADDRESS SPEAKER.
	FLUSH MOUNTED PANELBOARD, +6'-6" TO TOP
	SURFACE MOUNTED PANELBOARD, +6'-6" TO TOP
	SURFACE MOUNTED CABINET OR EQUIPMENT AS NOTED, +6'-6" TO TOP
	FLUORESCENT WALL DIMMER, +48"
	TOGGLE SWITCH, +48"
	SUFFIXES ON SWITCH SYMBOLS SHALL INDICATE THE FOLLOWING: NO SUFFIX = SINGLE POLE, 2 = 2 POLE, 3 = 3 WAY, 4 = 4 WAY, M = MOMENTARY CONTACT LV = LOW VOLTAGE LIGHTING CONTROL
	DUCT SMOKE DETECTOR 120V.
	DIMMER CONTROL DMX OUTLET +18".
	DIMMER CONTROL ENTRY CONTROL STATION +48".
	DIMMER CONTROL PRESET CONTROL STATION +48".
	SUSPENDED CUSTOM CHANDELIER WITH CENTER LAMPS (5/40W) ON EMERGENCY SYSTEM FINISH BY OTHERS
	CONDUIT RUN CONCEALED ABOVE CEILINGS OR IN WALLS
	CONDUIT RUN CONCEALED UNDER FLOOR OR BELOW GRADE
	CONDUIT RUN EXPOSED PARALLEL OR PERPENDICULAR TO STRUCTURE, ALIGN WITH STRUCTURE
	FLEXIBLE STEEL CONDUIT
	CONDUIT "HOME RUN," CONNECT TO PANEL, TERMINAL CABINET OR TERMINAL BOARD
	3/4" CONDUIT WITH ONE MICROPHONE CABLE
	3/4" CONDUIT WITH TWO MICROPHONE CABLES
	3/4" CONDUIT WITH ONE SPEAKER CABLE
	3/4" CONDUIT WITH TWO SPEAKER CABLES.
	NUMBER INDICATES NUMBER OF SPEAKER CABLE IN 3/4" CONDUIT UNLESS OTHERWISE NOTED
	1" CONDUIT WITH EIGHT SPEAKER CABLES
	TELEPHONE SYSTEM CONDUIT, 3/4" C.O. OR AS NOTED
	PUBLIC ADDRESS SYSTEM CONDUIT, ONE PAIR (BELDEN #8760), 3/4" C.O. OR AS NOTED
	EXISTING CONDUIT AND CONDUCTORS TO REMAIN
	EXISTING CONDUIT AND CONDUCTORS, REMOVE CONDUCTORS AND CONDUIT IF EXPOSED
	3/4"C-2#12
	3/4"C-4#12
	1"C-6#12
	1"C-8#12
	WIRE SIZE OTHER THAN #12 IS NOTED ON EACH CONDUIT RUN WITH SIZE OF CONDUIT (e.g.: 3/4"C-3#10). INCLUDE A GREEN GROUND CONDUCTOR IN EACH CONDUIT. (GREEN CONDUCTOR NOT SHOWN).
	NEW PANEL BOARD DESIGNATION
	TERMINAL CABINET OR BACKBOARD DESIGNATION
	FEEDER DESIGNATION (SEE FEEDER SCHEDULE)
	REFERENCE NOTE
	DASHED SYMBOL INDICATES EXISTING ELECTRICAL ITEM TO REMAIN UNLESS NOTED OTHERWISE. "XR" ADJACENT TO SYMBOL INDICATES ITEM IS TO BE REMOVED. PROVIDE BLANK COVER PLATE FOR OUTLET.

Onuma & Associates

Architecture, Planning, Consulting
511 Mission Street
South Pasadena, CA 91030
tel 626. 799. 9920
fax 626. 799. 8260
e-mail: info@onuma.com

Consultants

RANDALL ENGINEERING
CONSULTING ELECTRICAL ENGINEER
1775 SAN GABRIEL BLVD., SAN MARINO, CA 91039
323-667-9081 • Fax: 323-667-9083



REMODEL FOR
SAINT EDMUND'S
EPISCOPAL CHURCH
1775 SAN GABRIEL BLVD., SAN MARINO, CA, 91038-8048

STAMPS



REVISIONS

DESCRIPTION	DATE	BY

PROJECT NUMBER
RE-123

SCALE
NOT TO SCALE

PRINTED
12/27/00

TITLE
ELECTRICAL SYMBOLS
AND GENERAL NOTES

SHEET

E-1

37 OF 44