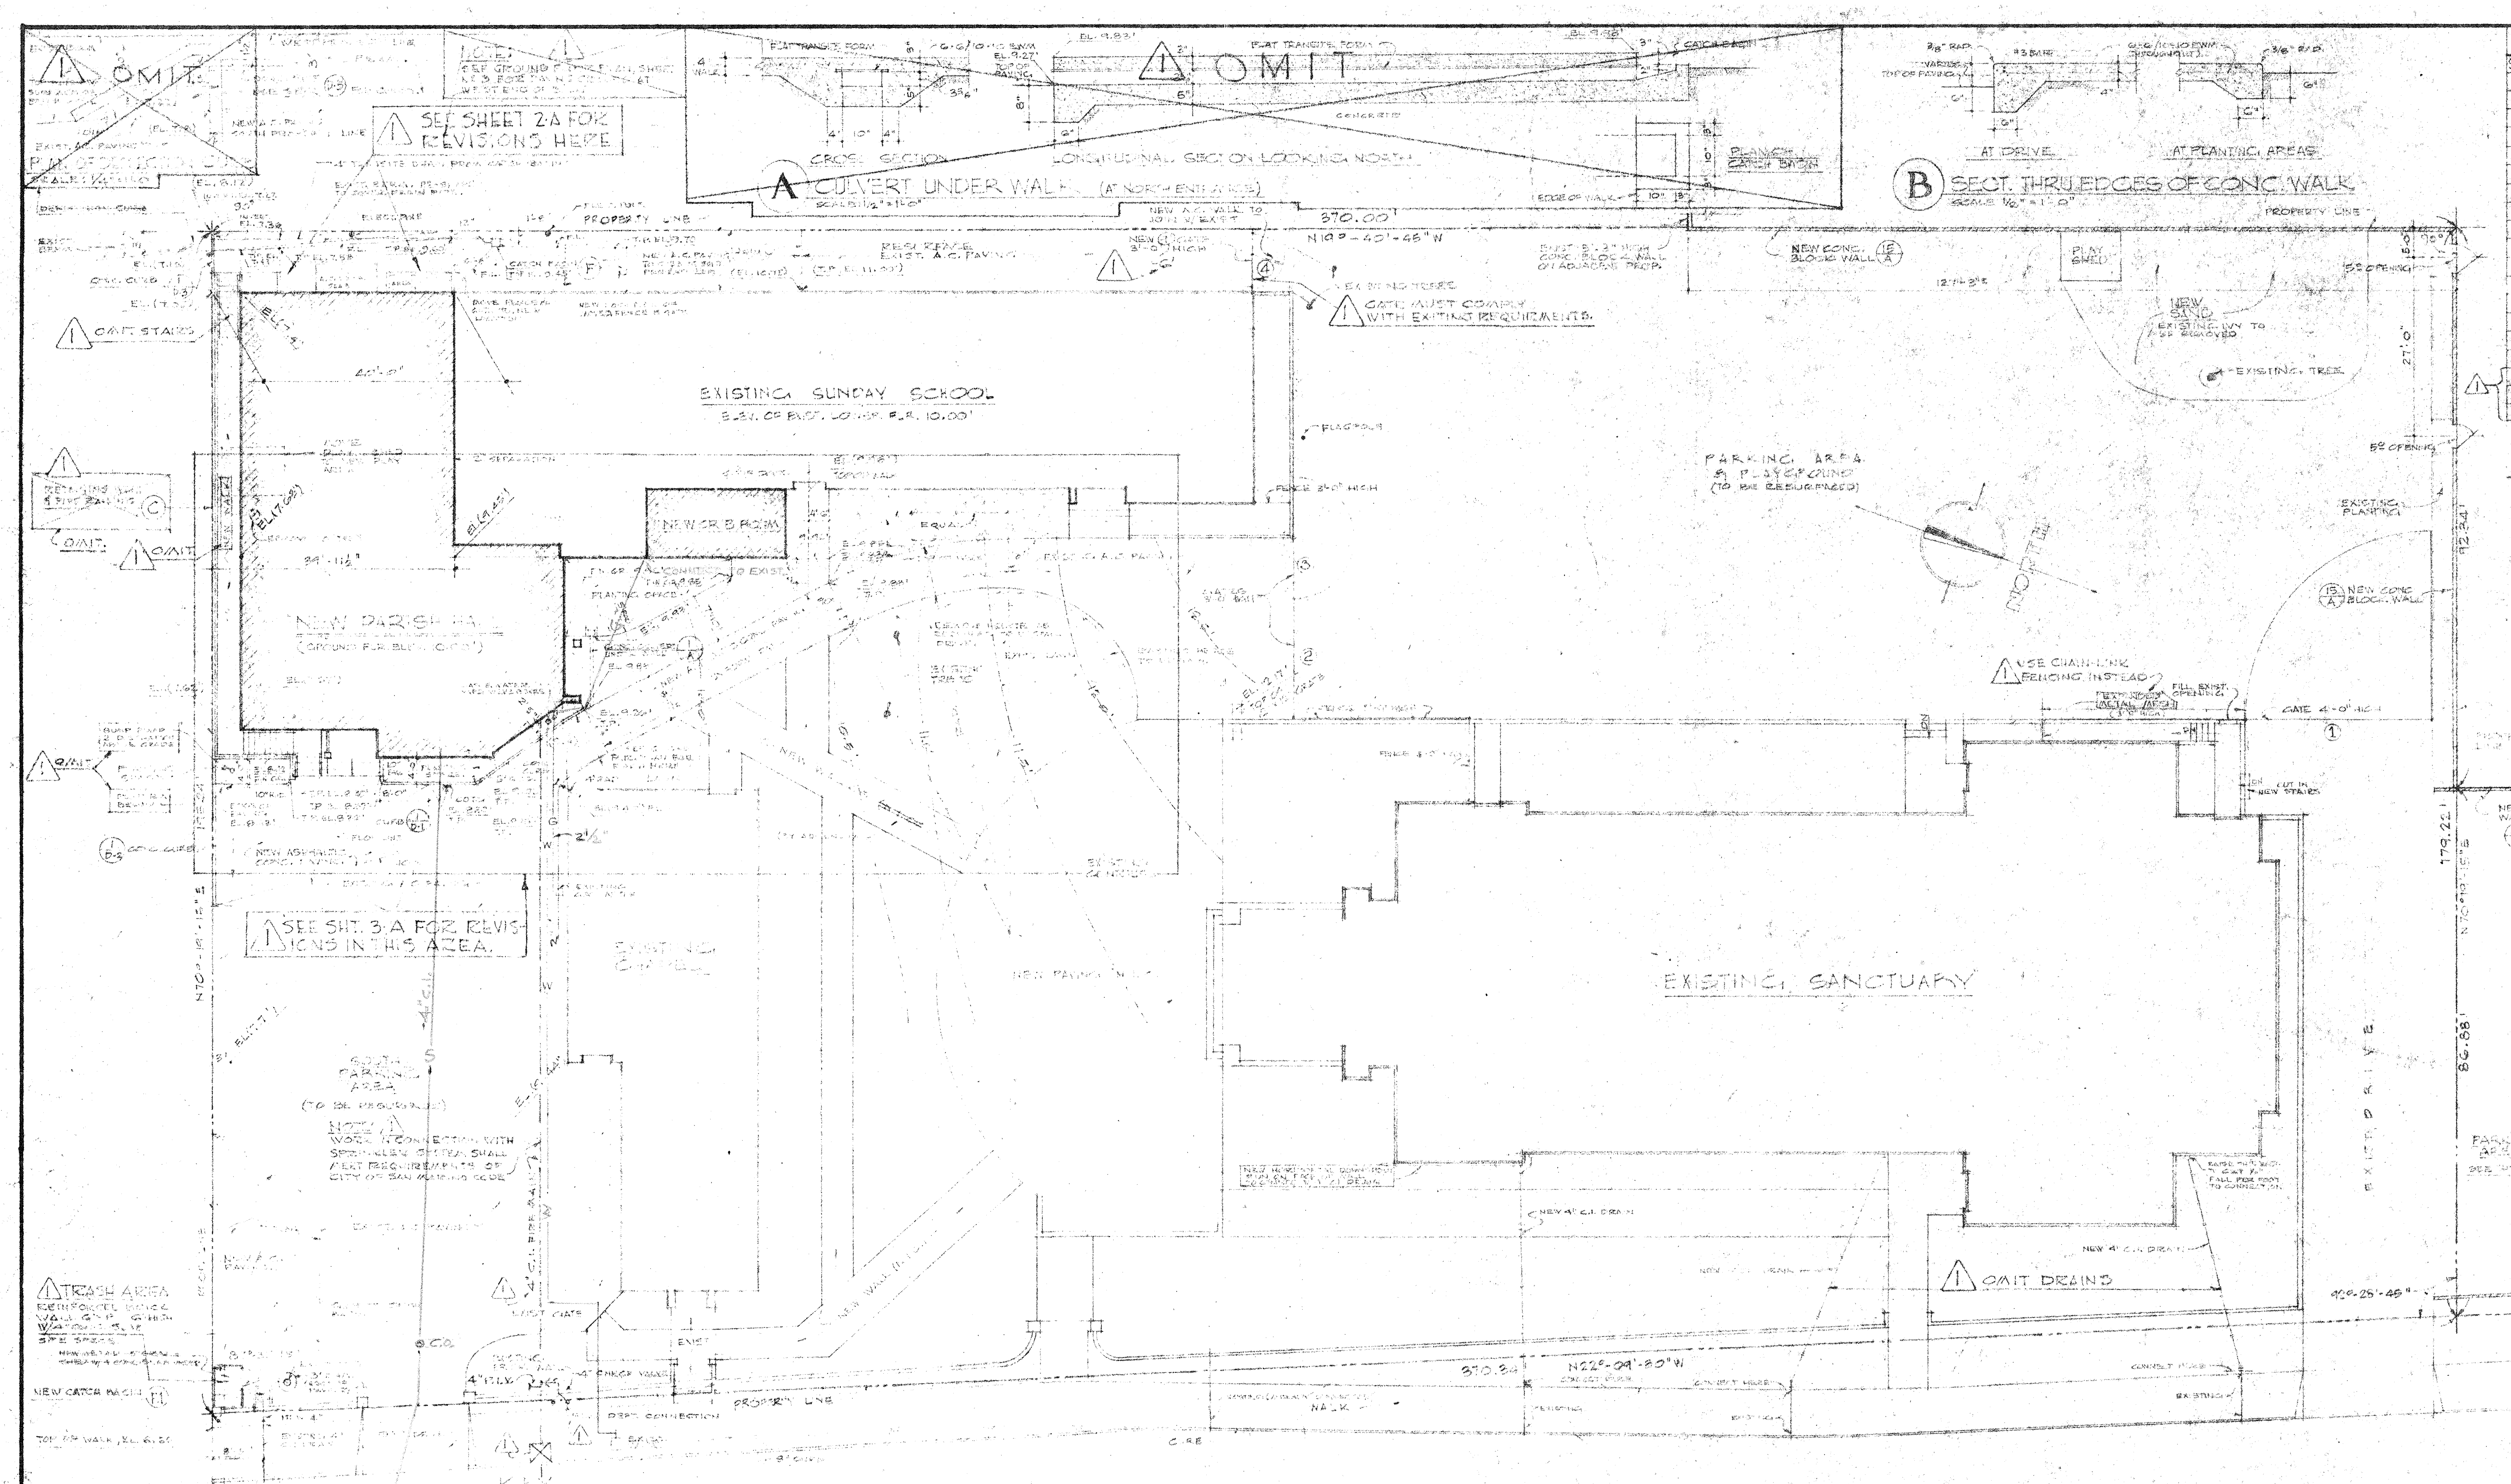

⚠1 OMIT
⚠1 SEE SHEET 2-A FOR REVISIONS HERE
CROSS SECTION
LONGITUDINAL SECTION LOOKING NORTH
Ⓐ CULVERT UNDER WALK (AT NORTH ENTRANCE)
SCALE: 1/2" = 1'-0"
AT DRIVE
AT PLANTING AREAS
Ⓑ SECT. THRU EDGES OF CONC. WALK
SCALE 1/2" = 1'-0"
PROPERTY LINE
370.00'
N19°-40'-45"W
NEW CONC. BLOCK WALL
PLAY SHED
NEW SAND
EXISTING IVY TO BE REMOVED
EXISTING TREE
⚠1 GATE MUST COMPLY WITH EXISTING REQUIREMENTS
⚠1 OMIT STAIRS
EXISTING SUNDAY SCHOOL
ELEV. OF EXIST. LOWER FLR. 10.00'
40'-0"
34'-11½"
NEW CR. B. ROOM
NEW PARISH HALL
(GROUND FLR. ELEV. 10.00')
FLAGPOLE
FENCE 3'-0" HIGH
PARKING AREA & PLAYGROUND (TO BE RESURFACED)
NORTH
⚠1 USE CHAIN-LINK FENCING INSTEAD
GATE 4'-0" HIGH
NEW BRICK WALL
5° OPENING
EXISTING PLANTING
27'-0"
92.34'
179.22'
86.88'
N70°-19'-15"E
EXIST. DRIVE
PARKING AREA SEE TITLE
⚠1 SEE SHT. 3-A FOR REVISIONS IN THIS AREA.
EXISTING CHAPEL
NEW PAVING
EXISTING SANCTUARY
SOUTH PARKING AREA (TO BE RESURFACED)
NOTE ⚠1 WORK IN CONNECTION WITH SPRINKLER SYSTEM SHALL MEET REQUIREMENTS OF CITY OF SAN MARINO CODE
⚠1 TRASH AREA
NEW CATCH BASIN F1
TOP OF WALK EL. 6.50
NEW 4" C.I. DRAIN
⚠1 OMIT DRAINS
370.34'
N22°-09'-80"W
WALK
CURB
90°-25'-45"

SAN GABRIEL BOULEVARD

KEY

T.P. = TOP OF PAVING   FL. = FLOW LINE   C.O. = CLEAN OUT TO GRADE

ELEVATIONS SHOWN IN PARENTHESES ( ) ARE FOR EXIST. CONDITIONS

CONTOURS ARE INDICATED ARE FOR EXISTING GRADE

FIN. GR. = FINISH GRADE

A.C. = ASPHALTIC CONCRETE

PLOT PLAN

SCALE: 1/16" = 1'-0"

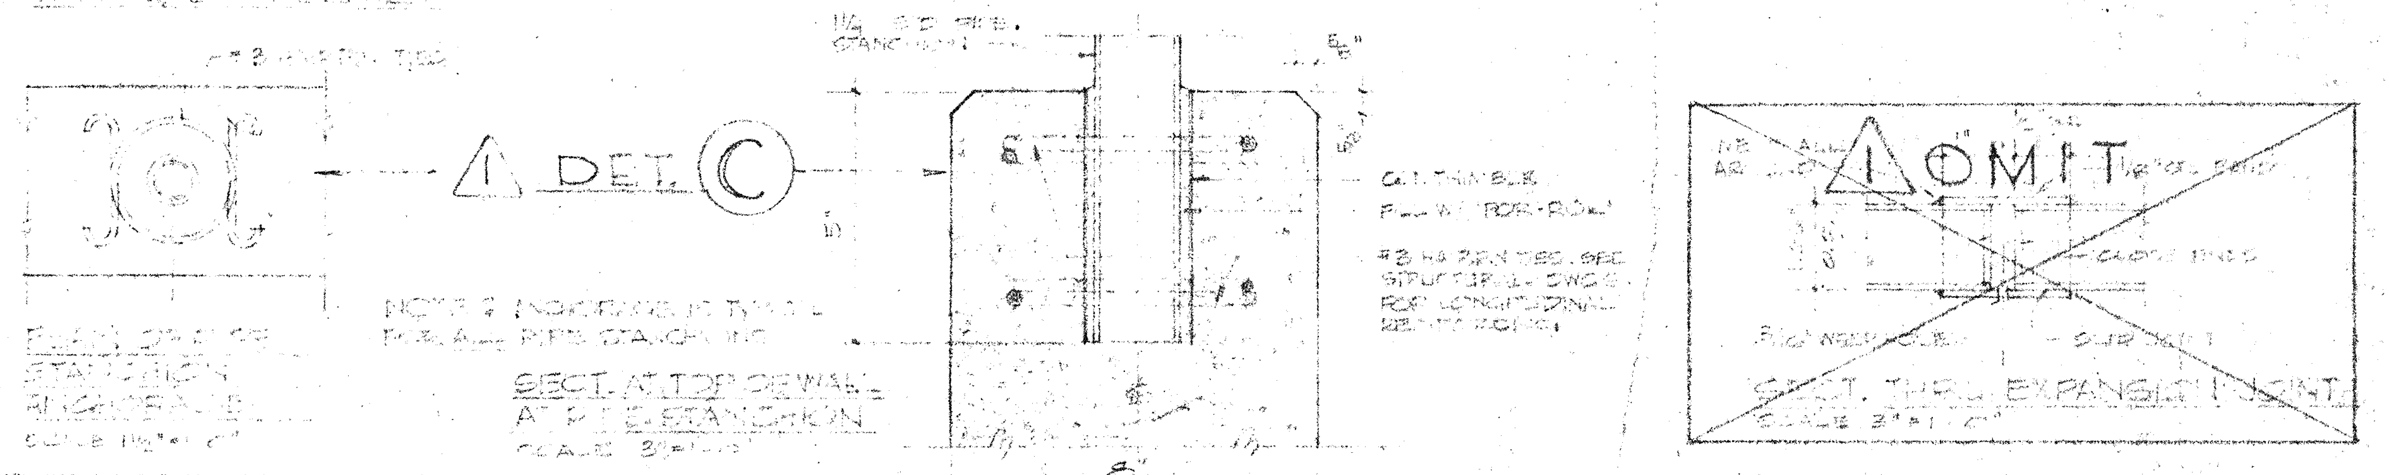

⚠1 DET. Ⓒ
PLAN OF PIPE STANCHION ANCHORAGE
SECT. AT TOP OF WALL AT PIPE STANCHION
SCALE 3" = 1'-0"
NOTE: 6" ANCHORAGE IS TYPICAL FOR ALL PIPE STANCHIONS
⚠1 OMIT
SECT. THRU EXPANSION JOINT
SCALE 3" = 1'-0"

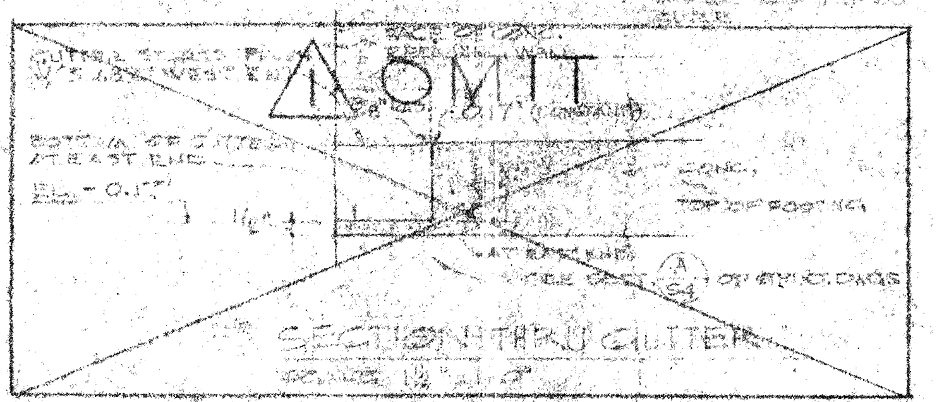

⚠1 OMIT
SECTION THRU GUTTER

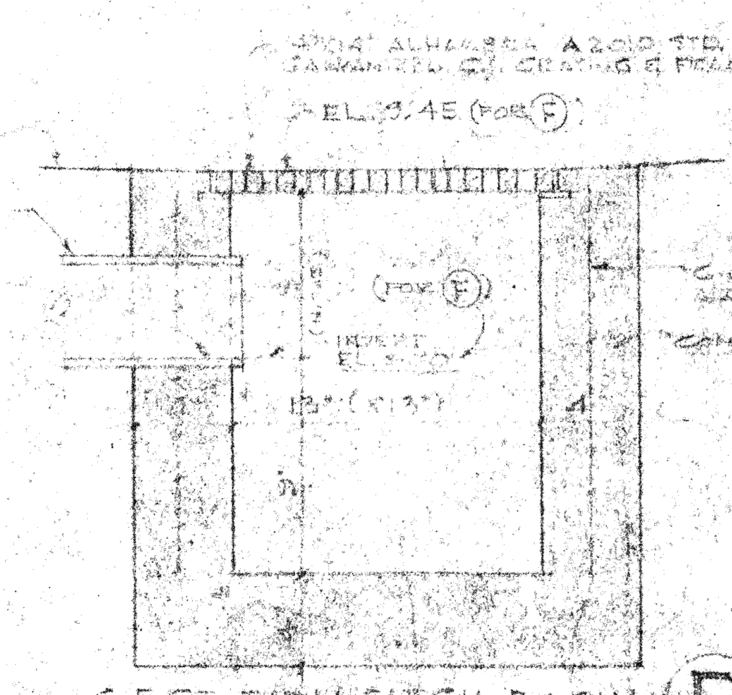

EL. 9.45 (FOR Ⓕ)
TOP OF PAVING
(FOR Ⓕ)
INVERT

SECT. THRU CATCH BASIN Ⓕ Ⓕ1

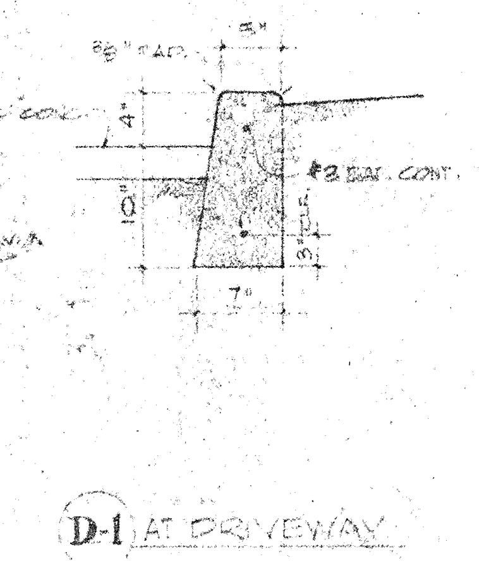

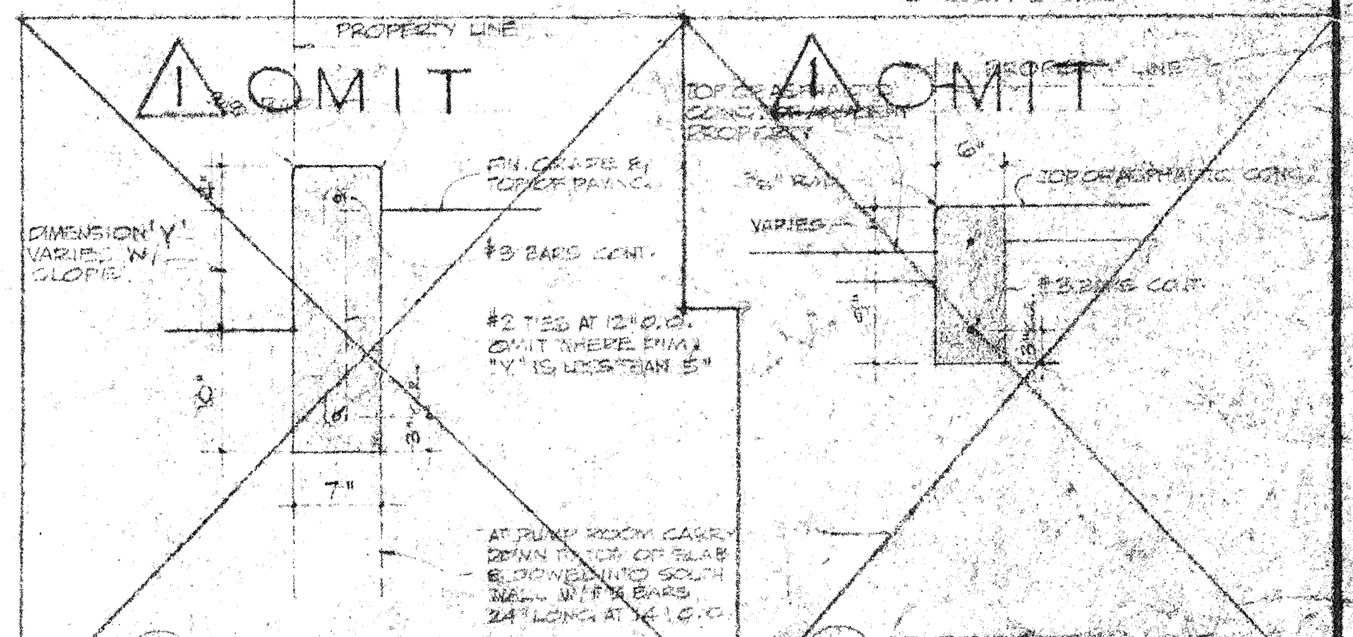

⚠1 OMIT
PROPERTY LINE
DIMENSION "Y" VARIES W/ SLOPE
#3 BARS CONT.
#2 TIES AT 12" O.C. OMIT WHERE DIM. "Y" IS LESS THAN 5"
7"
⚠1 OMIT
TOP OF ASPHALTIC CONC.
VARIES

D-1 AT DRIVEWAY

D2 AT PROPERTY LINE EAST OF BUILDING

D3 AT PROPERTY LINE REAR OF BUILDING

Ⓓ CONCRETE CURBS

SCALE 3/4" = 1'-0"

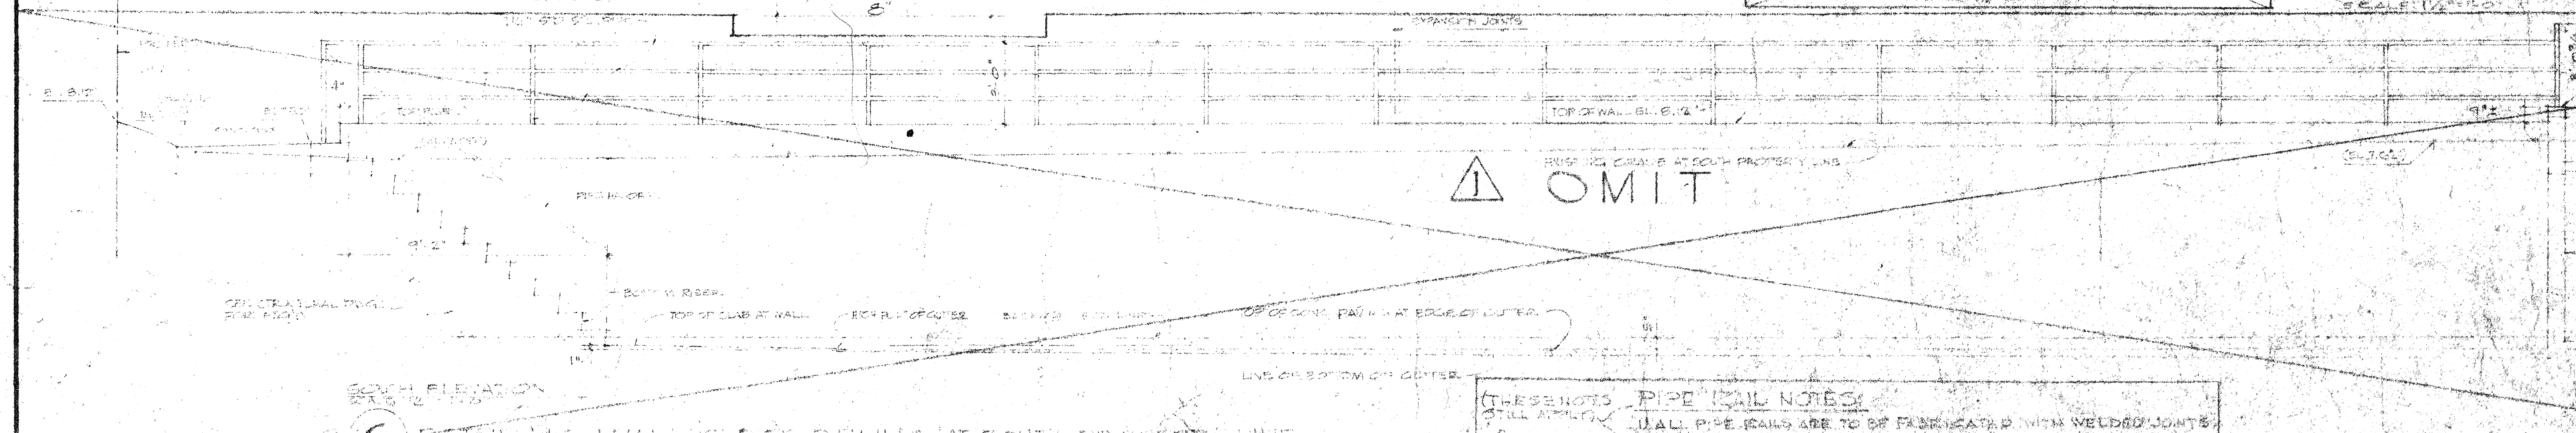

⚠1 OMIT
TOP OF WALL EL. 8.1/4
EXISTING GRADE AT SOUTH PROPERTY LINE
EXPANSION JOINTS
MAIN FLR. LINE 10.00'
EL. 8.85'
TOP OF CONC. PAVING AT EDGE OF GUTTER
LINE OF BOTTOM OF GUTTER
SOUTH ELEVATION

Ⓒ RETAINING WALL & PIPE RAILING AT SOUTH PROPERTY LINE

(THESE NOTES STILL APPLY) ⚠1

PIPE RAIL NOTES:

1) ALL PIPE RAILS ARE TO BE FABRICATED WITH WELDED JOINTS. GRIND ALL WELDING SMOOTH.

2) RAILINGS ARE NOT TO BE GALVANIZED AND ARE TO BE FURNISHED WITHOUT SHOP COAT. ALL PAINTING IS TO BE DONE BY PAINTING CONTRACTOR.

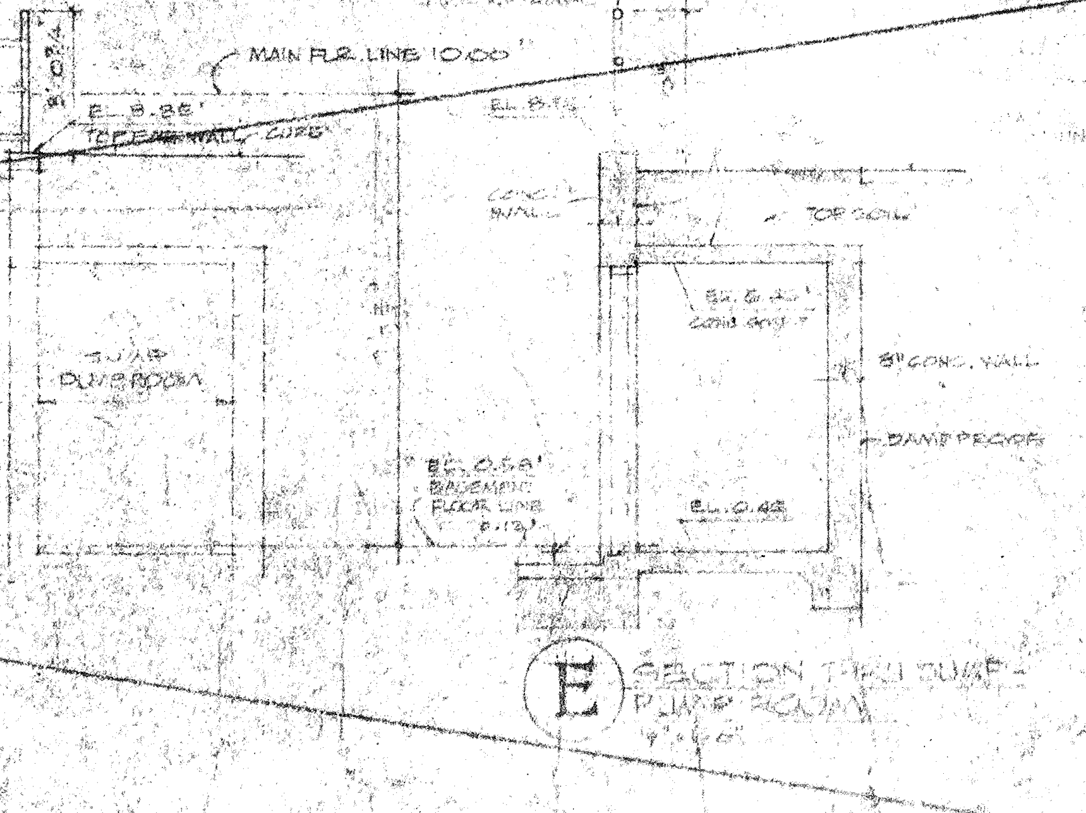

SUMP PUMP ROOM
8" CONC. WALL
DAMP PROOF
EL. 0.58' BASEMENT FLOOR LINE
EL. 0.48'

Ⓔ SECTION THRU SUMP PUMP ROOM

I N D E X

SHT. Nº	TITLE	SHT. Nº	TITLE
1	PLOT PLAN, INDEX, GENERAL NOTES & DETAILS	S-1	STRUCTURAL NOTES & TYP. DETAILS
2	BASEMENT PLAN & INTERIOR FINISH SCHEDULE	S-2	SECTIONS
3	GROUND FLOOR PLAN	S-2A	REVISIONS ⚠1
4	ROOF PLAN	S-3	MAIN ROOF & PLATFORM FRAMING
5	ELEVATIONS	S-3A	REVISIONS ⚠1
6	ELEVATION & LONGITUDINAL SECTION	S-4	STRUCTURAL SECTIONS
7	BUILDING SECTIONS	S-5	STRUCTURAL SECTIONS
8	DOOR SCHEDULE & DETAILS	S-6	STRUCTURAL SECTIONS
9	WINDOW SCHEDULE & DETAILS	S-7	STRUCTURAL SECTIONS
10	INTERIORS & KITCHEN PLANS		
11	BASEMENT SECTIONS & PLATFORM DETAILS	AC-1	FIRST FLOOR PLAN, SCHEDULE & DETAILS
12	CASE DETAILS & INSULATION SCHEDULE	AC-2	⚠1 THIS SHEET IS OMITTED. SHT. 2A REPLACES IT.
13	WALL SECTION & DETAILS	AC-3	CONTROL & PIPING DIAGRAMS
14	DETAILS		
15	PARKING AREA & ABBREVIATIONS	E-1	PARKING AREA & SCHEDULES
16	PARKING PLAN	E-2	GROUND FLOOR - UNREVISED PORTIONS
⚠1 2-A	REVISIONS	E-3	REVISED BASEMENT & PORTION OF GROUND FLR.
2-B	SPRINKLER LAYOUT		
3-A	REVISIONS		

GENERAL NOTES

1) FINISHED GROUND FLOOR IS TO LINE WITH THAT OF EXISTING ADJOINING BUILDING. ELEV. OF FLOOR IS 10.00'

2) BRICK SIZE IS TO BE COMMON, 2½" HIGH x 3⅞" WIDE x 8¼" LONG, MATCHING AS CLOSELY AS POSSIBLE THE COLOR & TEXTURE OF THE BRICK OF THE EXISTING ADJOINING CLASSROOM BUILDING. NOTE THAT EXTERIOR BRICK FOR CLOSING WINDOW OPENINGS IS TO BE THAT SALVAGED FROM BRICKWORK REMOVED.

3) THE COURSING OF THE CR. B. ROOM WALLS IS TO LINE W/ THAT OF THE ADJOINING WALLS OF THE EXIST. BUILDING. THE HEIGHT OF THE COURSES FOR ALL OTHER BRICKWORK IS TO BE 3" (½" JOINT.)

4) UNLESS OTHERWISE NOTED, ALL STUD WALLS ARE TO BE FRAMED W/ 2 x 4's AT 16" O.C.

5) DAMP PROOFING: EXCEPT AT THE OUTER WALLS OF THE CRAWL SPACE AT NORTH SIDE, DAMPPROOF THE EXTERIOR FACES, BELOW GRADE, OF ALL EXTERIOR WALLS RETAINING EARTH INCLUDING THE EXTERIOR FACE OF THE NORTH WALL OF TOILET ROOMS. ~~ALSO DAMPPROOF THE INTERIOR FACE OF THE BRICKWORK BEHIND THE PANELING AT THE WEST WALL OF THE PLATFORM.~~ ⚠1

6) THERMAL INSULATION:
   INSTALL THE THERMAL INSULATION SPECIFIED IN THE FOLLOWING LOCATIONS:
   - a. BETWEEN THE CEILING RAFTERS OF THE FURRED CEILING, AT THE WEST END OF THE PARISH HALL AND BETWEEN STUDS AT THE EAST SIDE OF ATTIC SPACE OVER PLATFORM.
   - b. BETWEEN THE CEILING RAFTERS OF THE FLAT ROOF PORTION, (EXCEPT OVER EXTER. PLATFORM AT EAST ENTRANCE)
   - c. BETWEEN JOISTS OF FURRED CEILING OVER CLOSET 104 AND STAIRWAY; ALSO BETWEEN STUDS AT NORTH WALL OF CLOSET 104 & AT END OF FURRING OVER STAIRWAY.
   - d. BETWEEN CEILING JOISTS & BETWEEN STUDS AT SIDES OF EACH PARISH HALL DORMER, ALSO ON TOP OF THE SHEATHING IN THE SPACES BETWEEN DORMER WINDOWS & AT THE END SPACES.
   - e. ON TOP OF THE SHEATHING UNDER THE BUILT-UP ROOF & SADDLE AT THE NORTH SIDE OF PARISH HALL.
   - f. BETWEEN CEILING JOISTS OVER CR. B. ROOM AND OVER NEW FURRED CEILING ABOVE EXIST. PORCH (13/K)

7) ALL GYP. BOARD CALLED FOR ON THE DRAWINGS IS TO BE A TYPE APPROVED FOR 1 HR. FIRE PROTECTION.

8) ALL CONC. WALKS ARE TO BE 4" THICK, REINFORCED W/ 6-6/10-10 E.W.M. THROUGHOUT.

9) MEASUREMENTS ON CONCRETE STEPS ARE TAKEN FROM THE FACE OF THE RISERS AT TOP. ⚠1

10) ALL EXPOSED CONCRETE IS TO BE FORMED W/ PLYWOOD OR W/ TEMPERED HARDBOARD FORM LINING.

⚠1 OMIT. 11) HARDWOOD: HARDWOOD & HARDWOOD PLYWOOD AT PLATFORM IN PARISH HALL SHALL BE IN SELECT RED BIRCH.

12) ROOM CAPACITY SIGN: A PERMANENT ROOM CAPACITY SIGN SHALL BE LOCATED IN A CONSPICUOUS PLACE NEAR MAIN EXIT OF THE PARISH HALL IN ACCORD W/ UNIFORM BUILDING CODE SECTION 3301

⚠1 13) LAY ONE LAYER OF BUILDING PAPER ~~UNDER ALL MAPLE FLOORING~~ BETWEEN LAYERS OF PLYWOOD FOR FLOOR

14) WHERE EXISTING PAVING IS REMOVED FOR PIPE TRENCHES, REPLACE IT WITH NEW ASPHALTIC CONCRETE.

15) REMOVE EXISTING PAVING IN AREAS TO BE COVERED BY NEW WALKS OR PAVING.

16) STUDS ARE TO BE 2x4 @ 16" O.C. EXCEPT WHERE NOTED OTHERWISE.

17) ALL LATHING, PLASTERING, AND ALL SUSPENDED CEILINGS OF METAL LATH & CHANNELS ARE TO CONFORM TO CHAPTER 47 OF THE UNIFORM BUILDING CODE, ALL TO GIVE ONE-HOUR FIRE PROTECTION, ⚠1 EXCEPT IN PORTION OF STORAGE ROOM 103A AND HALL 100, WEST OF THE 2" SEPARATION WHERE 1" NEAT WOOD FIBRE PLASTER ON METAL LATH IS CALLED FOR.

DETAIL SYMBOL EXPLANATION

- SHEET NUMBER REFERENCE / DETAIL LETTER REFERENCE
- DETAIL LETTER ONLY WHERE DETAIL & REFERENCE ARE ON SAME SHEET.
- WINDOW NUMBER
- DOOR NUMBER

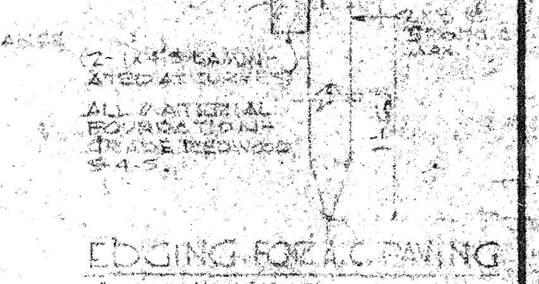

TOP OF PAVING
2x4
20d NAILS
(2- 1x4's BATTEN) AT CURVES
ALL MATERIAL FOUNDATION GRADE REDWOOD

EDGING FOR A.C. PAVING

⚠1 FIRE ZONE #1
B-2 + C OCCUPANCY
TYPE III, ONE-HOUR CONSTRUCTION REQUIRED

LEGAL DESCRIPTION:

TRACT Nº 8835 LOT COM. S. 22°[illegible]30" E. 145.77 FT. FROM S.E. TERMINUS OF A CURVE CONCAVE TO SW AT INTERSECTION OF S.E. LINE OF GAINSBOROUGH DR. W/ S.W. LINE OF SAN GABRIEL BLVD. WITH A RADIUS OF 15 FT. AND A LENGTH OF 22.91 FT. TH S.E. ON SD S.W. LINE 370.34 FT. TH S. 70°19'15" W 195.24 FT. TH N 19°40'45" W 370 FT. TH NORTH 70°19'15" E 179.22 FT. TO BEG. PART OF LOT B

AS BUILT DRAWING BY DIMIT (PLUMBER) 2-27-67

PLOT PLAN, INDEX & GENERAL NOTES

REVISIONS	
⚠1 3-31-66	PARISH HALL ADDITION FOR ST. EDMUND'S EPISCOPAL CHURCH 1175 SAN GABRIEL BLVD., SAN MARINO, CALIFORNIA
DRAWN BY B.F.	BREO FREEMAN ARCHITECT 45 SOUTH MARENGO PASADENA 1, CALIFORNIA
TRACED BY C.E.C.	JOB NO. 927
DATE 12-30-65	SHEET NO. 1