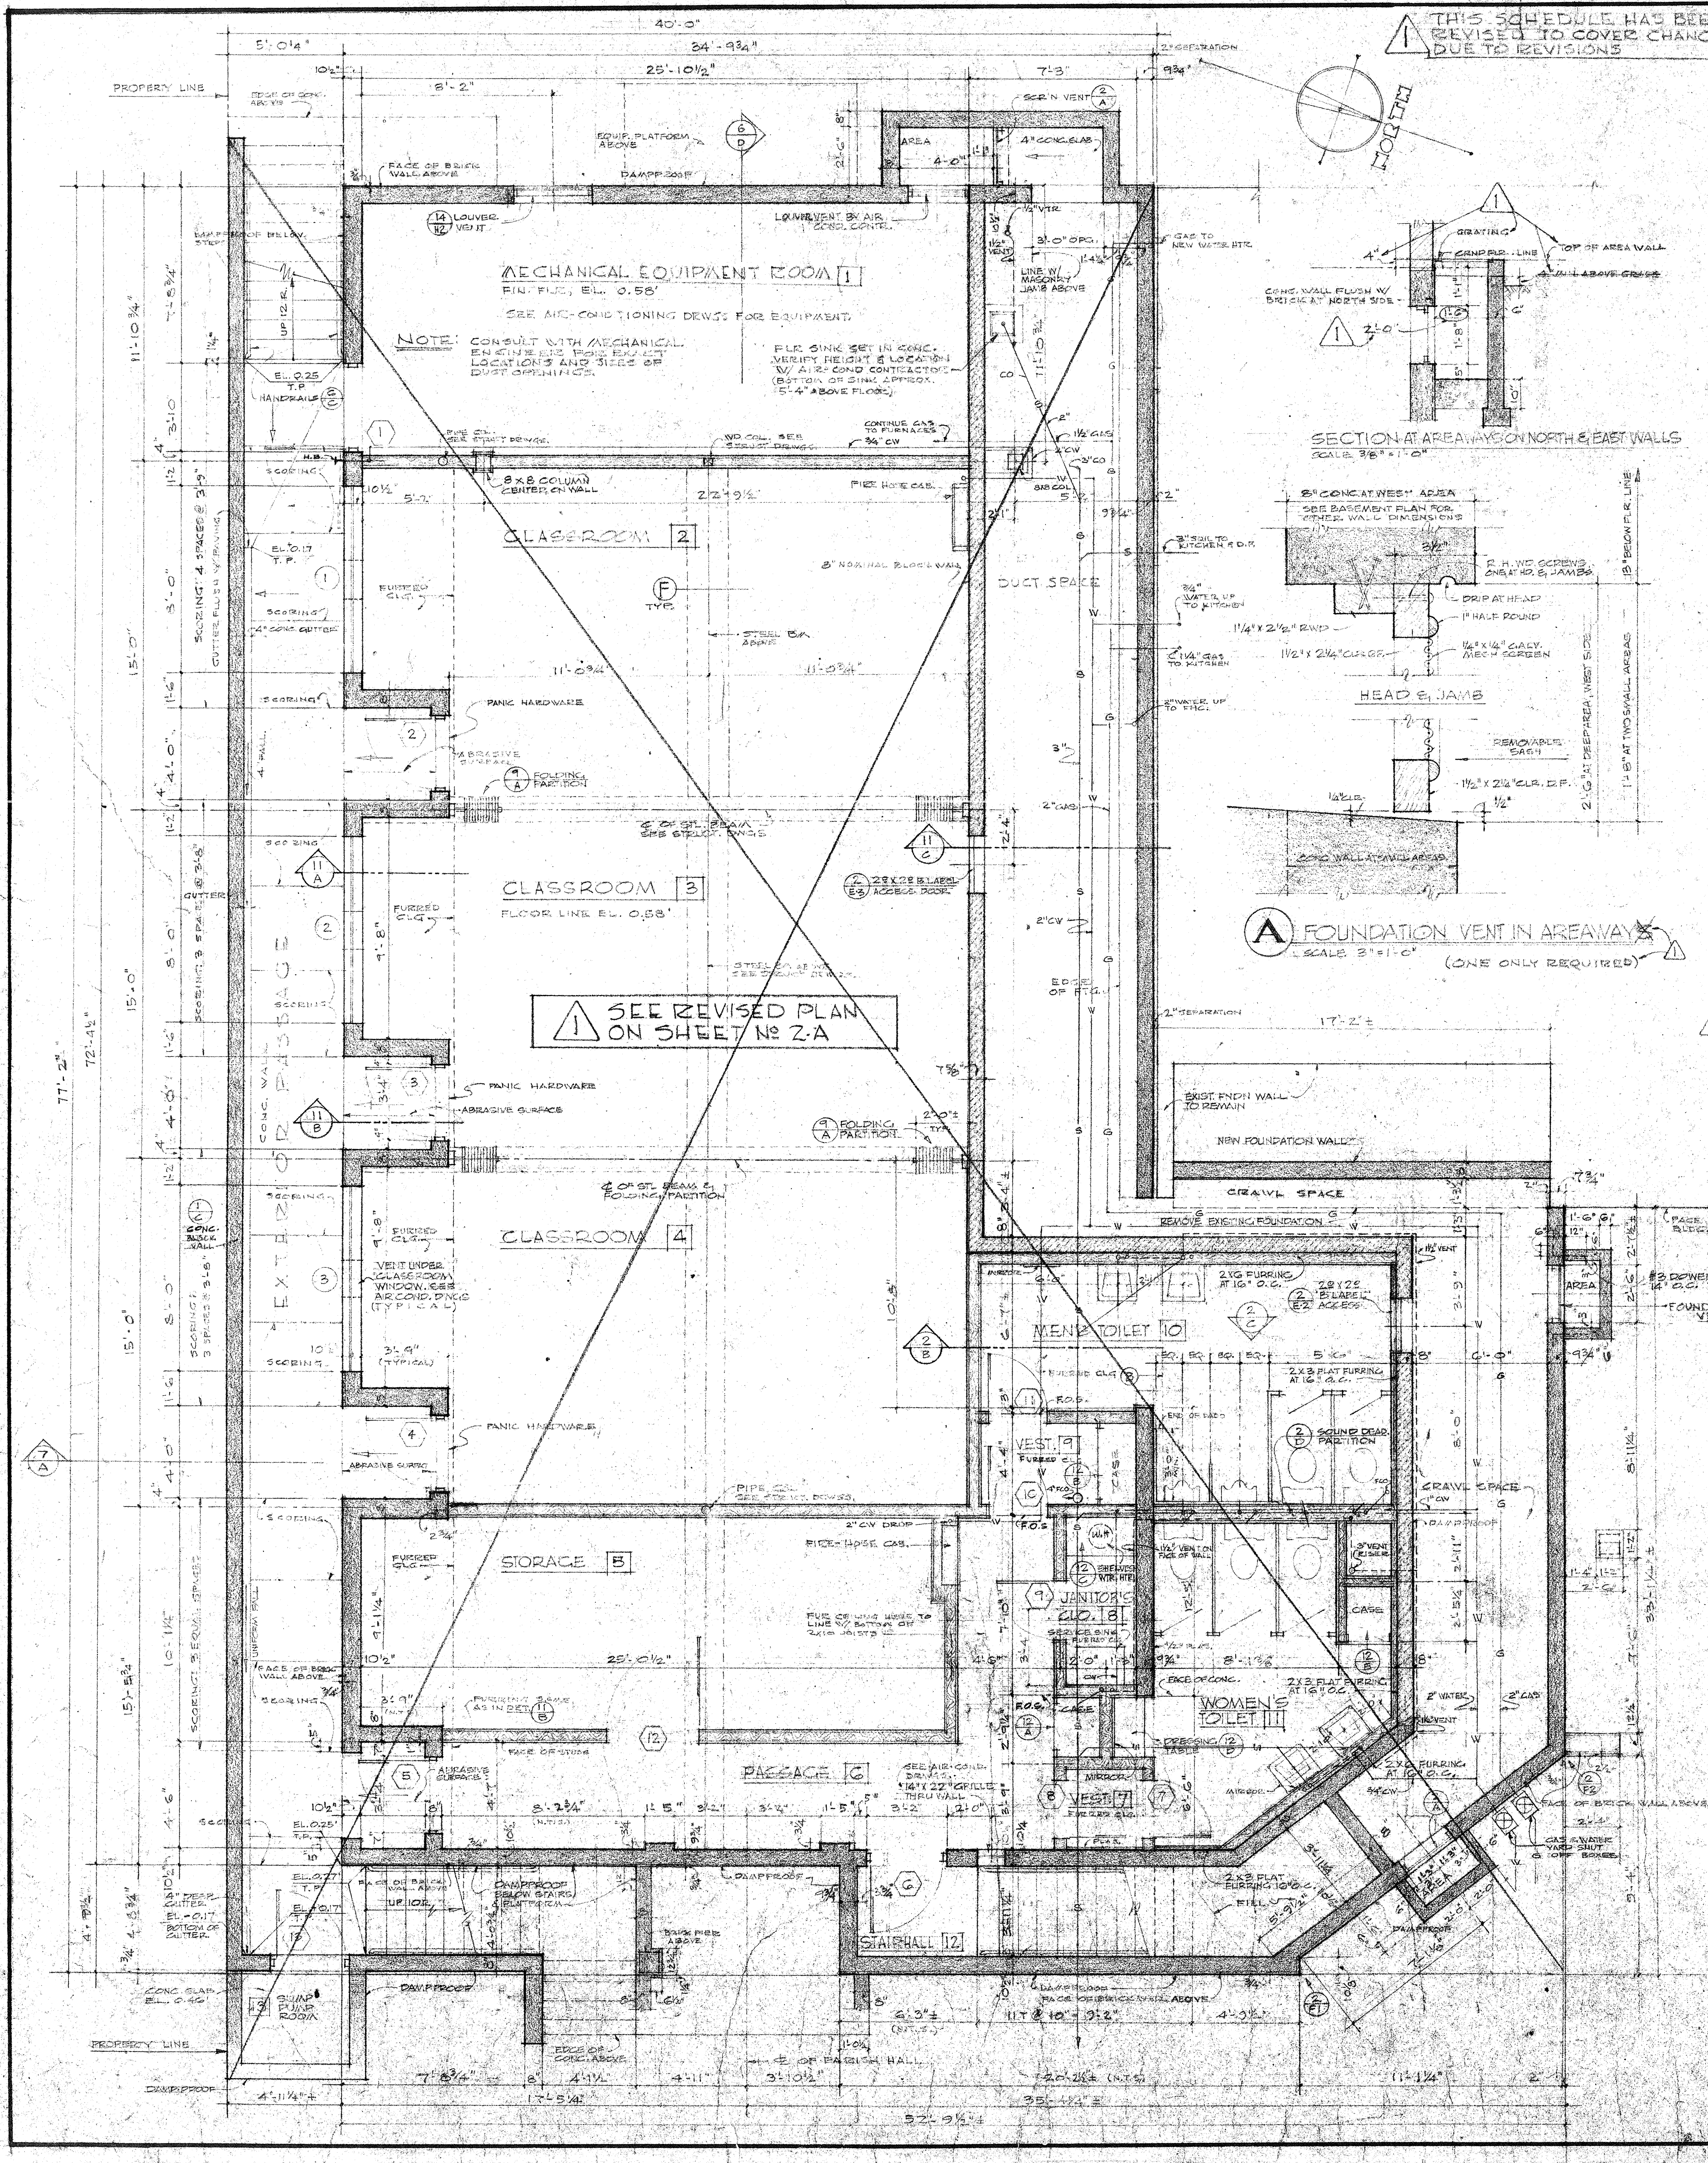

1 THIS SCHEDULE HAS BEEN REVISED TO COVER CHANGES DUE TO REVISIONS
NORTH
PROPERTY LINE
MECHANICAL EQUIPMENT ROOM 1
FIN. FLR. EL. 0.58'
SEE AIR-CONDITIONING DRWGS. FOR EQUIPMENT.
NOTE: CONSULT WITH MECHANICAL ENGINEER FOR EXACT LOCATIONS AND SIZES OF DUCT OPENINGS.
CLASSROOM 2
CLASSROOM 3
FLOOR LINE EL. 0.58'
CLASSROOM 4
STORAGE 5
PASSAGE 6
MEN'S TOILET 10
WOMEN'S TOILET 11
JANITOR'S CLO. 8
VEST. 7
VEST. 9
STAIRHALL 12
SUMP PUMP ROOM
CRAWL SPACE
DUCT SPACE
EXTERIOR PASSAGE
1 SEE REVISED PLAN ON SHEET No 2-A
SECTION AT AREAWAYS ON NORTH & EAST WALLS
SCALE 3/8"=1'-0"
HEAD & JAMB
A FOUNDATION VENT IN AREAWAY
SCALE 3"=1'-0"
(ONE ONLY REQUIRED)

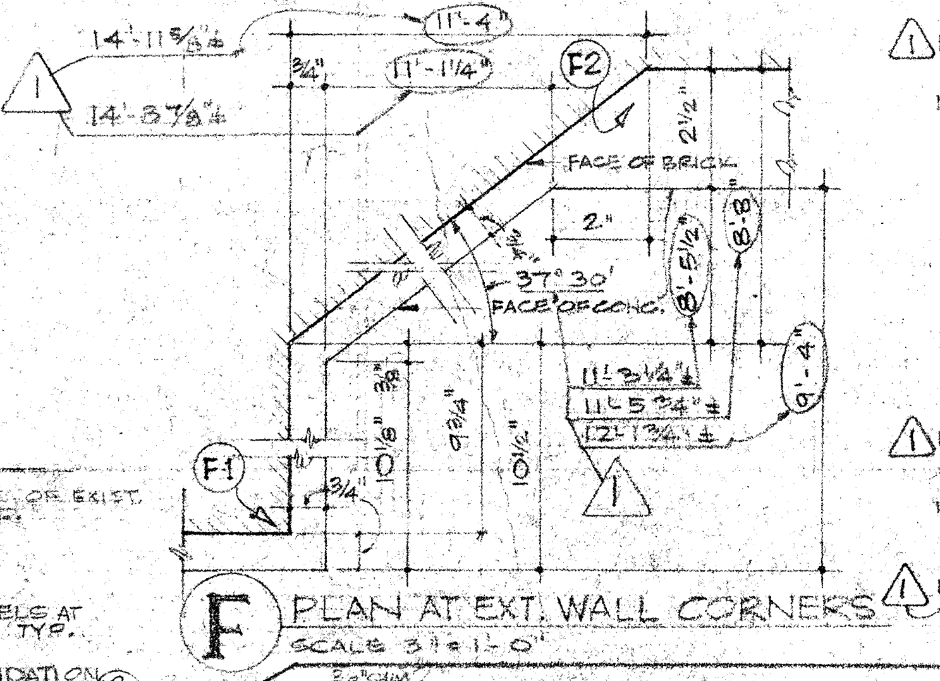

F PLAN AT EXT. WALL CORNERS 1
SCALE 3"=1'-0"

INTERIOR FINISH SCHEDULE

ROOM LOC.	ROOM NUMBER	NAME OF ROOM	CEILING MATERIAL	CEILING FINISH	WALLS MATERIAL	WALLS FINISH	FLOOR	BASE	REMARKS
GROUND FLOOR	101	PLATFORM	PLAS. & WOOD STRIPS	F.W.P.	EXPOSED BRICK & PLAS.	F.W.P.	V.A.T.	4" VINYL	WITH THE EXCEPTION OF THE MAPLE NOSING AT FRONT EDGE OF PLATFORM, ALL HARDWOOD IS OMITTED.
	102	PARISH HALL	D.F.	SEE SPECS.	BRICK	F.W.P.			SEE SPECS FOR FINISH OF LAMINATED ARCHES, CEILING, & PURLINS NO BASE AT BASEBOARD DIFFUSERS.
	103 & 103-A	STORAGE	● PLAS.	F.W.P.	● BRICK & PLAS.				● 1" NEAT WOOD-FIBER PLAS. ON MET. LATH ON CLG. & FRAME WALL WEST OF 2" SEPARATION JOINT, IN STORAGE 103-A. (PLAS. ON STUD WALLS ONLY)
	104	CLOSET			BRICK & PLAS.				SHELVING: 2 COATS OF SHELLAC.
	105	FOYER							
	106 & 106-A	HALL	●		●				COAT CASE: DOORS, S&L; DOOR FRAME & SHELF, E.E.; WALLS & CLG., F.W.P. ● SAME NOTE AS FOR STORAGE 103-A ABOVE. APPLIES TO HALL 106-A
	107	CRIB ROOM			BRICK		V.A.T.	4" VINYL	
	E 108	STAIRHALL	EXIST. PLAS	NONE	EXIST. & NEW ● PLAS.	■	▲ EXIST. RESILIENT TILE	EXIST. WOOD	● NEW PLAS. AT BRICKED-UP WINDOWS. ■ EAST & SOUTH WALLS ONLY. SEE ELEV. 10/B. ▲ STRIP OF NEW RESILIENT TILE AT DOOR 108 (SHT. 3-A)
	E 109	KITCHEN	NEW & EXIST. PLAS.	E.E.		E.E.	V.A.T.	4" VINYL	ALL CASEWORK IN E.E. FINISH. NEW PLAS TO MATCH EXISTING.
	E 110	EXISTING CLASSROOMS							SEE NOTE #10 BELOW.
BASEMENT	1	MECHANICAL EQUIP. ROOM	CEM. PLAS.	NONE	CONC. & CEM. PLAS. ●	NONE	CONC.	MTL. CASING BD. AT PLAS. WALLS	MTL. LATH FOR CEM. PLAS. ● CEM. PLAS. ON STUDS ONLY.
	2	CLASSROOM	✳ PLAS.	F.W.P.	CONC. & PLAS. ●	F.W.P.		2 1/2" VINYL	● PLAS. AT WD. STUDS ONLY ✳ ACOUSTICAL PLAS. IN PANELS IMMEDIATELY BELOW FLR JOISTS ONLY; TYP. PLAS AT FURRING
	3	CLASSROOM	✳		●				SAME REMARKS AS FOR RM #2
	4	CLASSROOM	✳		●				
	5	ROOM	✳		●				
	6	PASSAGE	■ PLAS. ON MET. LATH.		CONC., CONC. BLOCK & PLAS. ●				■ FUR CLG. TO 7'-7 1/2" RO. W/ 3/4" [s & 1 1/2" RUNNERS - SEE SECT. 4A/D ● PLAS. AT STUD WALLS ONLY.
	7	VESTIBULE			PLAS.				FUR CEILING TO 7'-5" RO. W/ 3/4" MTL [s @ 16" o.c.; 3/4" PLAS. ON MET. LATH
	8	JANITOR'S CLOSET	K.C. PLAS	E.E.	CONC. & K.C. PLAS. ●	E.E.			CLG. SAME AS FOR VESTIBULE 7. ● PLAS. AT STUD WALLS ONLY.
	9	VESTIBULE	PLAS.	F.W.P.	PLAS.	F.W.P.			CASE IN E.E. FUR CEILING TO 7'-5" RO. W/ 3/4" [s 16" o.c. + 3/4" PLAS. ON MET. LATH
	10	MEN'S TOILET	K.C. PLAS.	E.E.	K.C. PLAS.	E.E.	CER. TILE	CER. TILE	CER. TILE DADO AT URINALS.
	11	WOMEN'S TOILET	●						● FUR AROUND DUCT W/ MET. LATH & [s.
	12	STAIRHALL	PLAS.	F.W.P.	● CONC. & PLAS.	F.W.P.	CONC.	4" RUBBER	1/8" SHEET RUBBER BASE AT STAIRS W/ "TRIMEDGE" A-604-H AT TOP & ENDS. ● PLAS. AT STUD WALLS ONLY.
	13	STORAGE		NONE	CONC., CONC. BLOCK & PLAS ●	NONE		MET. CASING BD AT PLAS. WALLS	● PLAS. AT STUD WALLS ONLY. FUR CLG BET. CONC. WALL & CORRIDOR WALL TO 7'-5" RO. W/ MET. LATH & CHANNELS

ABBREVIATIONS

CEM.	CEMENT
CER	CERAMIC
CONC.	CONCRETE
D.F.	DOUGLAS FIR
E.E.	EGGSHELL ENAMEL
F.W.P.	FLAT WALL PAINT
HDWD	HARDWOOD
K.C.	KEENE'S CEMENT
PLAS.	PLASTER
S&L	STAIN & LACQUER
V.A.T.	VINYL ASBESTOS TILE
T.&G.	TONGUE & GROOVE

"E" BEFORE THE ROOM NUMBER SIGNIFIES THAT THE ROOM IS IN THE EXISTING BLDG.

NOTES

1-ALL DOOR FRAMES ARE TO BE FINISHED IN E.E.

2-ALL EXTERIOR WOOD DOORS ARE TO BE FINISHED IN E.E.

3-ALL INTERIOR HDWD DOORS ARE TO RECEIVE S.&L. FINISH. SUBMIT SAMPLES.

1 4-~~SEE SPECIFICATIONS FOR FINISH OF MAPLE FLOORS~~

5-ALL WOODWORK NOTED AS "HDWD" IS TO BE IN SELECT RED BIRCH.

6-ALL INTERIOR PAINT SHALL BE THOROUGHLY WASHABLE

7-FOR RESILIENT TILE FLOORS LAID ON CONC. SLAB ON GRADE SPECIAL PRECAUTION SHALL BE OBSERVED TO USE THE MASTIC RECOMMENDED BY THE MANUFACTURER OF THIS MATERIAL FOR USE FOR THIS CONDITION.

8-WHEREVER PLASTERED SURFACES INTERSECT BRICK, CONC., OR CONC. BLOCK, A MET. CASING BEAD SHALL BE USED.

9-A SCHEDULE LISTING COLORS FOR ALL PAINTED WORK WILL BE FURNISHED BY THE ARCHITECT. SUBMIT SAMPLES OF ALL COLORS AND FINISHES

10-IN EXISTING CLASSROOMS E-110 PLASTER WALL AT DOORWAY TO BE CLOSED AND AS NECESSARY AT NEW PASS PORT AND AT DOOR 101. PAINT SOUTH WALL AND THE PORTION OF WALL IMMEDIATELY AROUND DOOR 101 & THE TWO WINDOWS UP TO SPLAY WITH FLAT WALL PAINT.

1 11-IN ROOM~~S E108 &~~ E109 THOROUGHLY REMOVE ALL EXISTING RESILIENT TILE AND MASTIC, LEAVING A SMOOTH, CLEAN SURFACE TO RECEIVE NEW RESILIENT TILE

12-NOTE "B" REGARDING PAINTING IN STAIRHALL E108:
- a. ~~FINISH NEW WORK ON STAIRS TO MATCH EXISTING RISERS & TREADS~~
- b. CARRY PAINTING ON SOUTH WALL (~~INCLUDING WOOD BASE~~) UP THE STAIRS TO THE CORNER AT THE TOP LANDING. SEE SECTION TAKEN AT STAIRS ON SHEET No 10.
- c. ~~PAINT SOUTH SIDE OF PLASTER RAILING (INCLUDING WOOD BASE) AT NORTH SIDE OF STAIRS.~~ PAINT EAST WALL. 1
- d. ~~PAINT CEILING IN COLOR TO MATCH EXISTING. CARRY THIS PAINTING UP TO THE CORNERS AT STAIR WELL.~~

13-FURNISH AND INSTALL MINTON'S 1" "DON EXECUTIVE" WHITE, SMOOTH-BACK PLASTER LETTERS ON DOORS 8 AND 10. LETTERING ON DOOR 8 IS TO READ "WOMEN"; THAT ON DOOR 10 IS TO READ "MEN". BOTTOM OF LETTERS IS TO BE 5'-5" ABOVE FLOOR. WORDS ARE TO CENTER ON DOORS. (LETTERS AVAILABLE AT HARRISON'S DISPLAY MATERIALS, PASADENA, PHONE 793-2838)

1 14-IN ROOM~~S E108~~ & E-109 REMOVE EXISTING RESILIENT FLOOR TILE AND CLEAN FLOOR SLAB THOROUGHLY TO PRESENT A SMOOTH SURFACE FOR INSTALLATION OF NEW FLOOR TILE.

15-PLASTER FURRING AROUND DUCT IN 2ND FLR. CLASSROOM (DET. 14/K) AND AROUND NEW CEILING ACCESS DOOR IN 2ND FLR. CORRIDOR. PAINT A BORDER AROUND THE LATTER, OF SAME WIDTH ALL AROUND, SUFFICIENT TO COVER NEW PLASTER, AND PAINT PLASTER AT DUCT, ALL WITH FLAT WALL PAINT.

1 16. EXCEPT FOR WOOD FIBER PLAS. AS NOTED FOR A PORTION OF STORAGE 103-A & HALL 106-A, ALL INTERIOR PARTITIONS SHALL BE A MINIMUM OF ONE (1) HOUR FIRE-RESISTIVE CONSTRUCTION.

KEY TO MATERIALS

▨	NEW BRICK WALL IN SECTION
▒	NEW CONC. WALL IN SECTION
▩	NEW CONC. BLOCK WALL IN SECTION
▤	NEW FRAME WALL IN SECTION
═	EXISTING WALL

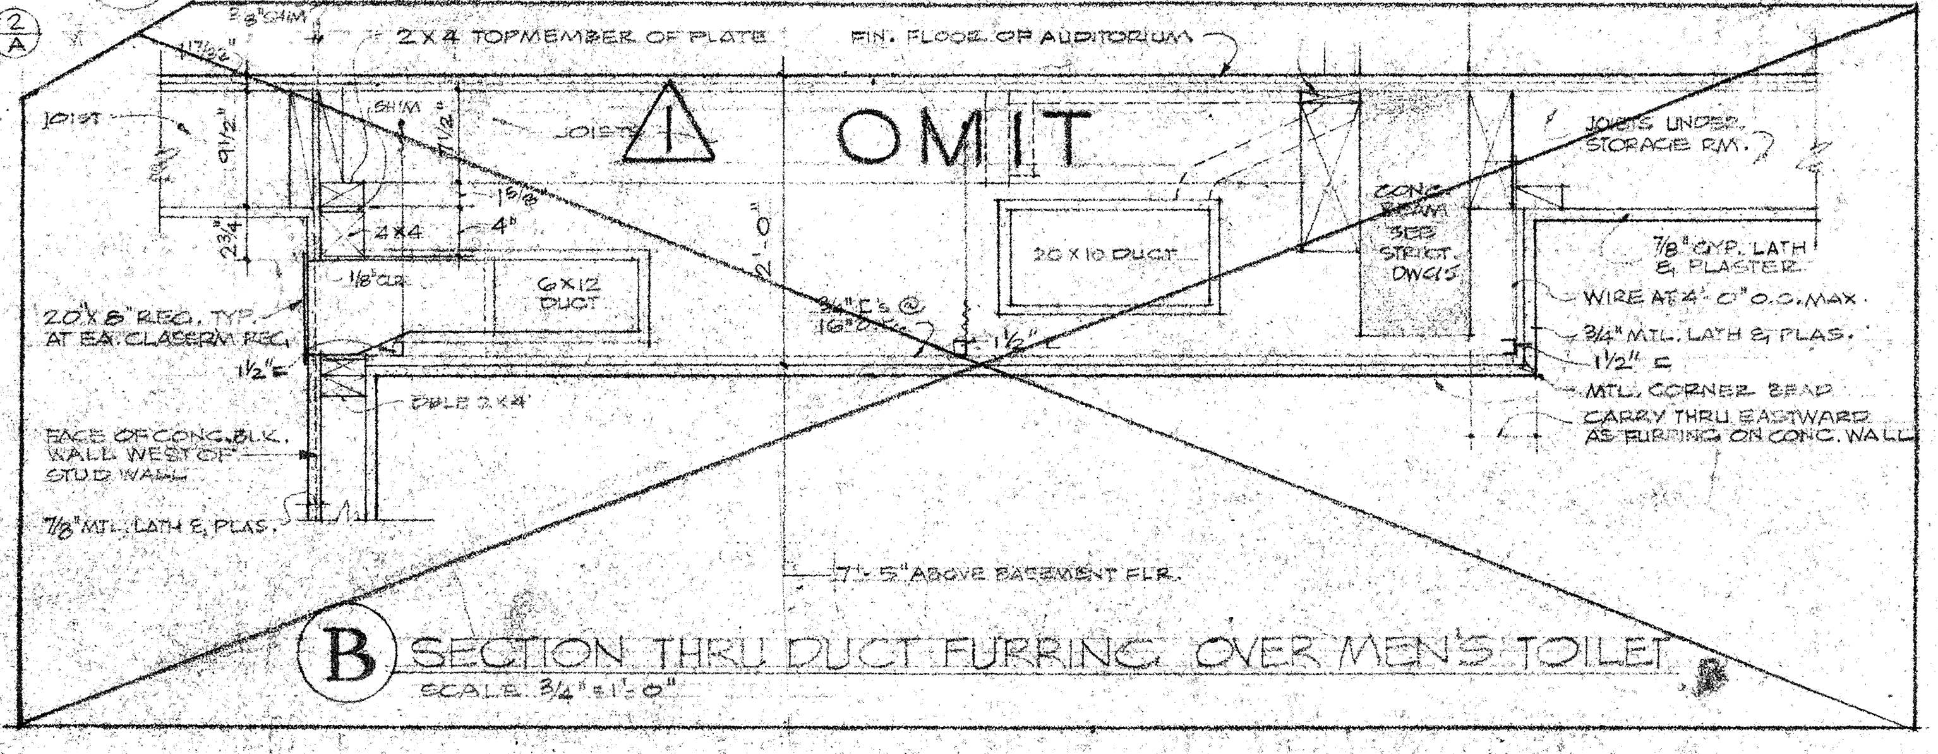

B SECTION THRU DUCT FURRING OVER MEN'S TOILET
SCALE 3/4"=1'-0"

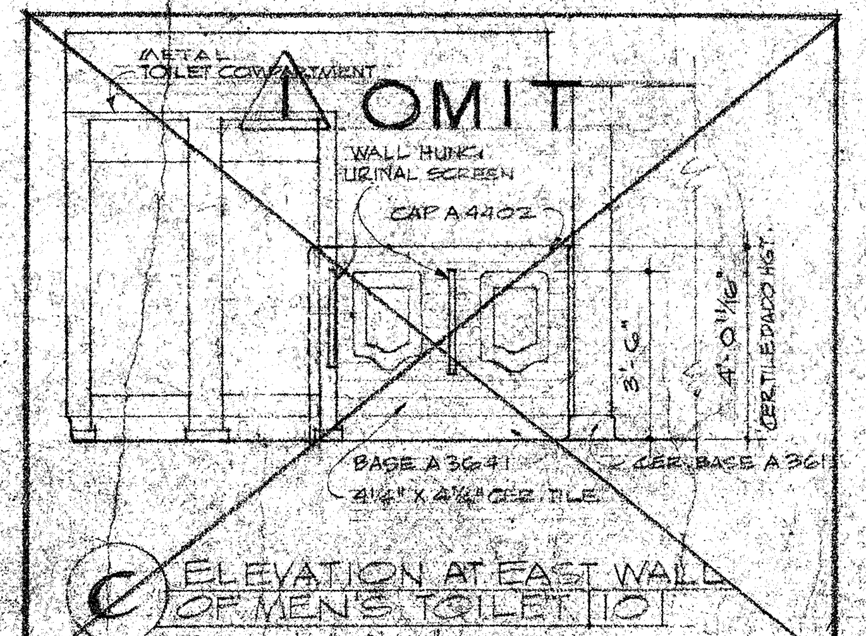

C ELEVATION AT EAST WALL OF MEN'S TOILET 10
SCALE 1/2"=1'-0"

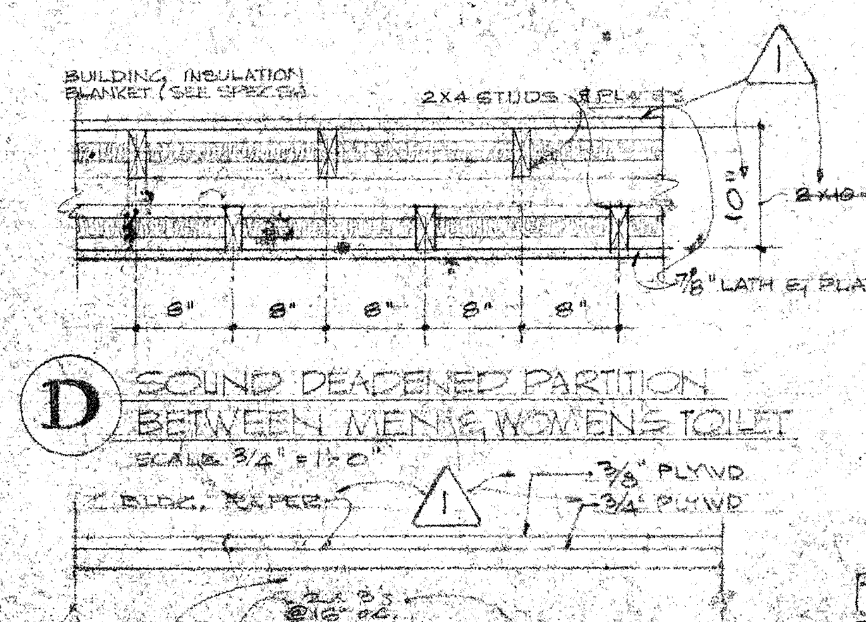

D SOUND DEADENED PARTITION BETWEEN MEN'S & WOMEN'S TOILET
SCALE 3/4"=1'-0"

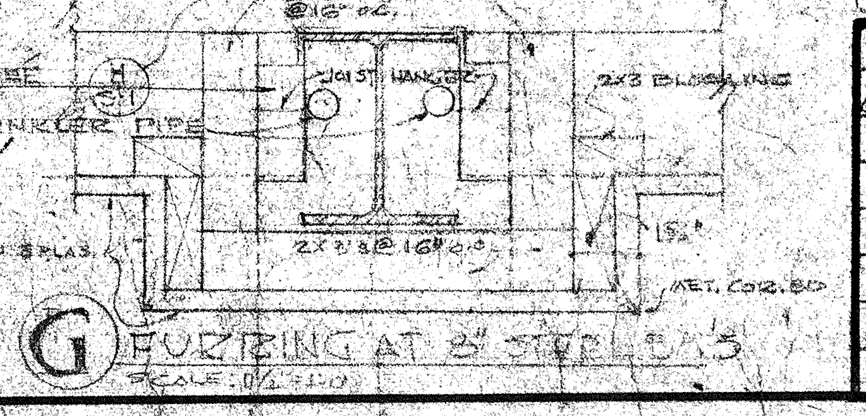

G FURRING AT 3" STEEL COLS.

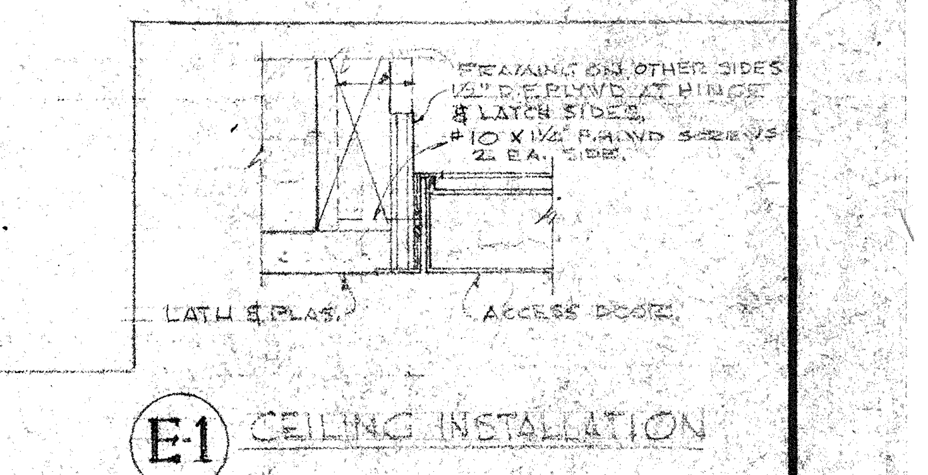

E1 CEILING INSTALLATION

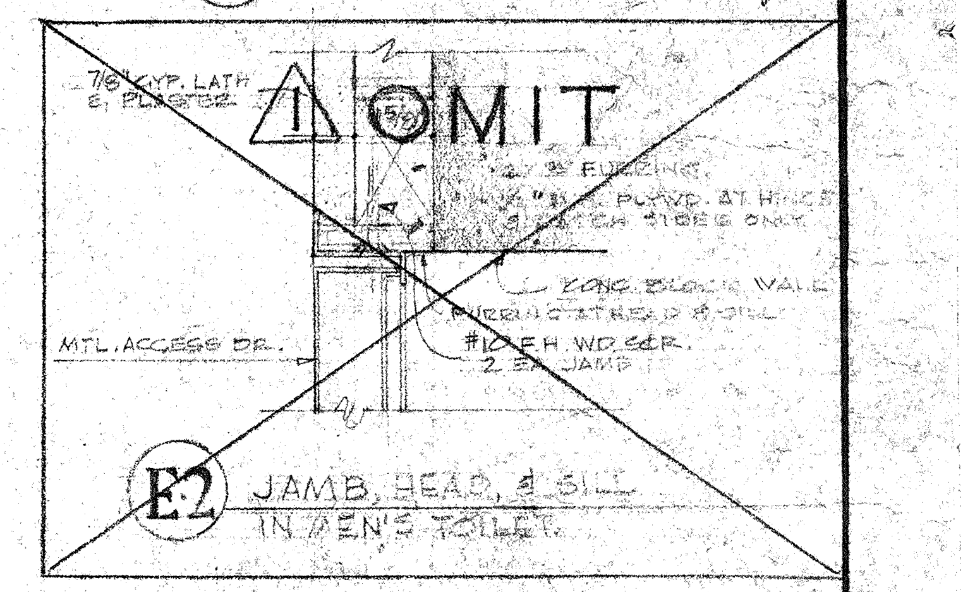

E2 JAMB, HEAD & SILL IN MEN'S TOILET

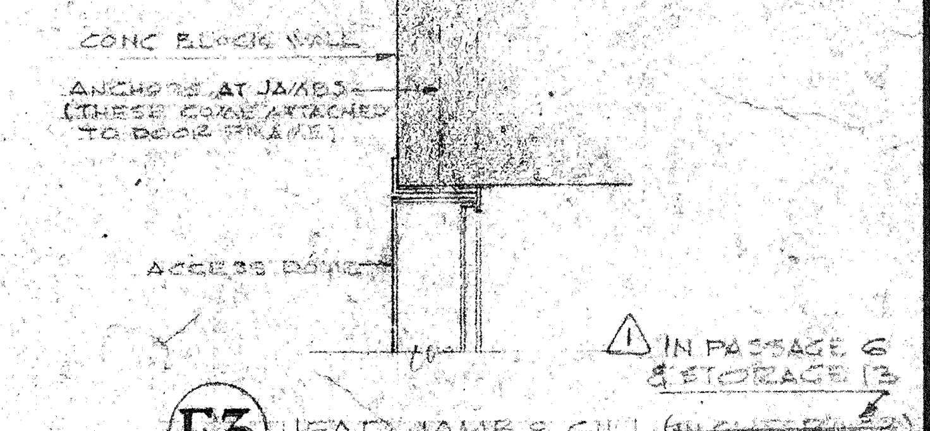

CONC. BLOCK WALL
ANCHORS AT JAMBS (THESE COME ATTACHED TO DOOR FRAME)
ACCESS DOOR
1 IN PASSAGE 6 & STORAGE 13

E3 HEAD, JAMB & SILL

NOTE: ACCESS DOORS TO BE "MILCOR" 2'x2' "B" LABEL, ONE (1) HOUR MINIMUM FIRE ASSEMBLY. 1

E SECTIONS AT ACCESS DOORS
SCALE 3"=1'-0"

BASEMENT PLAN & INTERIOR FINISH SCHEDULE

REVISIONS			
1 3-31-66	PARISH HALL ADDITION for ST. EDMUND'S EPISCOPAL CHURCH 1175 SAN GABRIEL BLVD. SAN MARINO, CALIFORNIA		
	DRAWN BY O.F.S.	BREO FREEMAN ARCHITECT 45 SOUTH MARENGO PASADENA 1, CALIFORNIA	JOB NO. 927
	TRACED BY C.E.G.		SHEET NO. 2 19 OF 16
	DATE 12-30-65		